



- 1) 1/2" CW DOWN IN WALL TO WATER CLOSET.
- (2) 1/2" H & CW DOWN IN WALL TO LAVATORY.
- 3 1/2" H & CW DOWN IN WALL TO BATHTUB/SHOWER. 3/4" H & CW DOWN IN WALL IF SERVING BATHTUB AND SHOWER.
- 4 1/2" H & CW TO SINK AND DISHWASHER. PROVIDE 1/2"x3/8" STOP ON CW. PROVIDE 1/2"x3/8"x3/8" STOP ON HW. 3/8" H & CW TO SINK FAUCET, 3/8" HW TO DISHWASHER.
- DISPOSAL BELOW SINK WITH DISHWASHER WASTE CONNECTION. CONNECT DRAIN THRU AIR GAP TO DISPOSAL. DISPOSAL BY G.C. AND INSTALLED BY PLUMBING CONTRACTOR.
- $\overline{6}$ 1/2" CW DOWN IN WALL TO ICE MAKER VALVE AND BOX.
- $\overline{7}$ WASHING MACHINE CONNECTION BOX 2" WASTE, 1/2" H & CW.
- DOMESTIC WATER RISER. PROVIDE ISOLATION VALVE, REMOTE READ SUB-METER, AND PRV IF REQUIRED. REFER TO RISER DIAGRAM FOR SIZES.
- 9 ELECTRIC WATER HEATER. REFER TO DETAILS AND SCHEDULE.
- $\langle 10 \rangle$ 3" SANITARY WASTE/VENT RISER PER IPC SEC 910.
- (11) 3" SANITARY WASTE RISER.
- (12) 3" SANITARY VENT RISER.



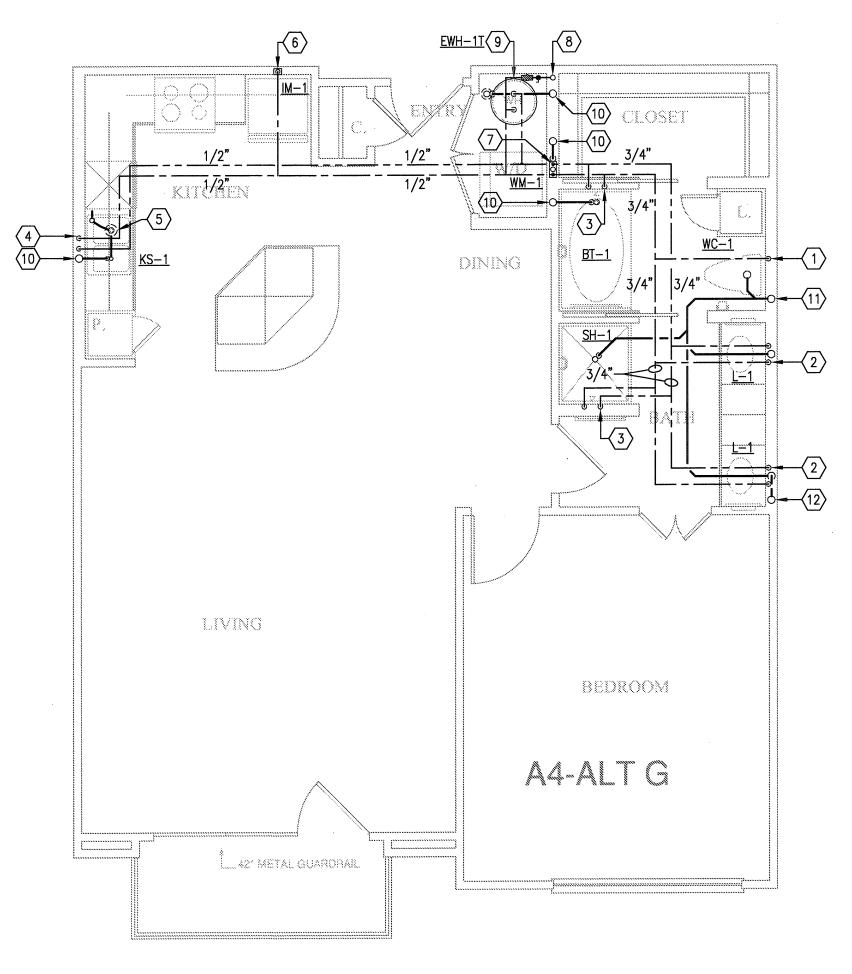

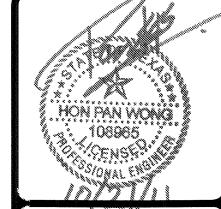

REVISIÔNS

9-2-2011 DESIGN REVISIONS 9-13-2011 ANSI/FHA COMMENTS 3 9-23-2011 DESIGN REVISIONS

4 10-17-2011 CONSTRUCTION ISSUE

R

BGO architects 4144 N. Central Expy. Suite 855 Dallas, TX 75204 214.520.8878 bgoarchitects.com

08-05-1

PROJECT

11129

SHEET NUMBER

P-2.4 Jordan & Skala Engineers 14240 Midway Road, Suite 350 Dallas, FX 73244-5138 V: (469) 383-1616 - E: (469) 385-1615 Texas Firm Registration # F-4990 Checked By: RC