

REVISIONS

9-2-2011	DESIGN REVISIONS
9-13-2011	ANSI/FHA COMMENTS
9-23-2011	DESIGN REVISIONS
10-17-2011	CONSTRUCTION ISSUE

KELLER SPRINGS LOFTS

LOFT APARTMENTS IN ADDISON, TEXAS



4144 N. Central Expy.  
Suite 855  
Dallas, TX 75204  
214.520.8878  
bgoarchitects.com


DATE  
08-05-11

PROJECT  
11129

SHEET NUMBER  
**P-3.0A**




Jordan & Skala Engineers  
14225 Midway Road, Suite 350  
Dallas, TX 75244-5138  
V: (469) 385-1616 F: (469) 385-1615  
Project Number - 113-0355 Texas Firm Registration # F-4990  
Drawn By: CV Checked By: RC

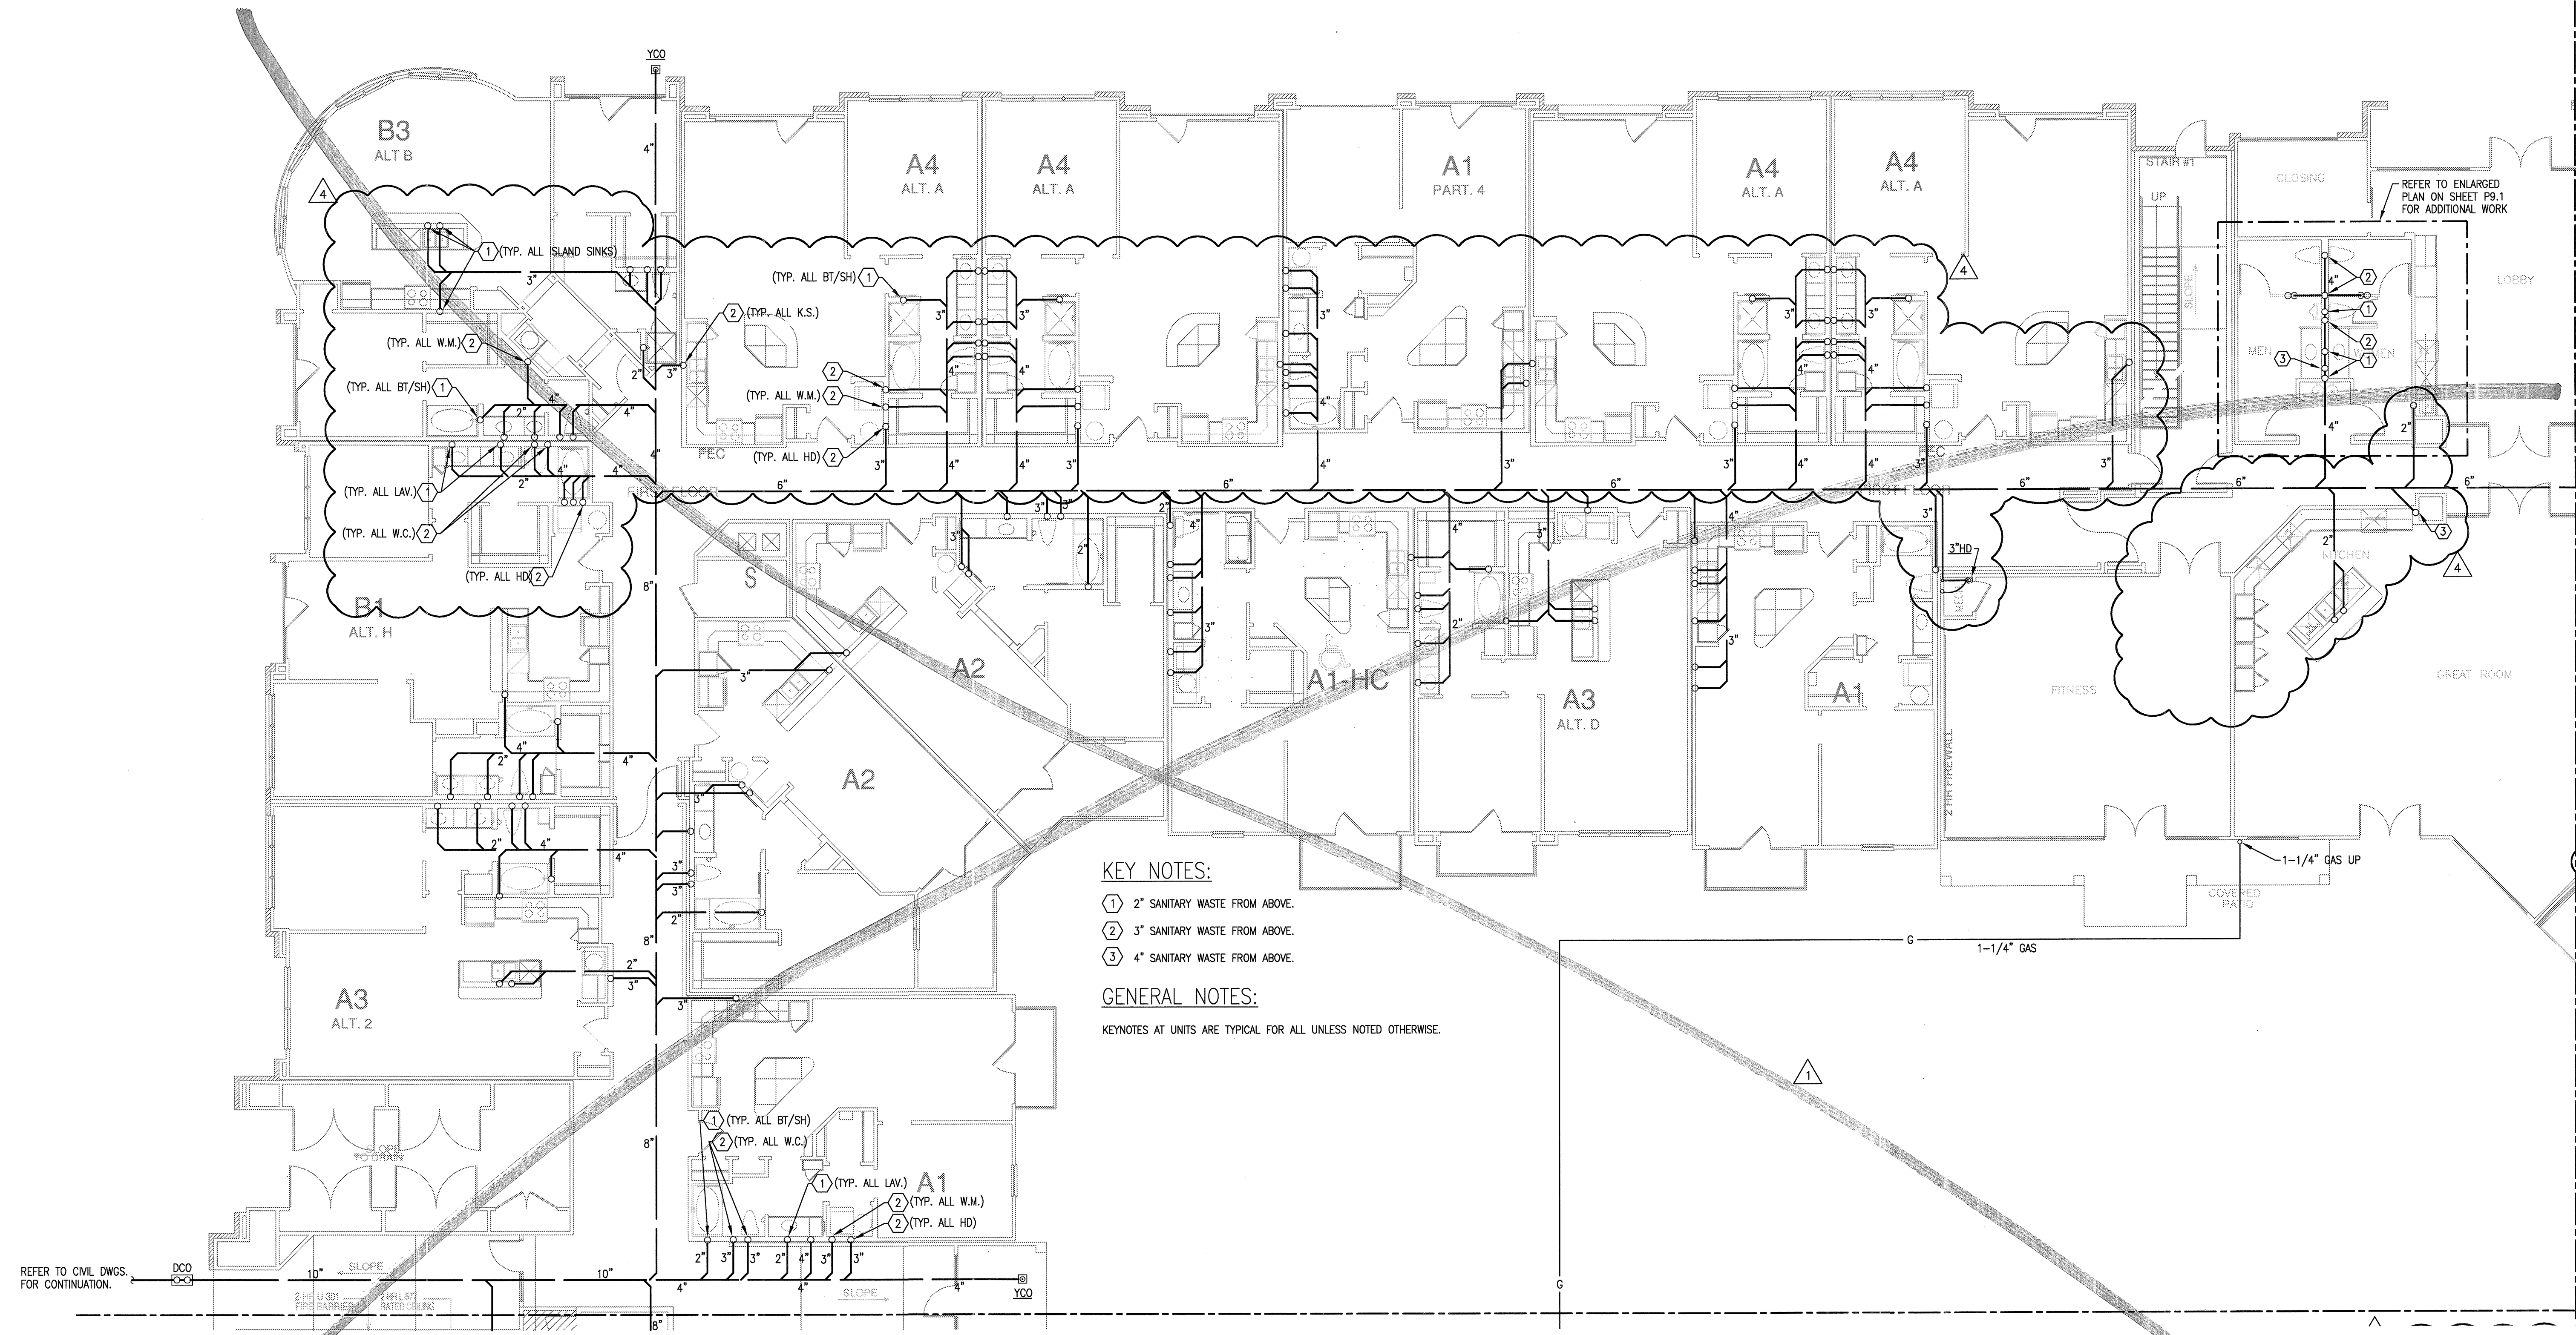

**KEY NOTES:**  
 ① 2" SANITARY WASTE FROM ABOVE.  
 ② 3" SANITARY WASTE FROM ABOVE.  
 ③ 4" SANITARY WASTE FROM ABOVE.

**GENERAL NOTES:**  
 KEYNOTES AT UNITS ARE TYPICAL FOR ALL UNLESS NOTED OTHERWISE.

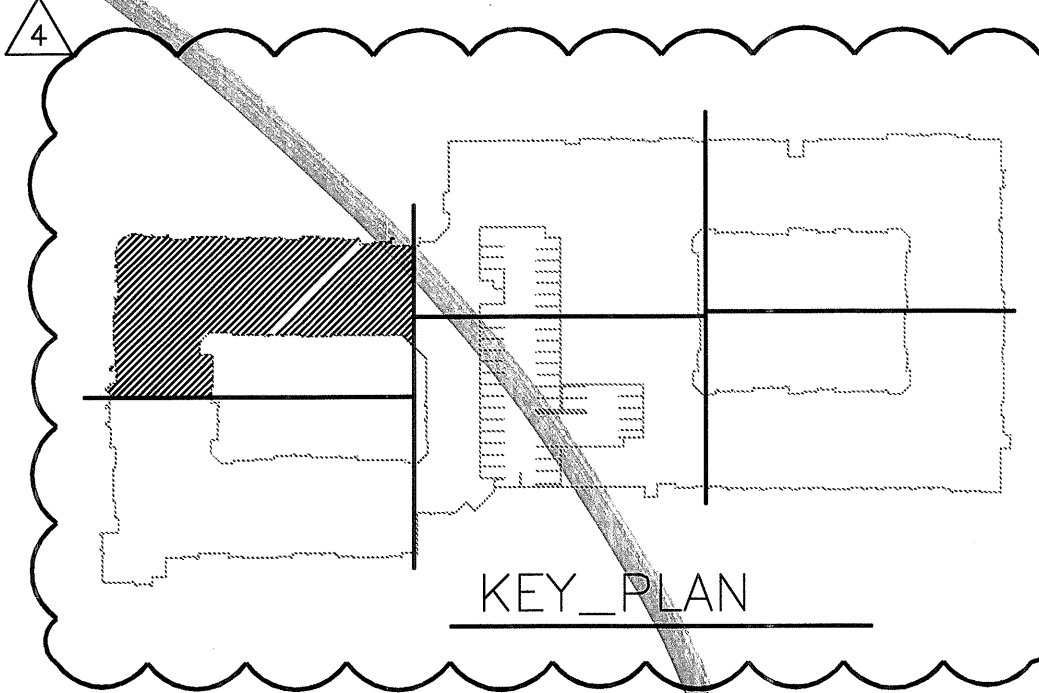

1 DIVISION 'A' UNDERFLOOR PLAN  
 SCALE: 1/8" = 1'-0"

REFER TO CIVIL DWGS.  
 FOR CONTINUATION.

REFER TO ENLARGED  
 PLAN ON SHEET P9.1  
 FOR ADDITIONAL WORK