


REVISIONS		
1	9-2-2011	DESIGN REVISIONS
2	9-13-2011	ANSI/FHA COMMENTS
3	9-23-2011	DESIGN REVISIONS
4	10-17-2011	CONSTRUCTION ISSUE
5	12-21-2011	DESIGN REVISIONS

KELLER SPRINGS LOFTS

LOFT APARTMENTS IN ADDISON, TEXAS

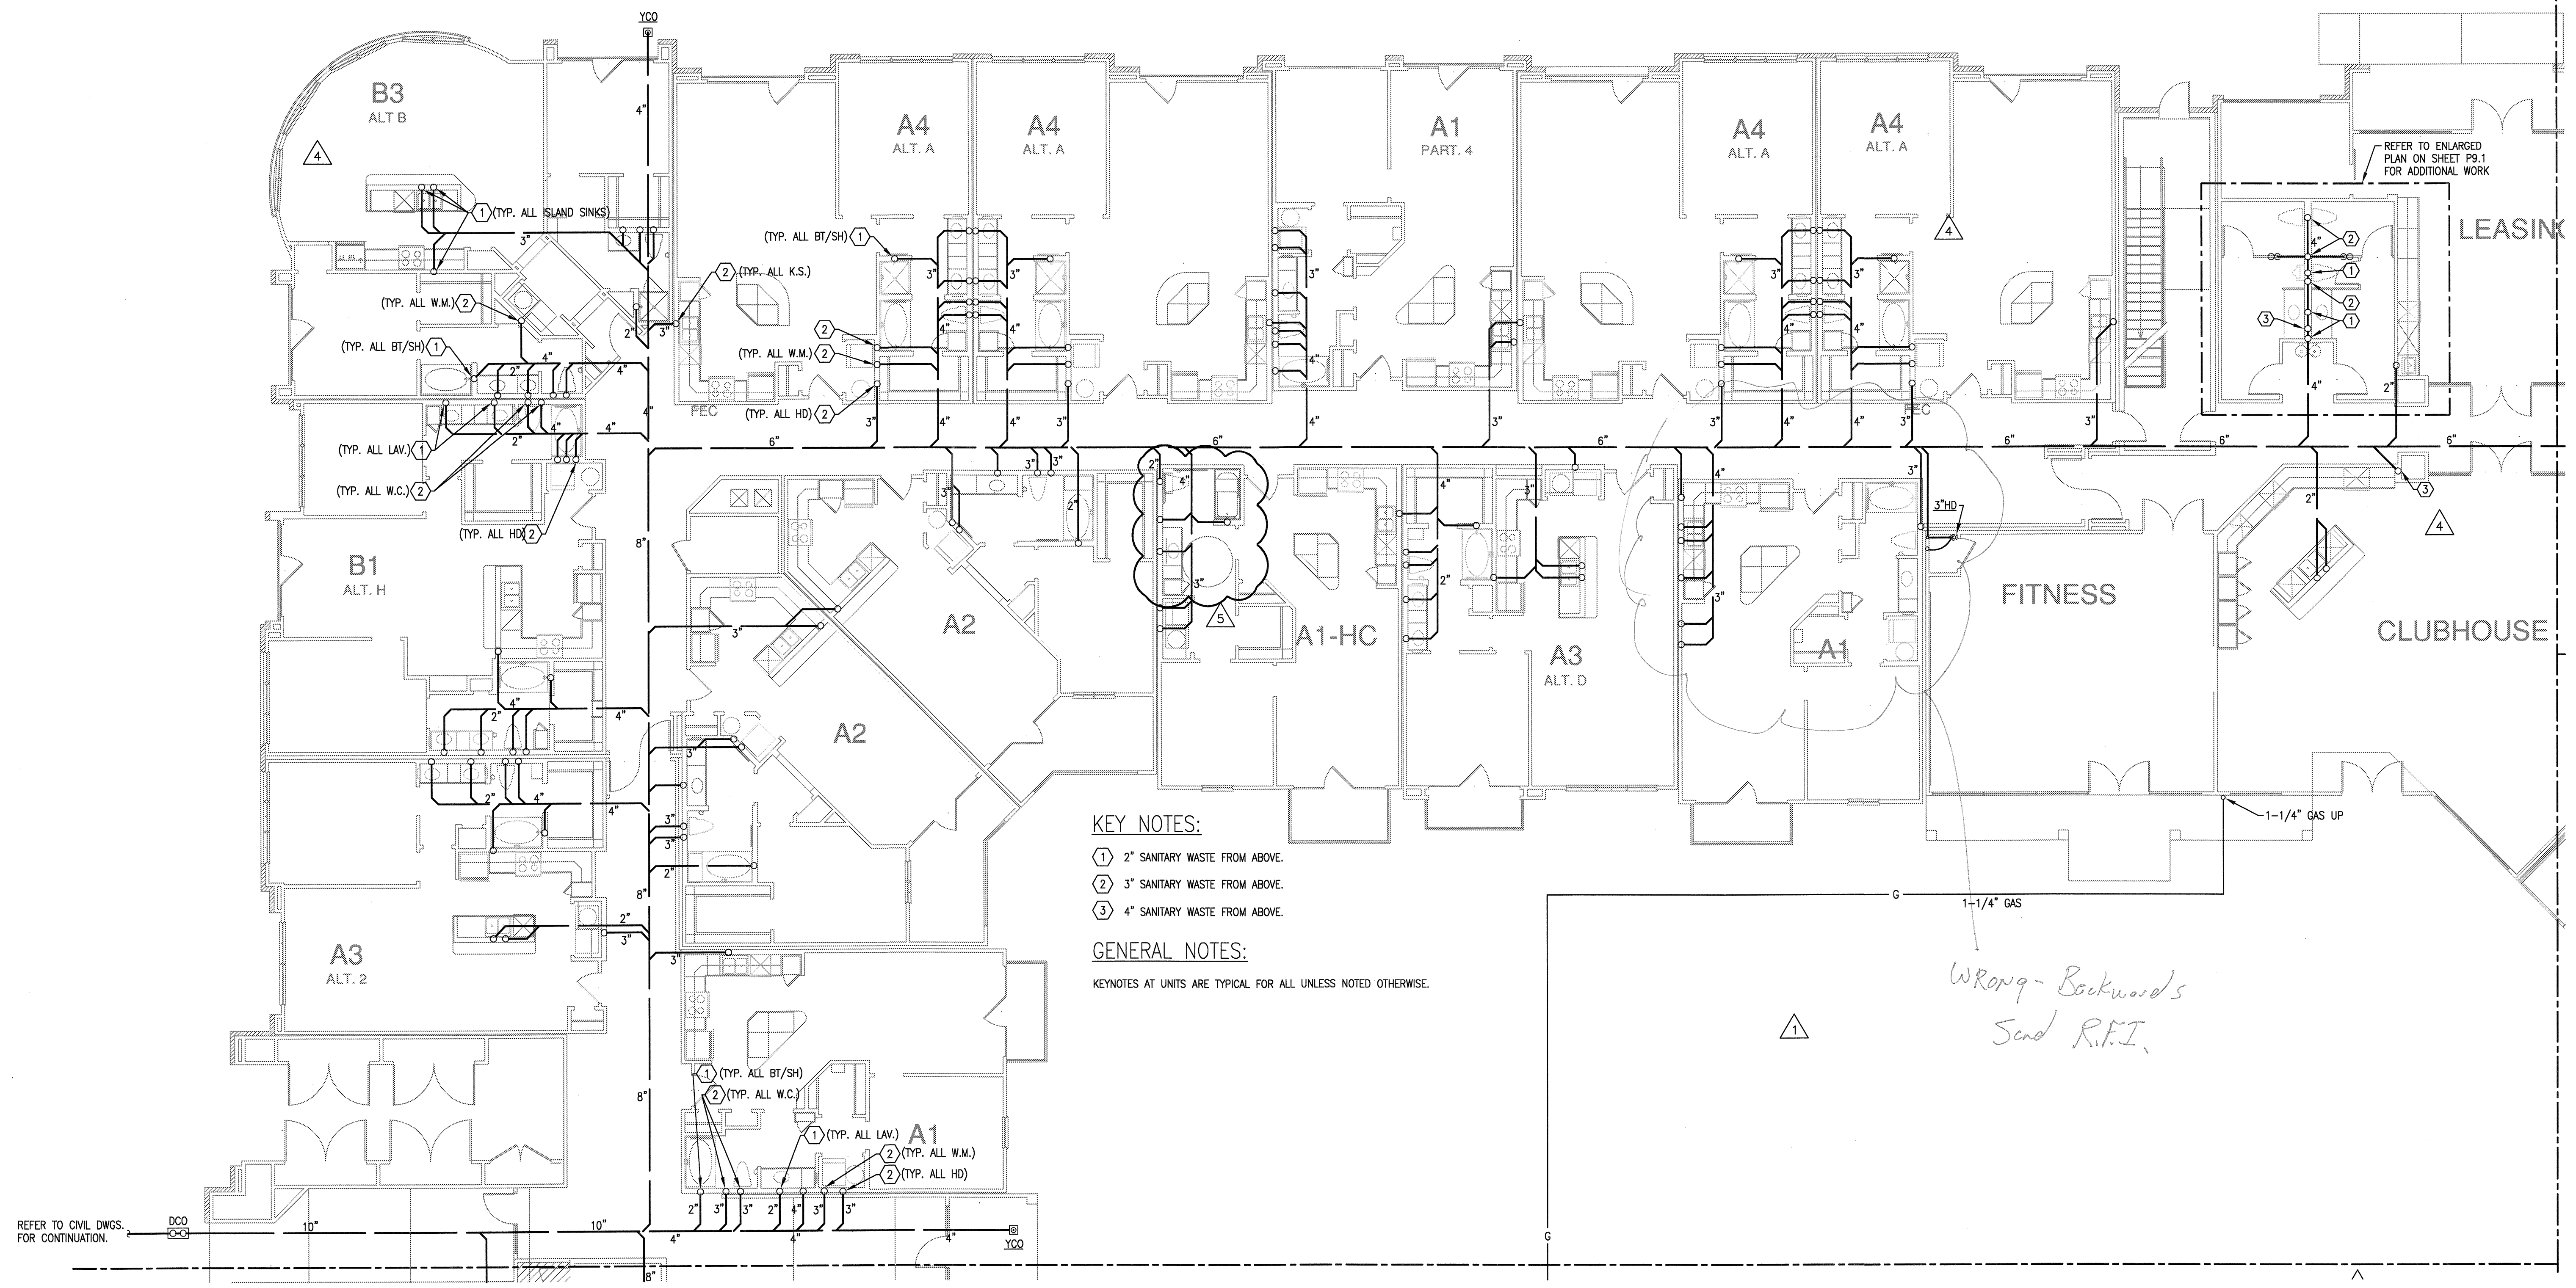

KEY NOTES:


- 1 2" SANITARY WASTE FROM ABOVE.
- 2 3" SANITARY WASTE FROM ABOVE.
- 3 4" SANITARY WASTE FROM ABOVE.

GENERAL NOTES:

KEYNOTES AT UNITS ARE TYPICAL FOR ALL UNLESS NOTED OTHERWISE.

Wrong - Backward's Sand R.I.T.

REFER TO CIVIL DWGS. FOR CONTINUATION.

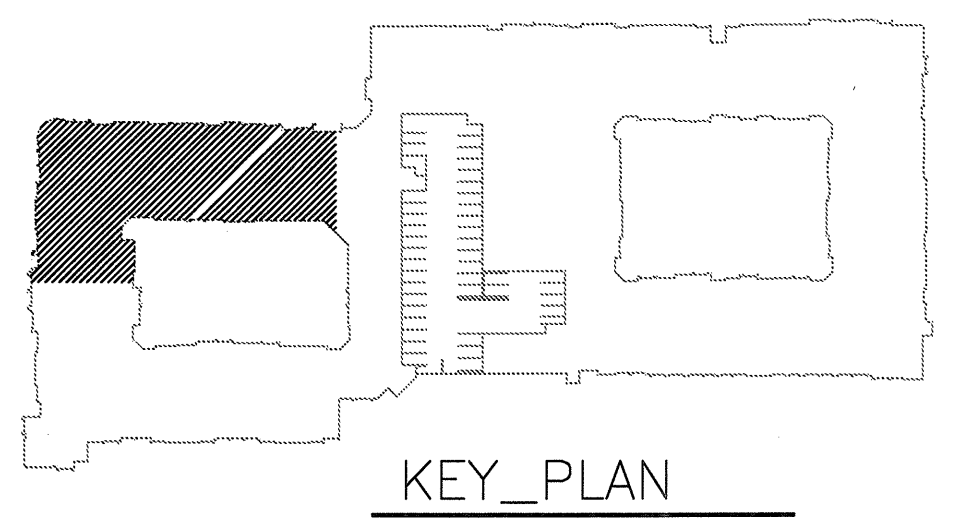

1 DIVISION 'A' UNDERFLOOR PLAN
SCALE: 1/8" = 1'-0"

USE Jordan & Skala Engineers
 14240 Midway Road, Suite 350
 Dallas, TX 75244-5138
 V: (469) 383-1616, F: (469) 383-1615
 Project Number - 113-0355 Texas Firm Registration # F-4990
 Drawn By: CV Checked By: BC

BGO architects
 4144 N. Central Expy.
 Suite 855
 Dallas, TX 75204
 214-520-8878
 bgoarchitects.com

DATE	08-05-11
PROJECT	11129
SHEET NUMBER	

P-3.0A