

KEY NOTES:

- ① 2" SANITARY WASTE FROM ABOVE.
- ② 3" SANITARY WASTE FROM ABOVE.
- ③ 4" SANITARY WASTE FROM ABOVE.

GENERAL NOTES:


KEYNOTES AT UNITS ARE TYPICAL FOR ALL UNLESS NOTED OTHERWISE.

COURTYARD

1-1/4" GAS

1" CW SERVING COURTYARD EQUIPMENT (BACKFLOW PREVENTER & YARD BOX BY OTHERS.)

1-1/4" GAS STUB OUT TO PROVIDE 100 CFH TO SERVE FIREPIT. COORDINATE LOCATION WITH LANDSCAPE DWGS.

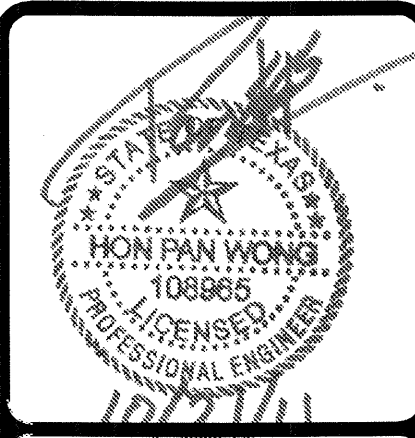

REVISIONS

NO.	DATE	DESCRIPTION
1	9-2-2011	DESIGN REVISIONS
2	9-13-2011	ANSI/FHA COMMENTS
3	9-23-2011	DESIGN REVISIONS
4	10-17-2011	CONSTRUCTION ISSUE

KELLER SPRINGS LOFTS
LOFT APARTMENTS IN ADDISON, TEXAS




4144 N. Central Expy.
Suite 855
Dallas, TX 75204
214.520.8878
bgoarchitects.com

DATE
08-05-11

PROJECT
11129

SHEET NUMBER

P-3.0B

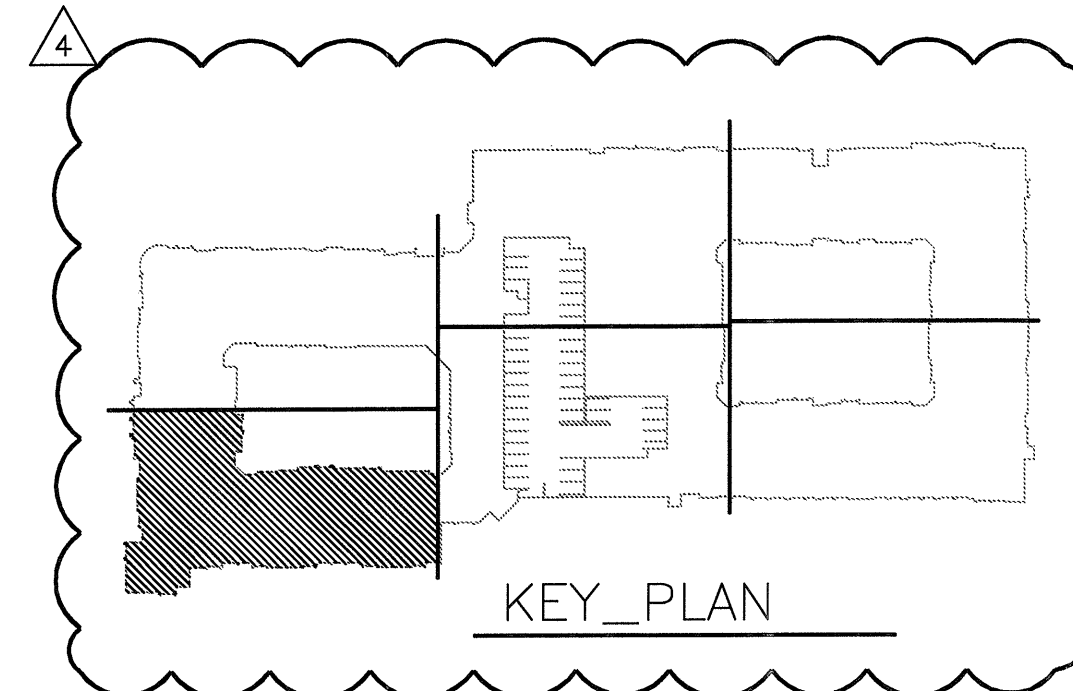

1 DIVISION 'B' UNDERFLOOR PLAN
SCALE: 1/8" = 1'-0"

JSE Jordan & Skala Engineers
14240 Midway Road, Suite 310
Dallas, TX 75244-5138
P: (469) 385-1616 F: (469) 385-1615
Project Number - 113-0355 Texas Firm Registration # F-4990
Drawn By: CV Checked By: RC