

REVISIONS	
①	9-2-2011 DESIGN REVISIONS
②	9-13-2011 ANSI/FHA COMMENTS
③	9-23-2011 DESIGN REVISIONS
④	10-17-2011 CONSTRUCTION ISSUE
⑤	12-21-2011 DESIGN REVISIONS

KELLER SPRINGS LOFTS
 LOFT APARTMENTS IN ADDISON, TEXAS

BGO architects
 4144 N. Central Expy.
 Suite 855
 Dallas, TX 75204
 214.520.8878
 bg architects.com


DATE
 08-05-11

PROJECT
 11129

SHEET NUMBER


P-3.0C

JSE Jordan & Skala Engineers
 14240 Midway Road, Suite 330
 Dallas, TX 75244-5138
 V: (469) 385-1616 F: (469) 385-1615
 Project Number - 113-0355 Texas Firm Registration # F-4990
 Drawn By: CV Checked By: RC

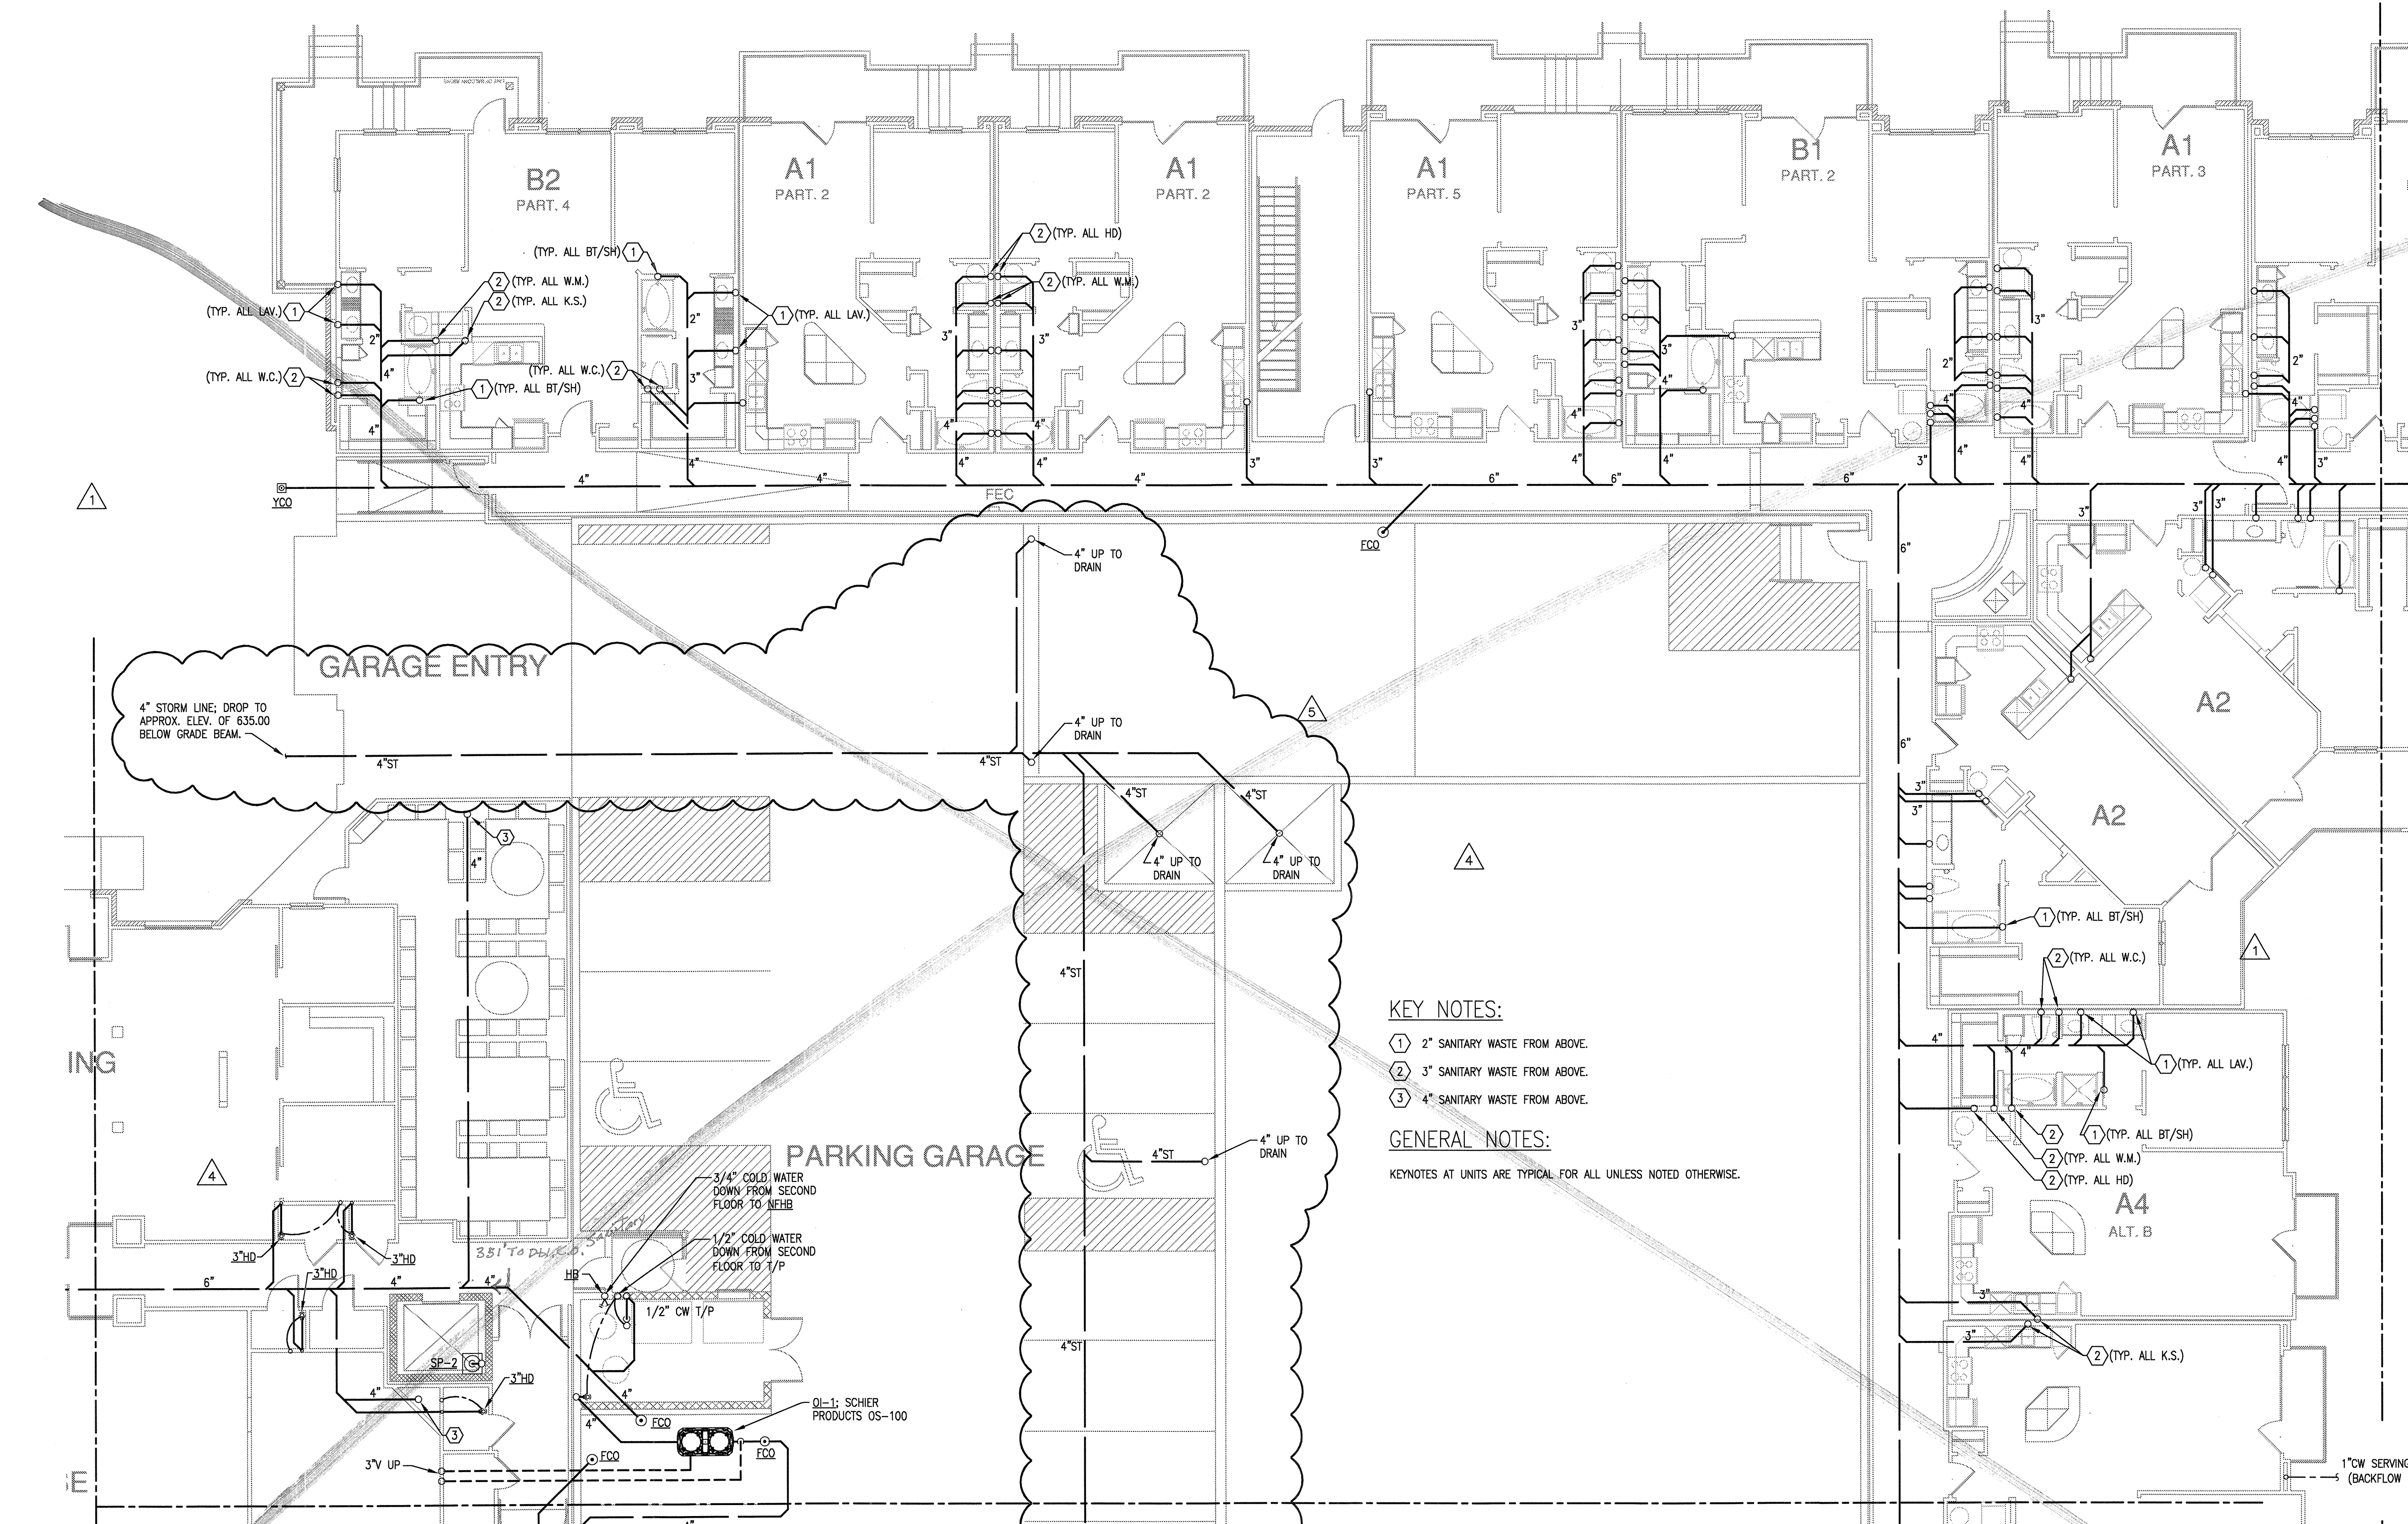

KEY NOTES:
 ① 2" SANITARY WASTE FROM ABOVE.
 ② 3" SANITARY WASTE FROM ABOVE.
 ③ 4" SANITARY WASTE FROM ABOVE.

GENERAL NOTES:
 KEYNOTES AT UNITS ARE TYPICAL FOR ALL UNLESS NOTED OTHERWISE.

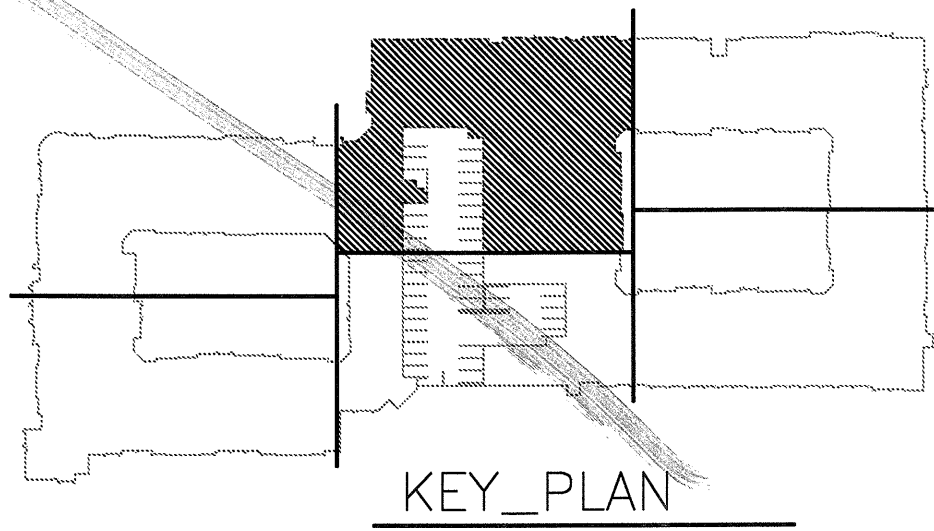

1 DIVISION 'C' UNDERFLOOR PLAN
 SCALE: 1/8" = 1'-0"