

REVISIONS		
1	9-2-2011	DESIGN REVISIONS
2	9-13-2011	ANSI/FHA COMMENTS
3	9-23-2011	DESIGN REVISIONS
4	10-17-2011	CONSTRUCTION ISSUE
5	12-21-2011	DESIGN REVISIONS

# KELLER SPRINGS LOFTS

LOFT APARTMENTS IN ADDISON, TEXAS


**BGO**  
architects  
4144 N. Central Expy.  
Suite 855  
Dallas, TX 75204  
214.520.8878  
bgoarchitects.com

DATE  
08-05-11

PROJECT  
11129


SHEET NUMBER

**P-3.0D**

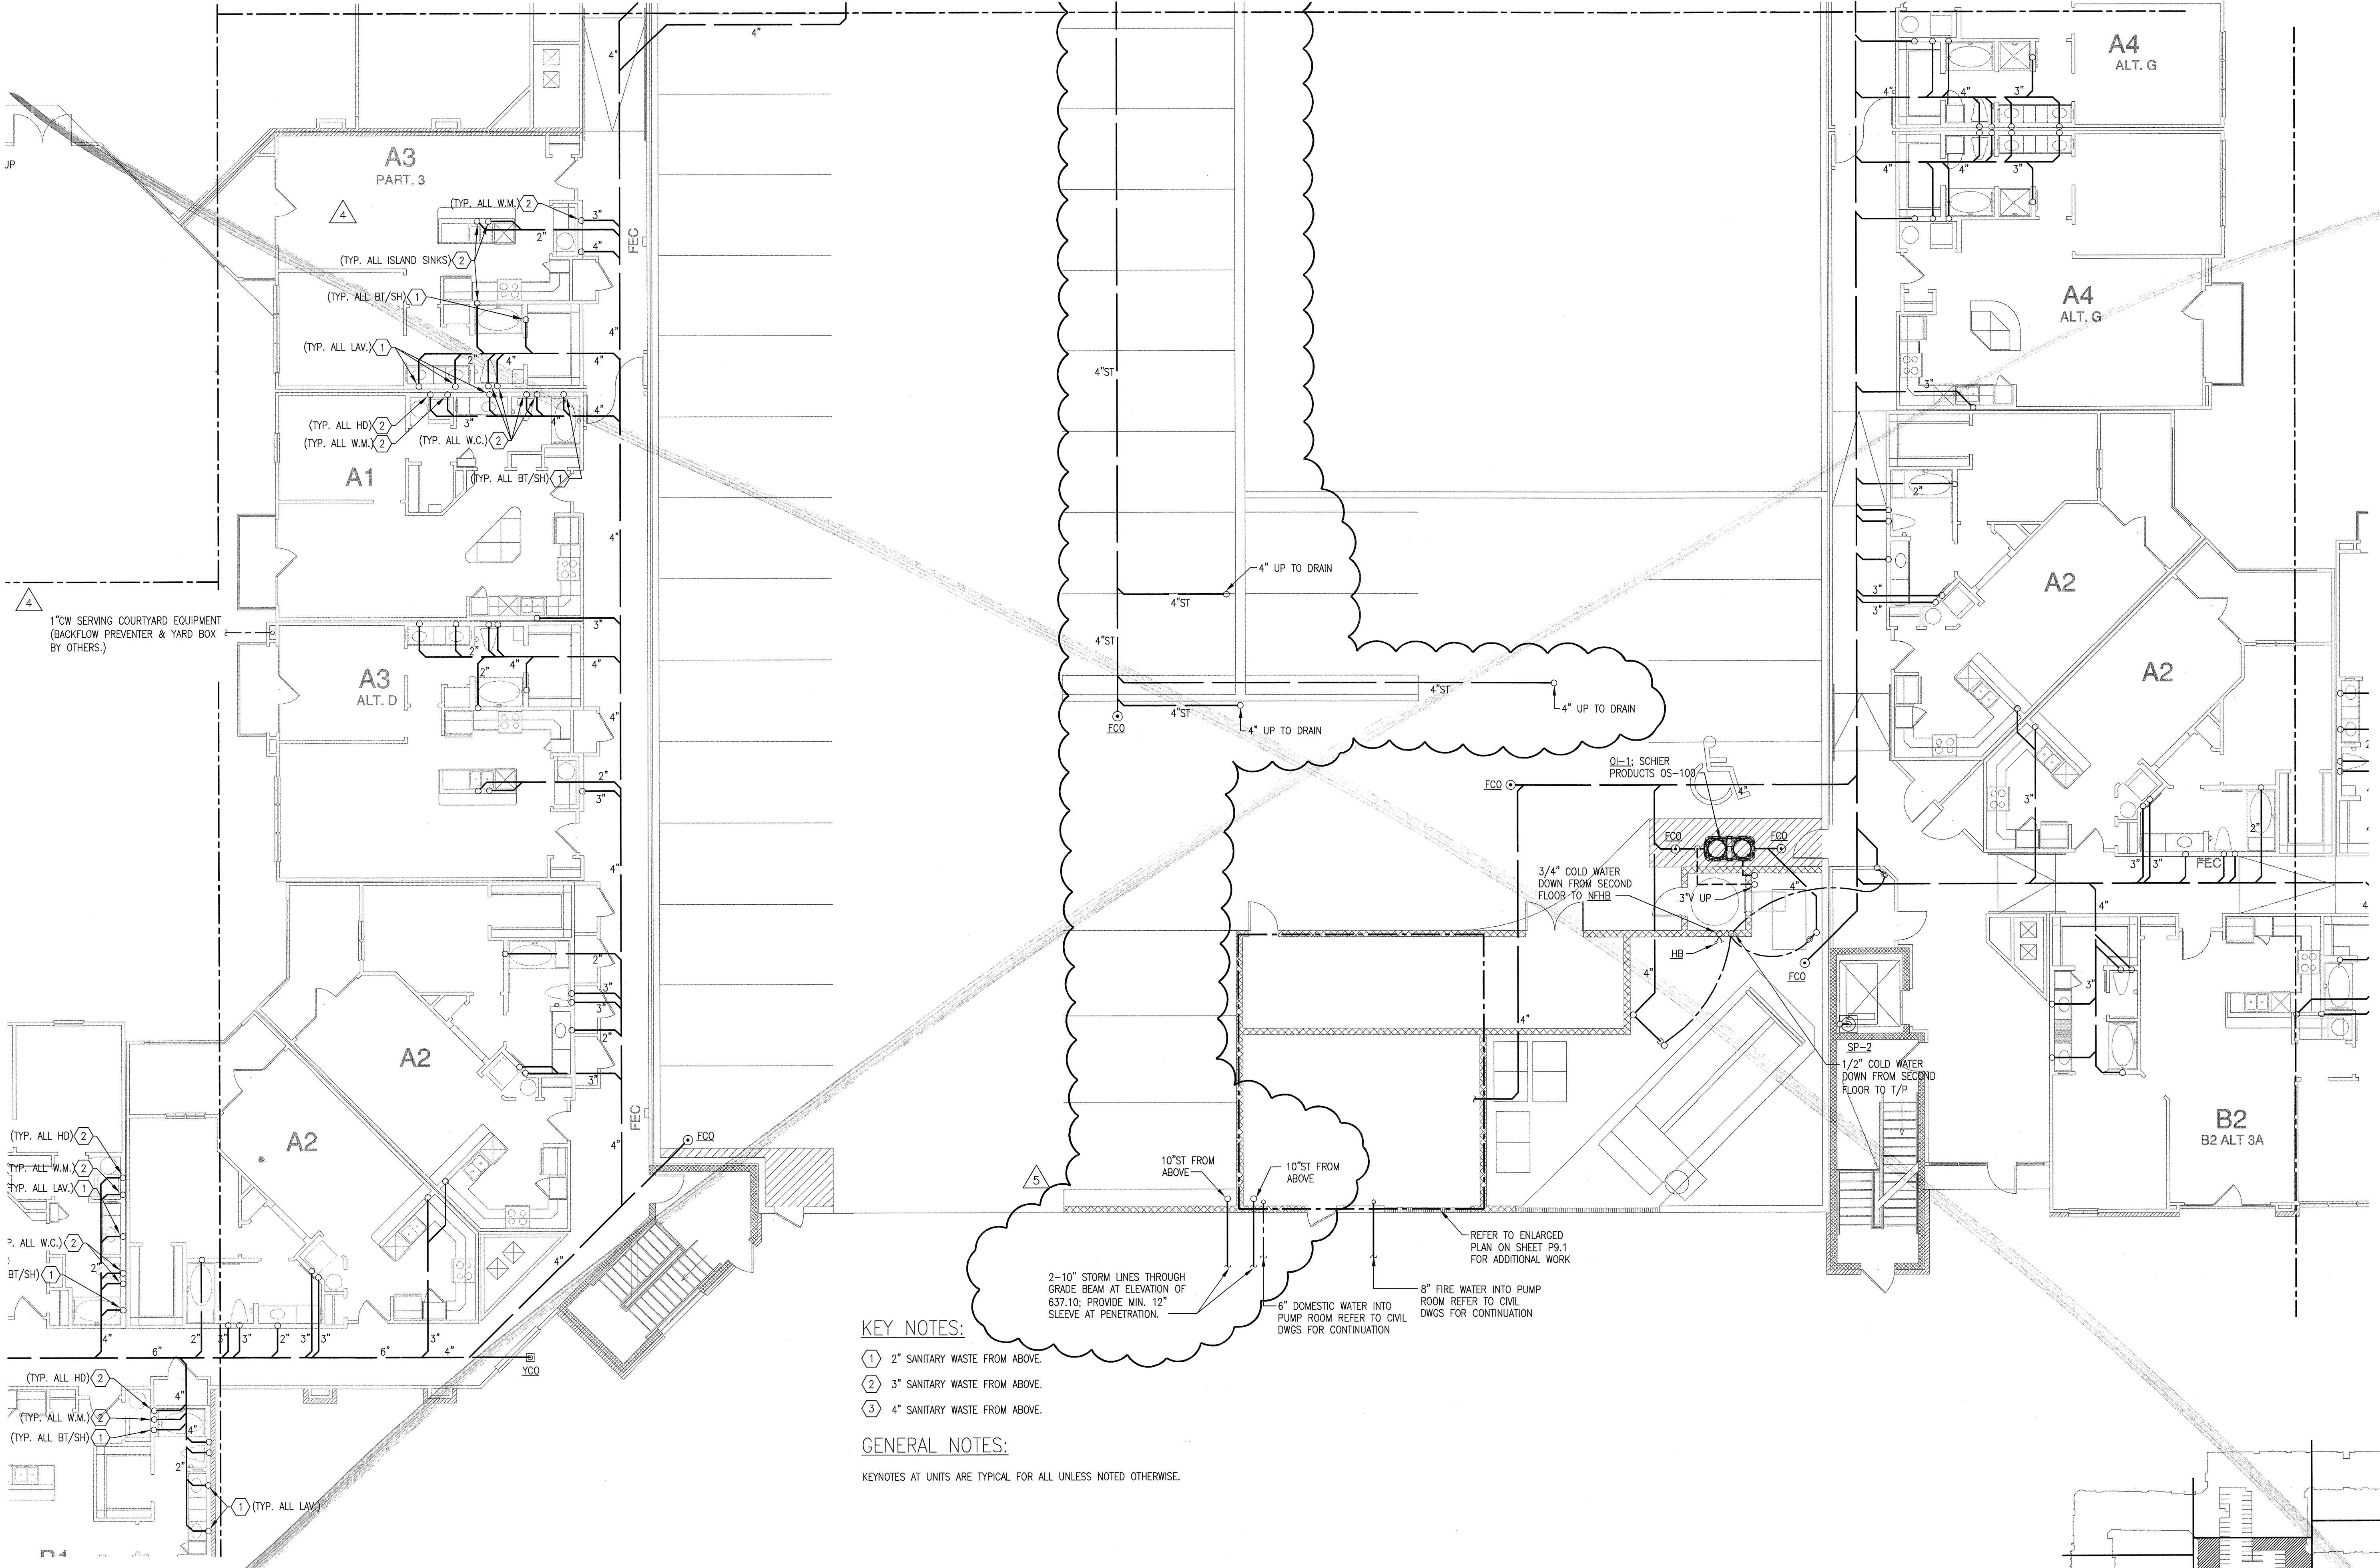

- KEY NOTES:**
- 1 2" SANITARY WASTE FROM ABOVE.
  - 2 3" SANITARY WASTE FROM ABOVE.
  - 3 4" SANITARY WASTE FROM ABOVE.

**GENERAL NOTES:**  
KEYNOTES AT UNITS ARE TYPICAL FOR ALL UNLESS NOTED OTHERWISE.

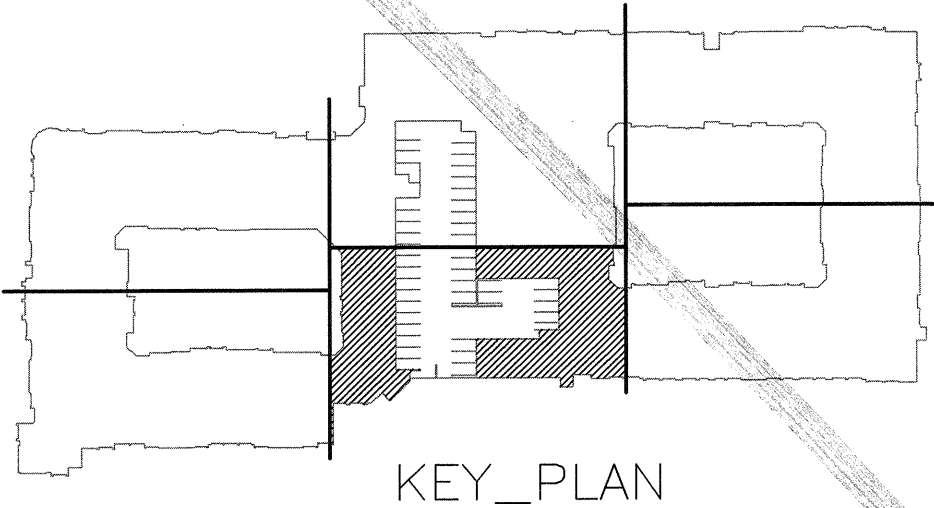

KEY\_PLAN

1 DIVISION 'D' UNDERFLOOR PLAN  
SCALE: 1/8" = 1'-0"

**JSE** Jordan & Skala Engineers  
14510 Midway Road, Suite 379  
Dallas, TX 75244-5138  
v: (469) 385-1616 f: (469) 385-1615  
Project Number - 113-0355 Texas Firm Registration # F-4990  
Drawn By: CV Checked By: RC