


1" CW SERVING COURTYARD EQUIPMENT
(BACKFLOW PREVENTER & YARD BOX
BY OTHERS.)


- KEY NOTES:**
- ① 2" SANITARY WASTE FROM ABOVE.
 - ② 3" SANITARY WASTE FROM ABOVE.
 - ③ 4" SANITARY WASTE FROM ABOVE.

GENERAL NOTES:
KEYNOTES AT UNITS ARE TYPICAL FOR ALL UNLESS NOTED OTHERWISE.

1 DIVISION 'D' UNDERFLOOR PLAN
SCALE: 1/8" = 1'-0"

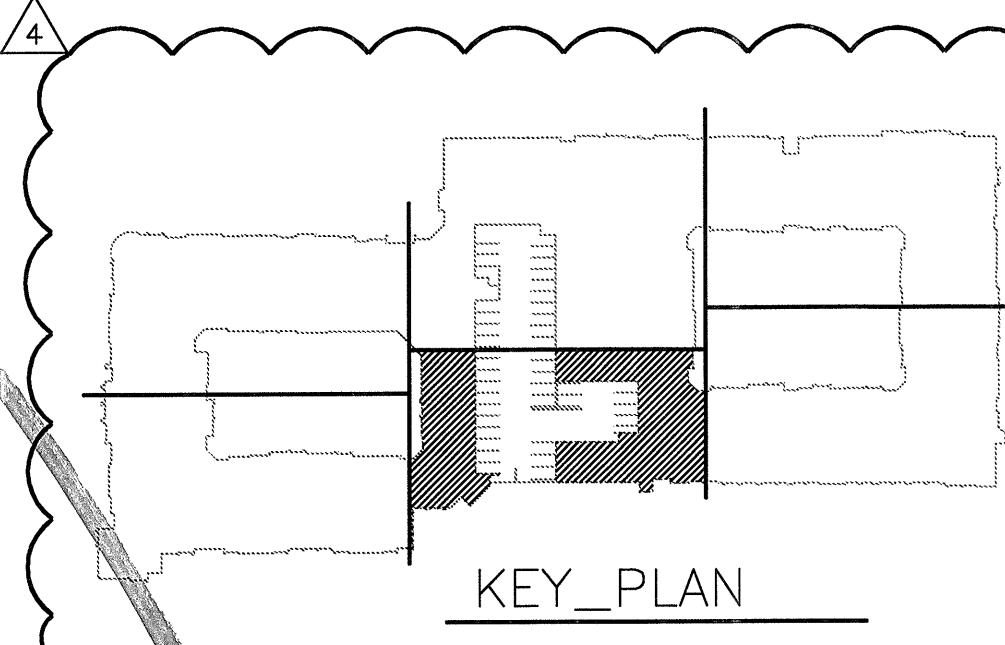

JSE Jordan & Skala Engineers
14240 Midway Road, Suite 350
Dallas, TX 75244
P: (972) 385-1616 F: (972) 385-1615
Project Number - 113-0355 Texas Firm Registration # F-4990
Drawn By: CV Checked By: RC

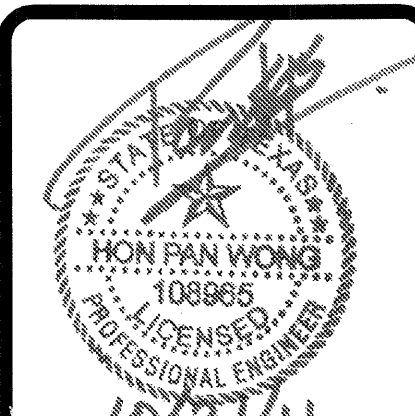

REVISIONS

①	9-2-2011	DESIGN REVISIONS
②	9-13-2011	ANSI/FHA COMMENTS
③	9-23-2011	DESIGN REVISIONS
④	10-17-2011	CONSTRUCTION ISSUE

KELLER SPRINGS LOFTS
LOFT APARTMENTS IN ADDISON, TEXAS

BGO architects
4144 N. Central Expy.
Suite 855
Dallas, TX 75204
214.520.8878
bgoarchitects.com

DATE
08-05-11

PROJECT
11129

SHEET NUMBER

P-3.0D