

1/2 SERVING COURTYARD EQUIPMENT (BACKFLOW PREVENTER & YARD BOX BY OTHERS.)




POOL AND AMENITY

KEY NOTES:

- ① 2" SANITARY WASTE FROM ABOVE.
- ② 3" SANITARY WASTE FROM ABOVE.
- ③ 4" SANITARY WASTE FROM ABOVE.

GENERAL NOTES:

KEYNOTES AT UNITS ARE TYPICAL FOR ALL UNLESS NOTED OTHERWISE.

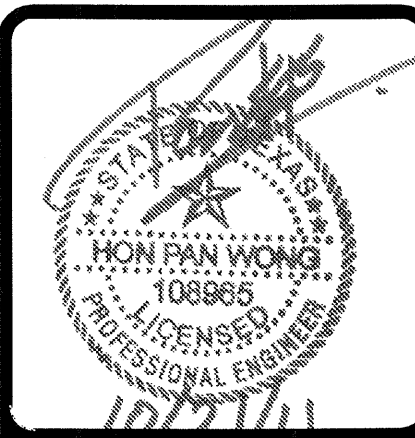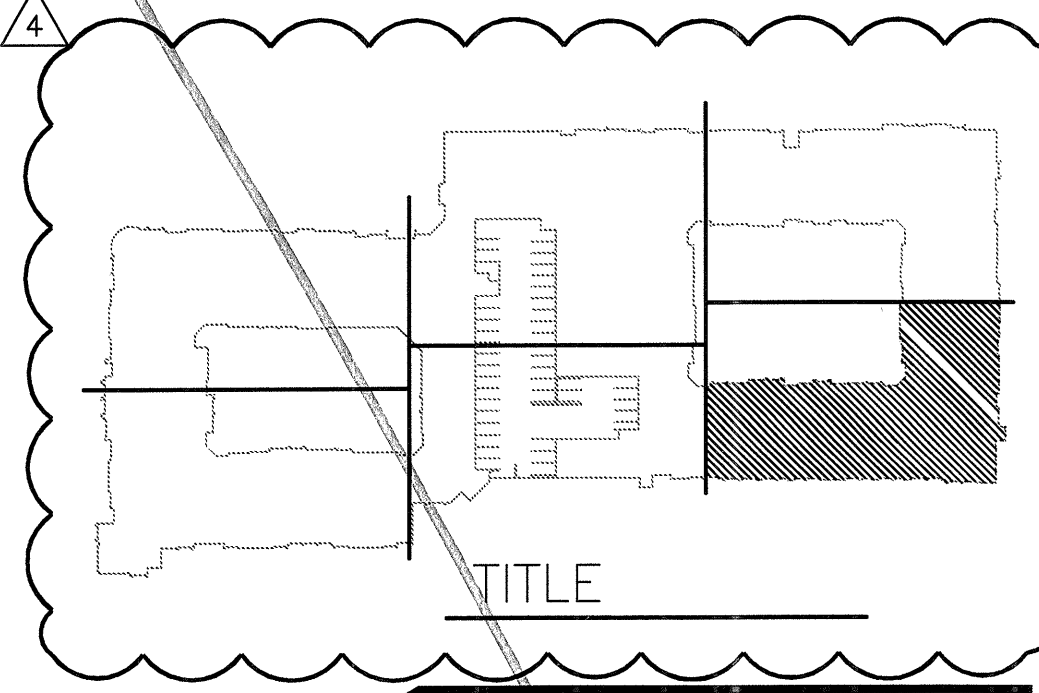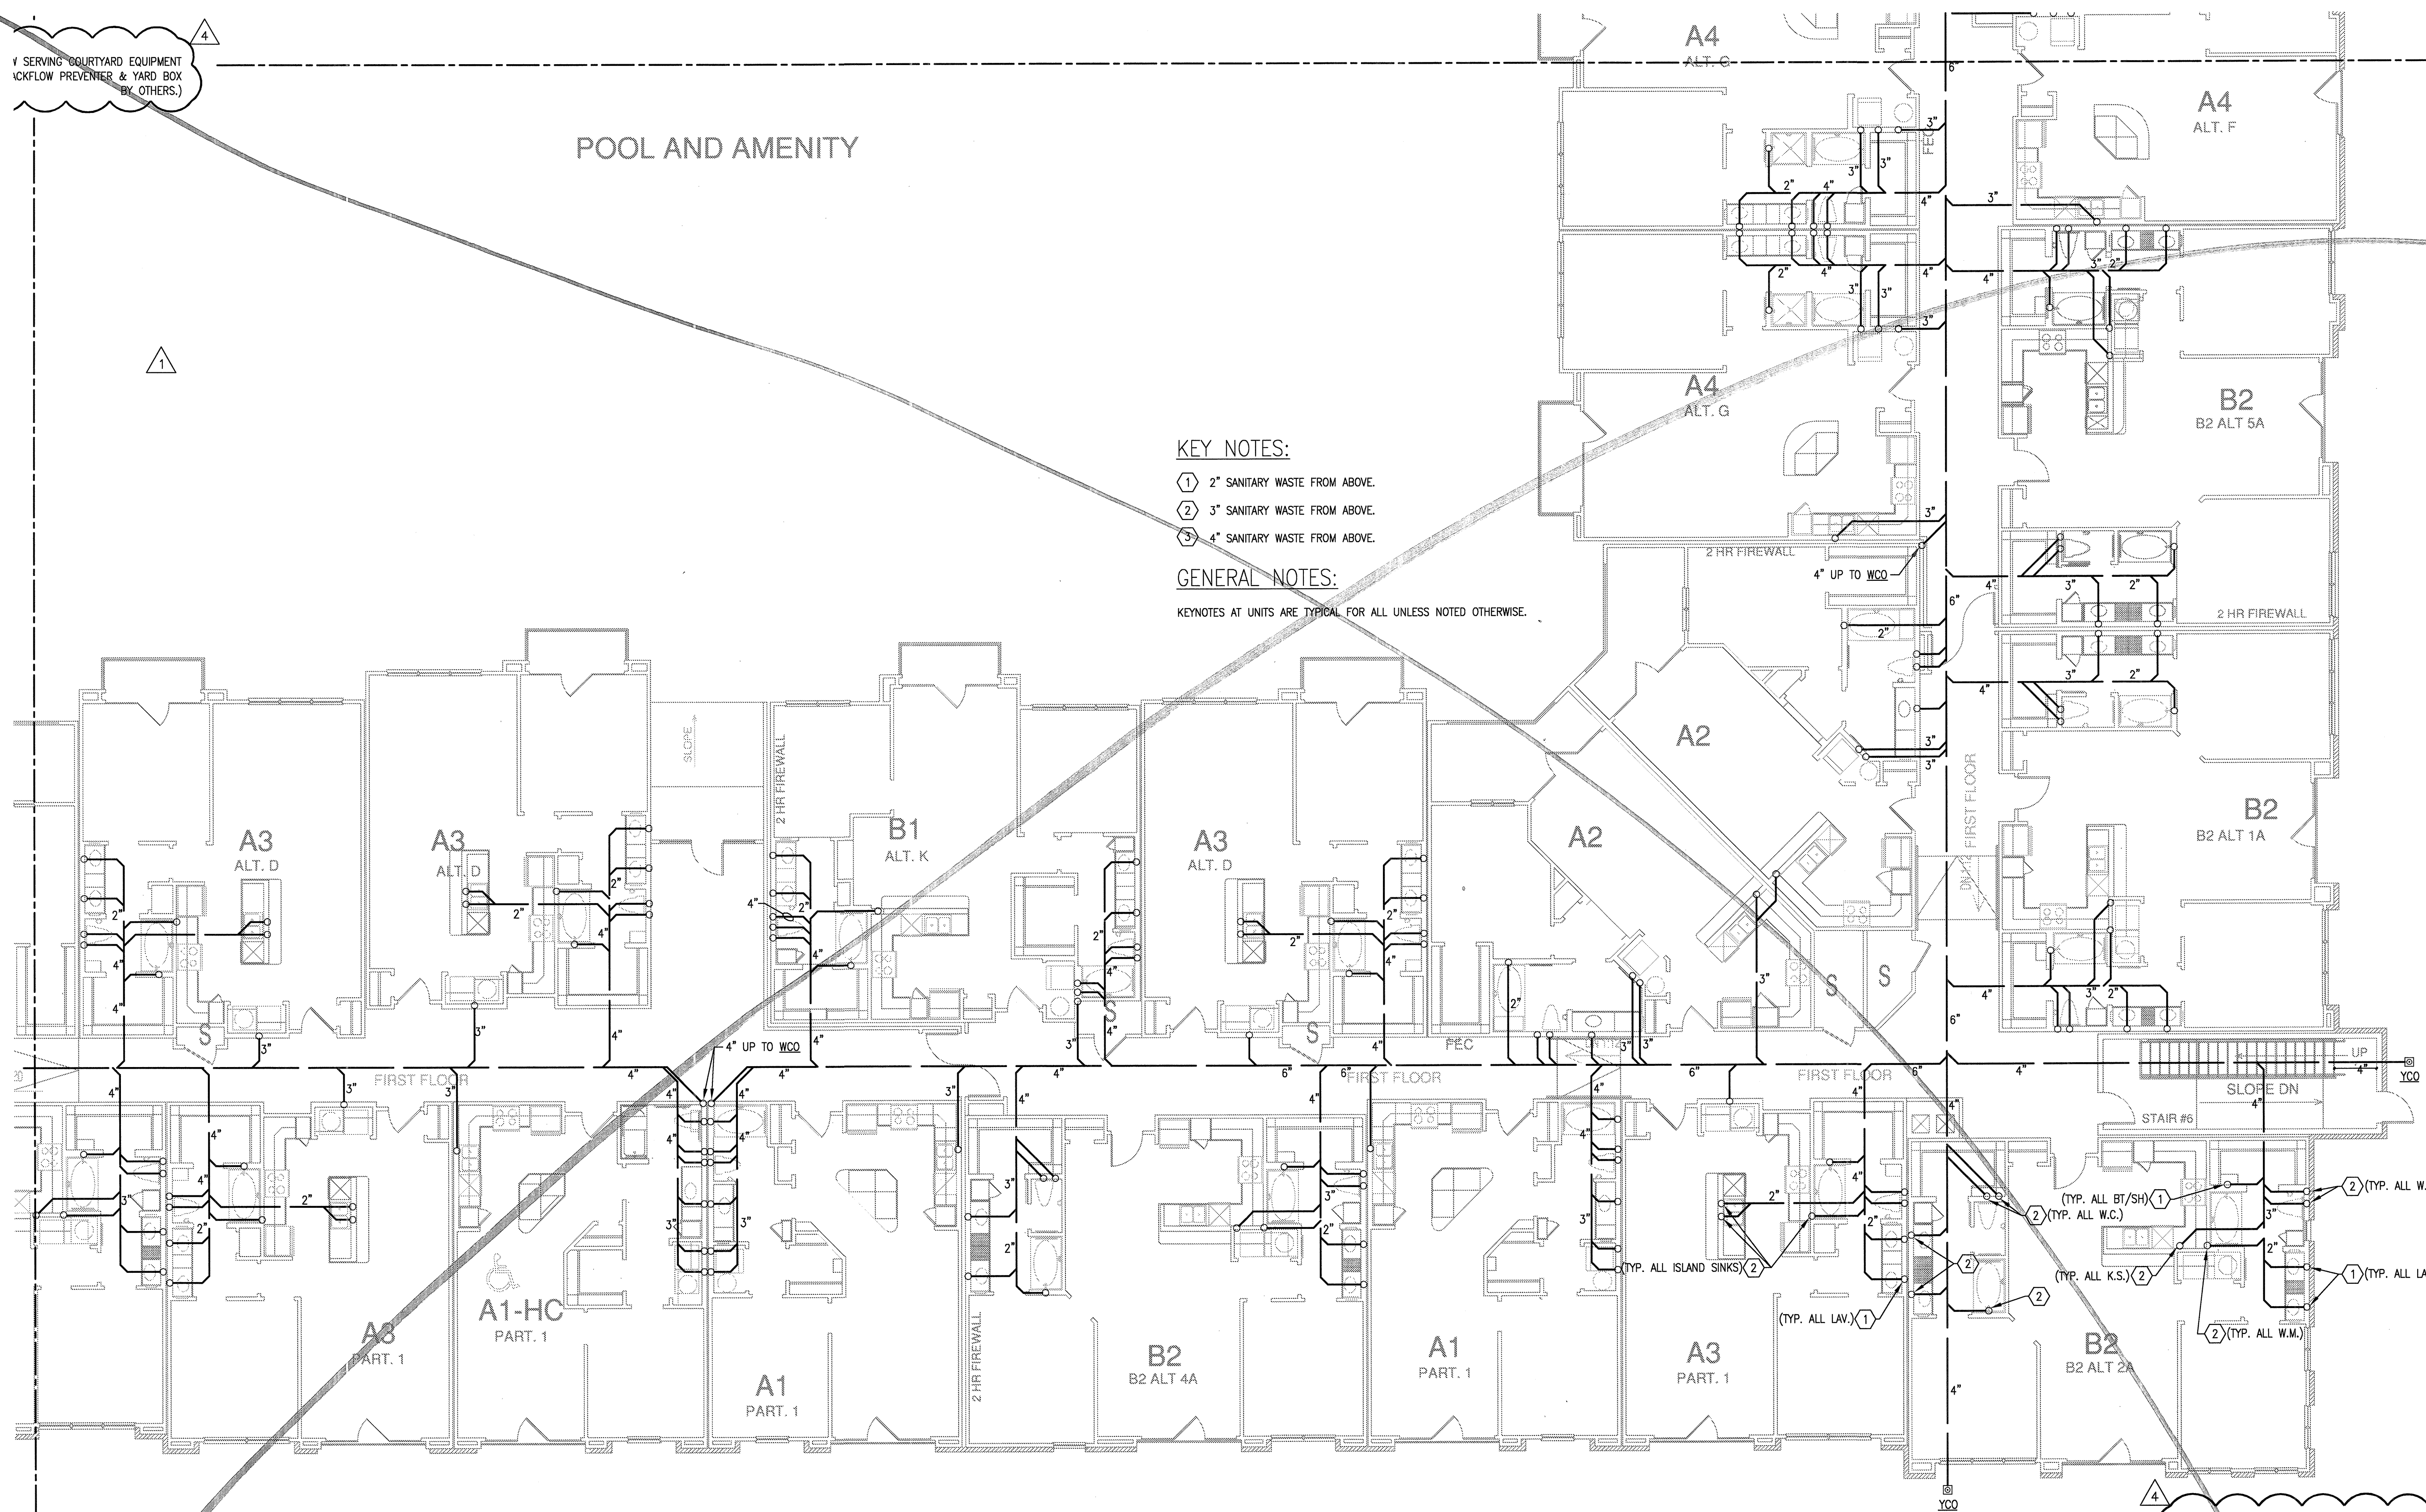

REVISIONS		
①	9-2-2011	DESIGN REVISIONS
②	9-13-2011	ANSI/FHA COMMENTS
③	9-23-2011	DESIGN REVISIONS
④	10-17-2011	CONSTRUCTION ISSUE

**KELLER SPRINGS LOFTS**  
 LOFT APARTMENTS IN ADDISON, TEXAS



4144 N. Central Expy.  
 Suite 855  
 Dallas, TX 75204  
 214.520.8878  
 bgearchitects.com

DATE  
 08-05-11

PROJECT  
 11129

SHEET NUMBER

**P-3.OF**

1 DIVISION 'F' UNDERFLOOR PLAN  
 SCALE: 1/8" = 1'-0"

**JSE** Jordan & Skala Engineers  
 14240 Midway Road, Suite 350  
 Dallas, TX 75244-5139  
 V: (646) 385-1616 F: (646) 385-1615  
 Project Number - 113-0355 Texas Firm Registration # F-4990  
 Drawn By: CV Checked By: RC