


1 SERVING COURTYARD EQUIPMENT
 2 BACKFLOW PREVENTER & YARD BOX
 3 BY OTHERS.)

POOL AND AMENITY

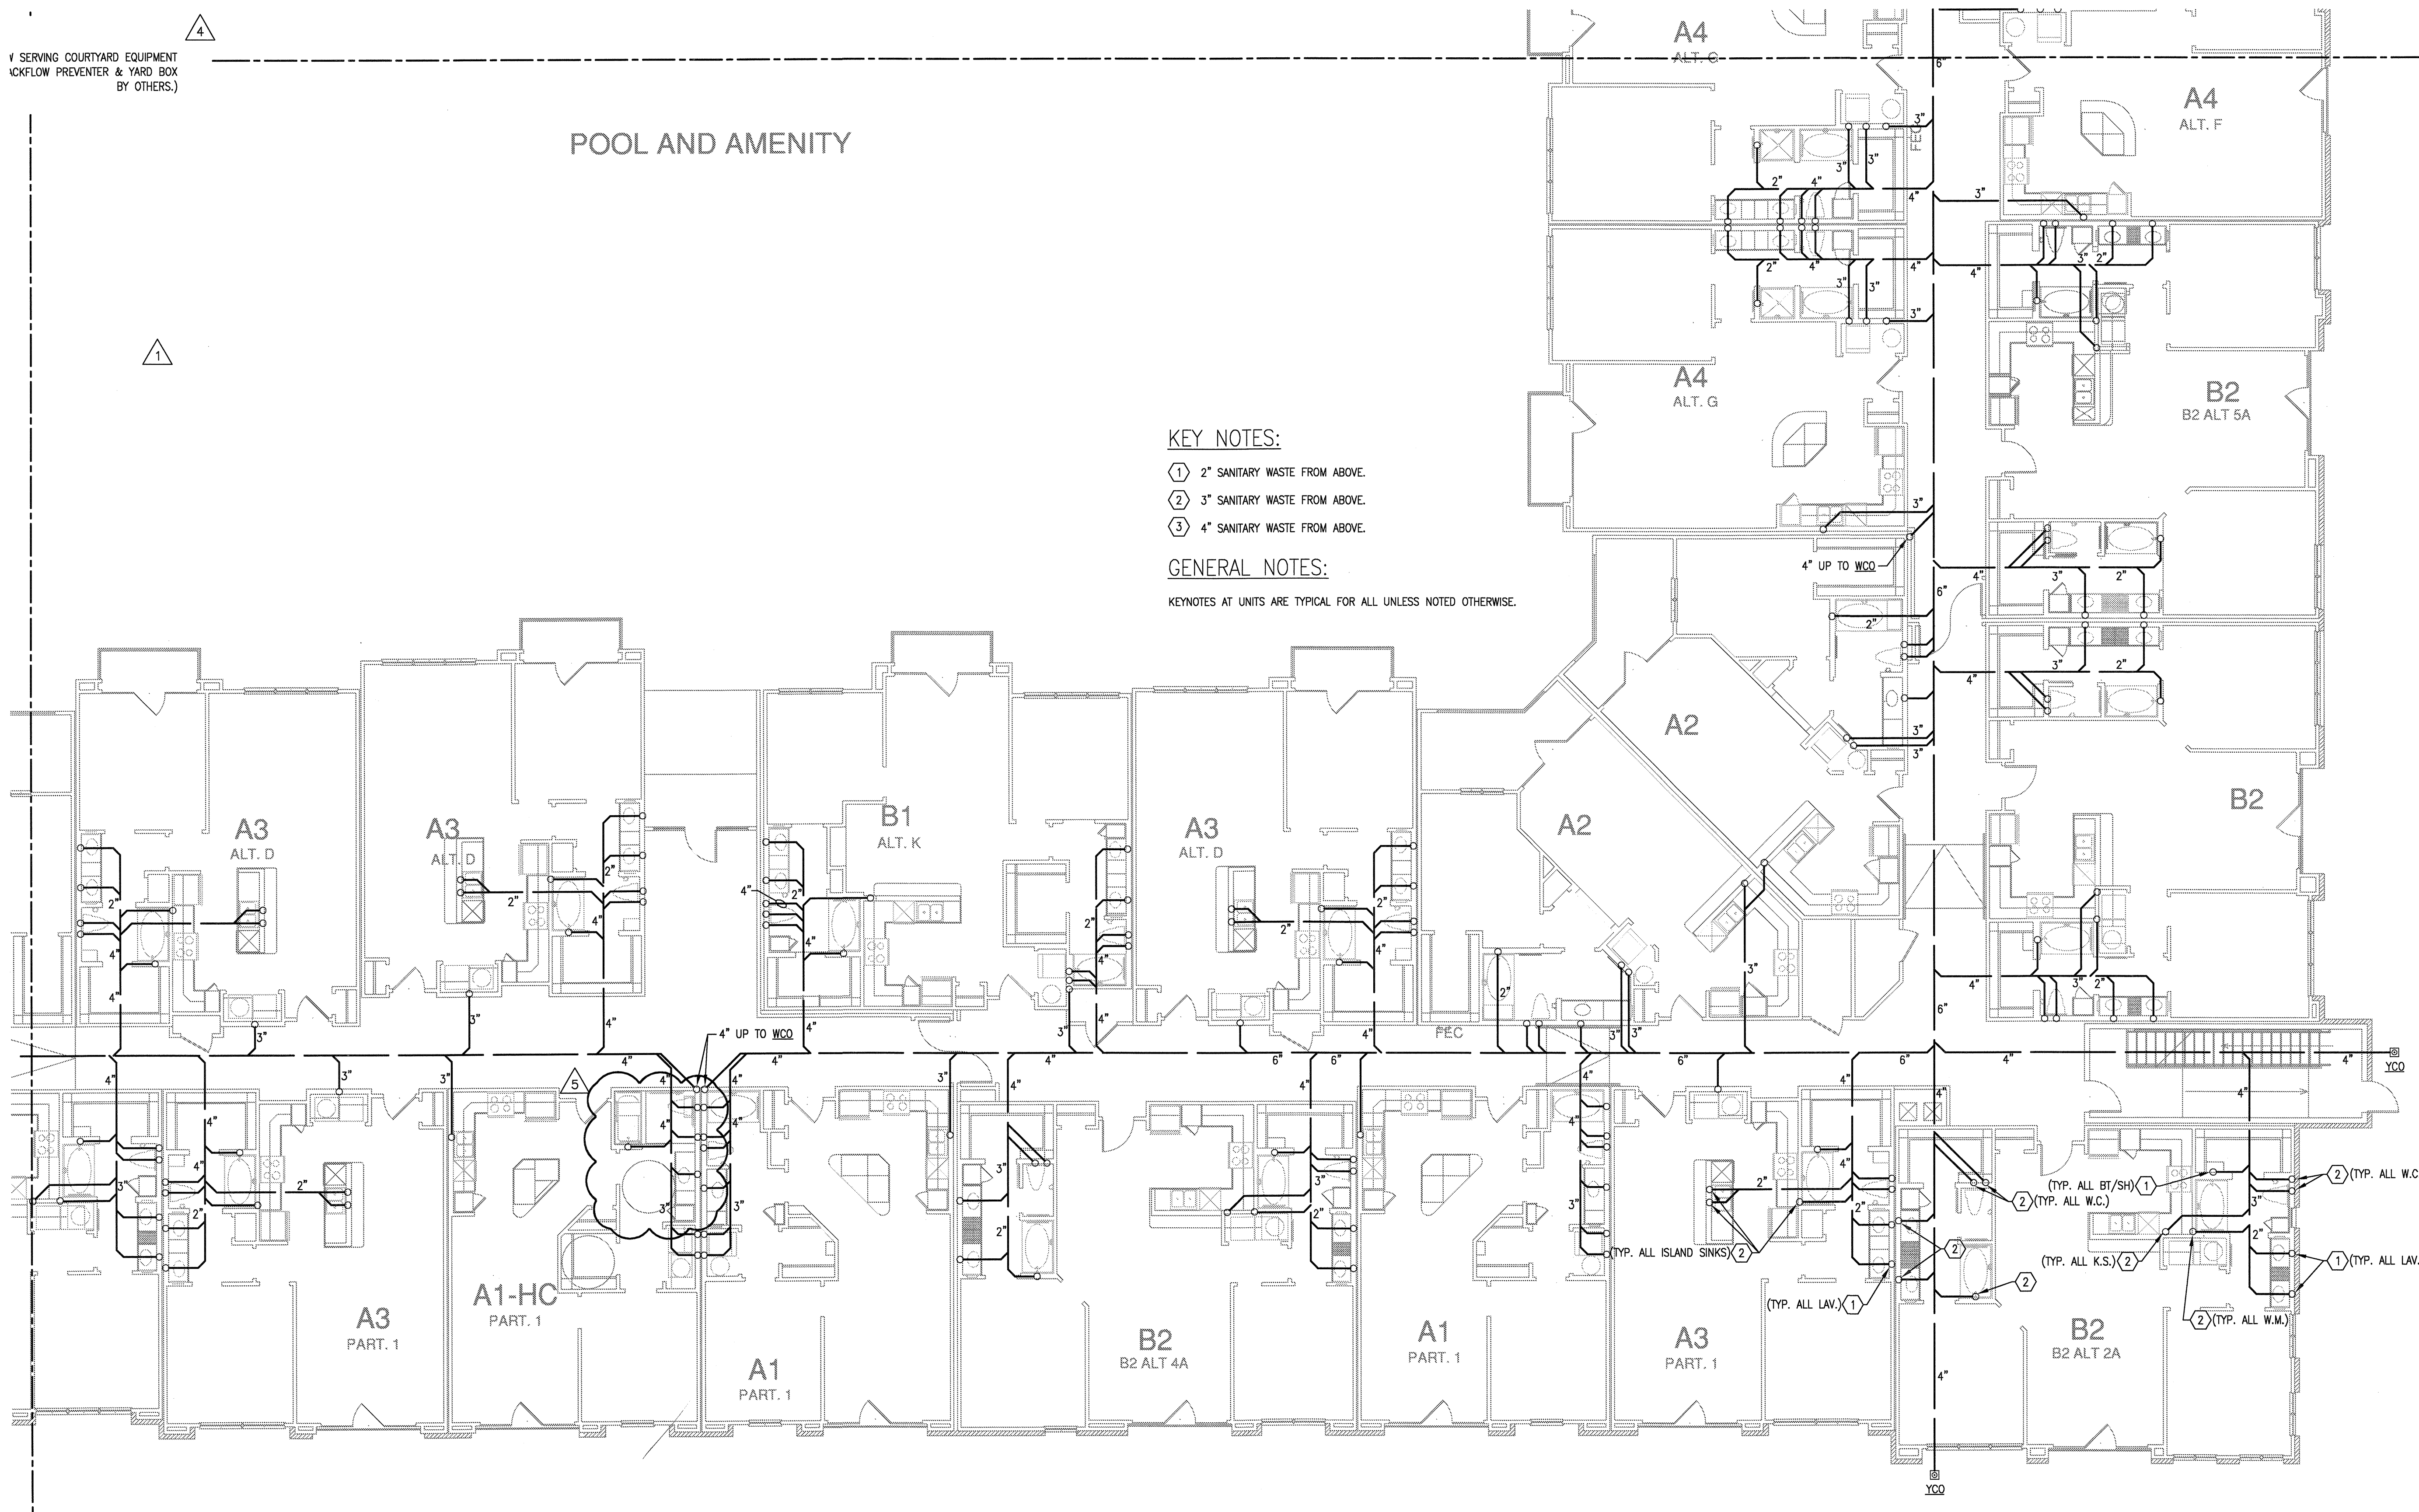


KEY NOTES:

- ① 2" SANITARY WASTE FROM ABOVE.
- ② 3" SANITARY WASTE FROM ABOVE.
- ③ 4" SANITARY WASTE FROM ABOVE.

GENERAL NOTES:

KEYNOTES AT UNITS ARE TYPICAL FOR ALL UNLESS NOTED OTHERWISE.

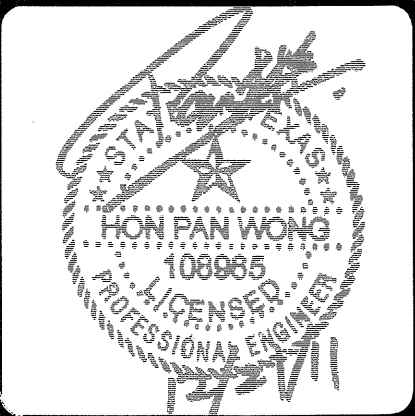

REVISIONS	
①	9-2-2011 DESIGN REVISIONS
②	9-13-2011 ANSI/FHA COMMENTS
③	9-23-2011 DESIGN REVISIONS
④	10-17-2011 CONSTRUCTION ISSUE
⑤	12-21-2011 DESIGN REVISIONS

KELLER SPRINGS LOFTS
 LOFT APARTMENTS IN ADDISON, TEXAS


BGO
 architects
 4144 N. Central Expy.
 Suite 855
 Dallas, TX 75204
 214.520.8878
 bgoarchitects.com

DATE
 08-05-11

PROJECT
 11129

SHEET NUMBER

P-3.0F

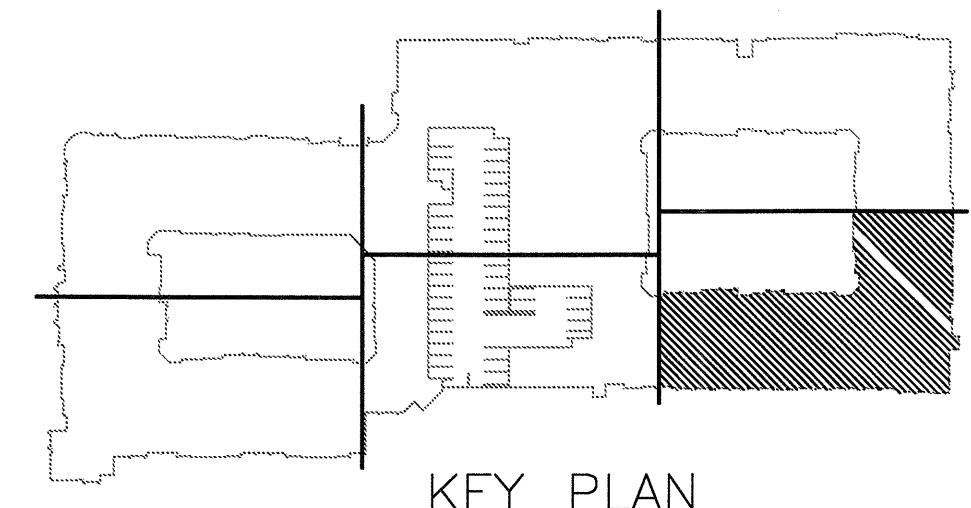

KEY_PLAN

1 DIVISION 'F' UNDERFLOOR PLAN
 SCALE: 1/8" = 1'-0"

JSE Jordan & Skala Engineers
 14240 Midway Road, Suite 310
 Dallas, TX 75244-5138
 Tel: (469) 385-1616 Fax: (469) 385-1615
 Project Number - 113-035 Texas Firm Registration # F-4990
 Drawn By: CV Checked By: RC