





REVISIONS		
1	9-2-2011	DESIGN REVISIONS
2	9-13-2011	ANSI/FHA COMMENTS
3	9-23-2011	DESIGN REVISIONS
4	10-17-2011	CONSTRUCTION ISSUE
5	12-21-2011	DESIGN REVISIONS
6	1-17-2012	DESIGN REVISIONS

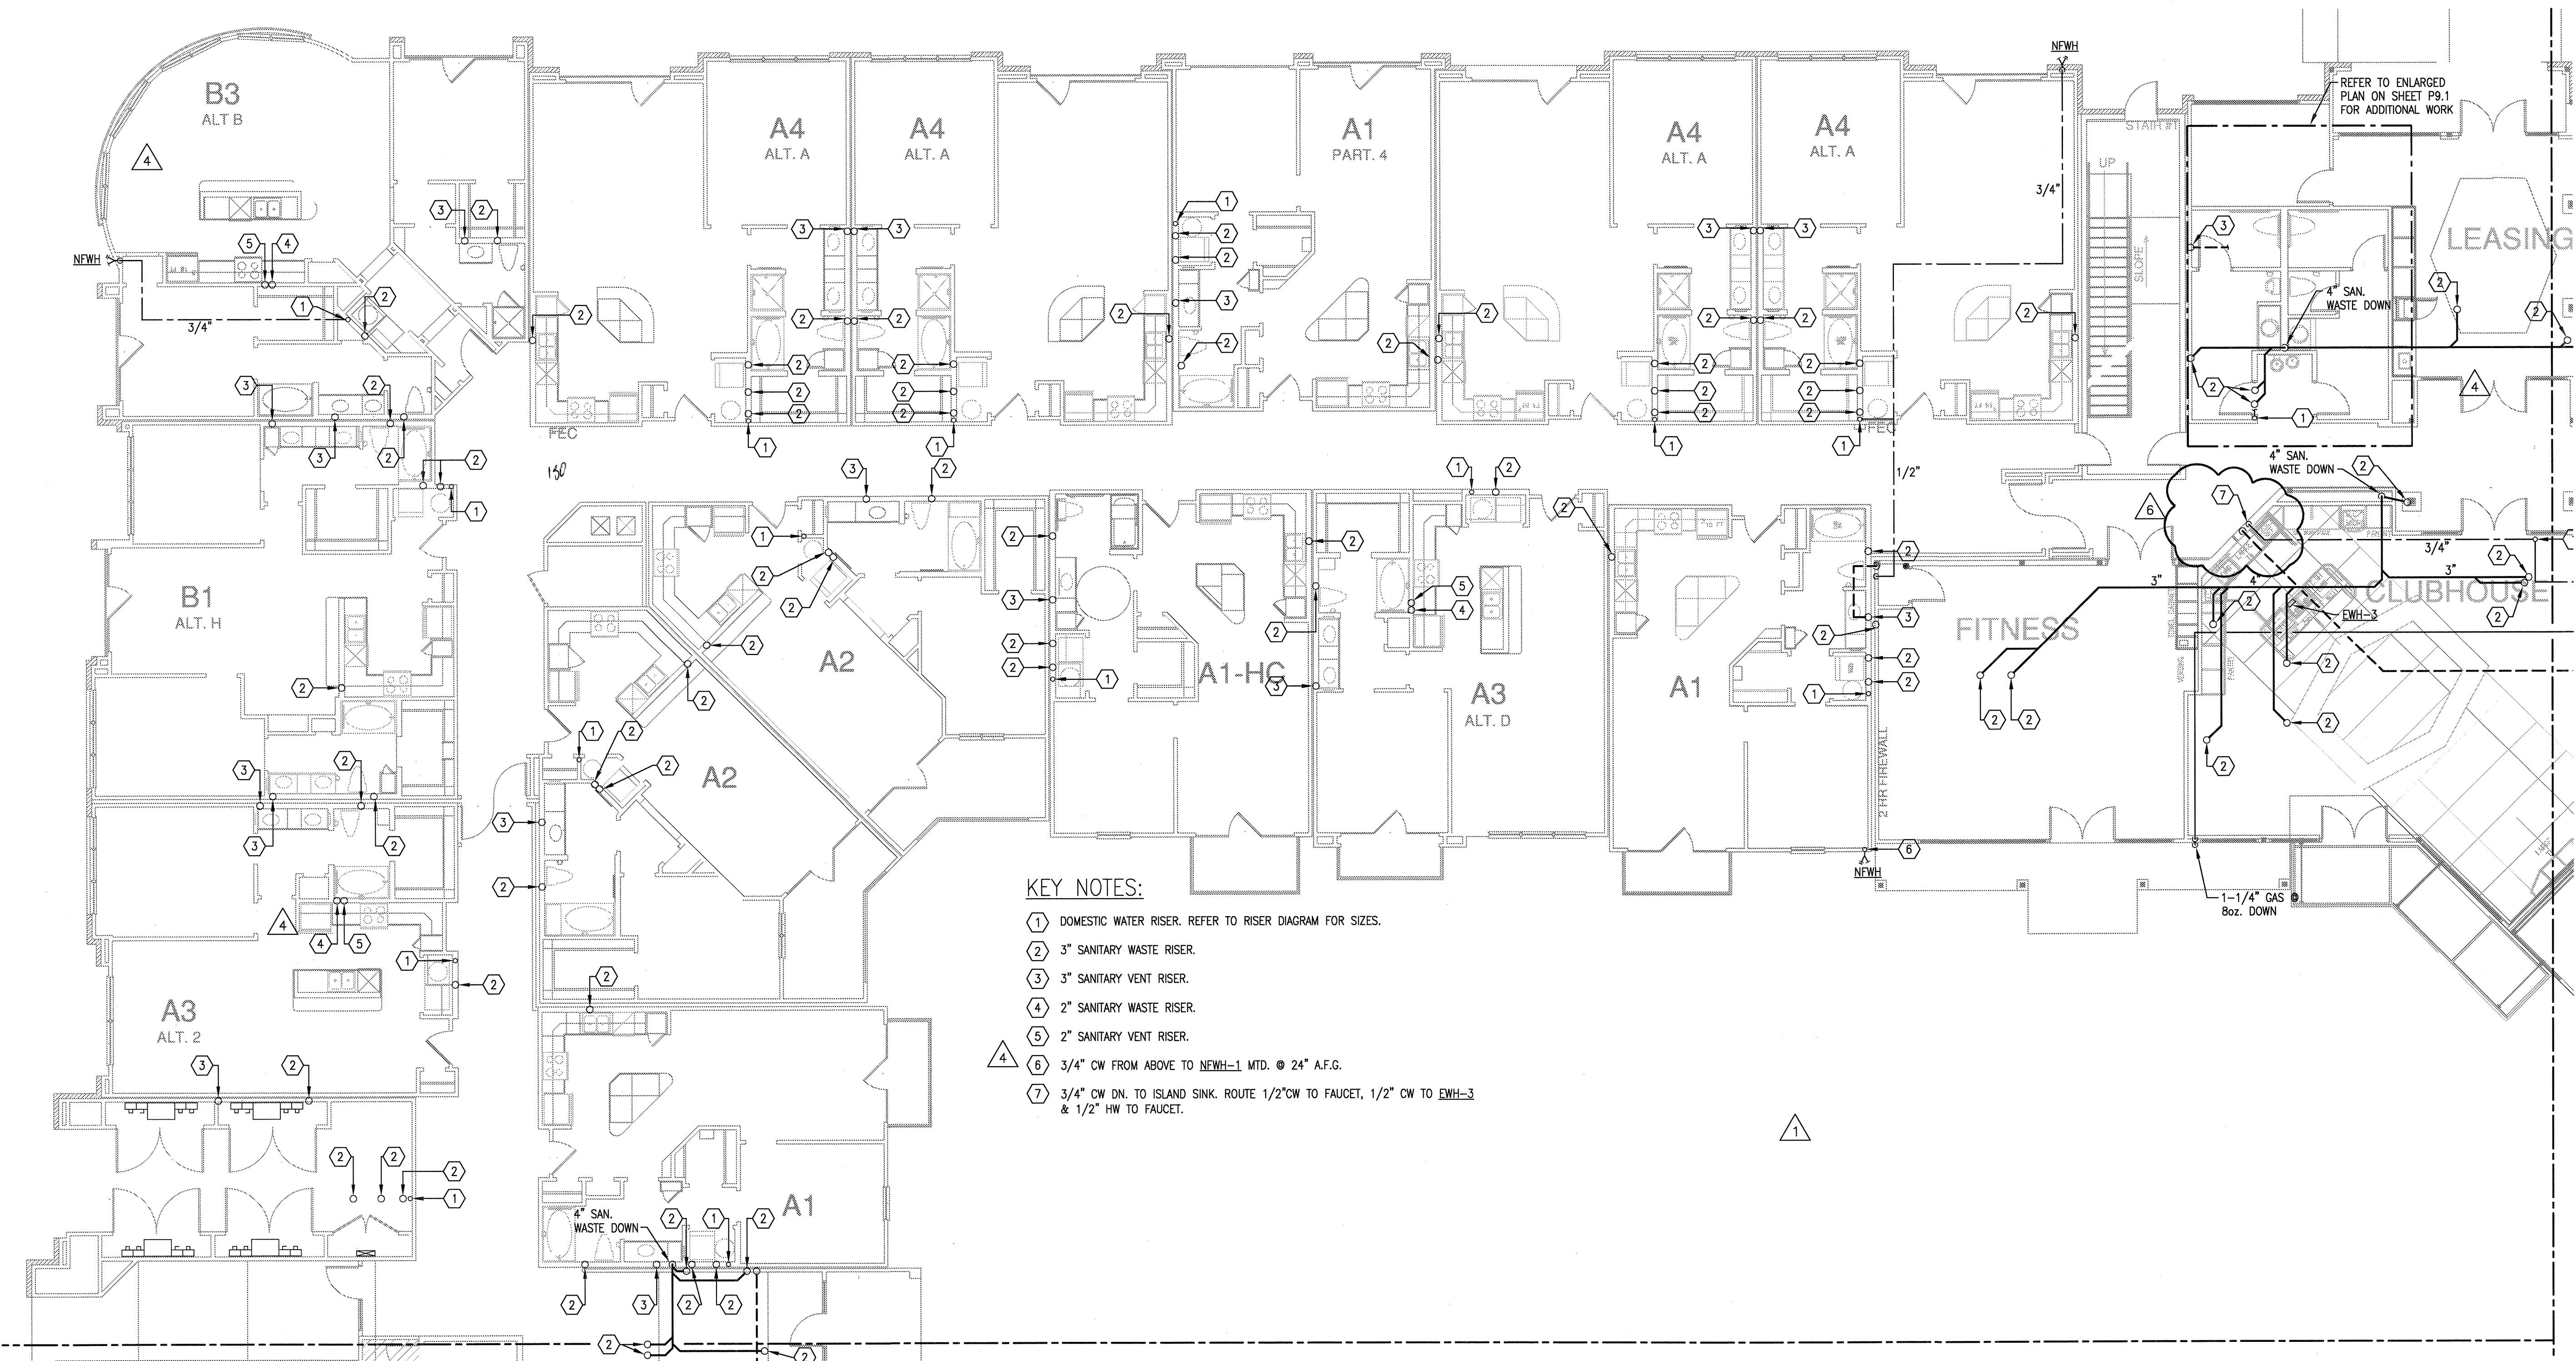

- KEY NOTES:**
- 1 DOMESTIC WATER RISER. REFER TO RISER DIAGRAM FOR SIZES.
  - 2 3" SANITARY WASTE RISER.
  - 3 3" SANITARY VENT RISER.
  - 4 2" SANITARY WASTE RISER.
  - 5 2" SANITARY VENT RISER.
  - 6 3/4" CW FROM ABOVE TO NEWH-1 MTD. @ 24" A.F.G.
  - 7 3/4" CW DN. TO ISLAND SINK. ROUTE 1/2" CW TO FAUCET, 1/2" CW TO EWH-3 & 1/2" HW TO FAUCET.

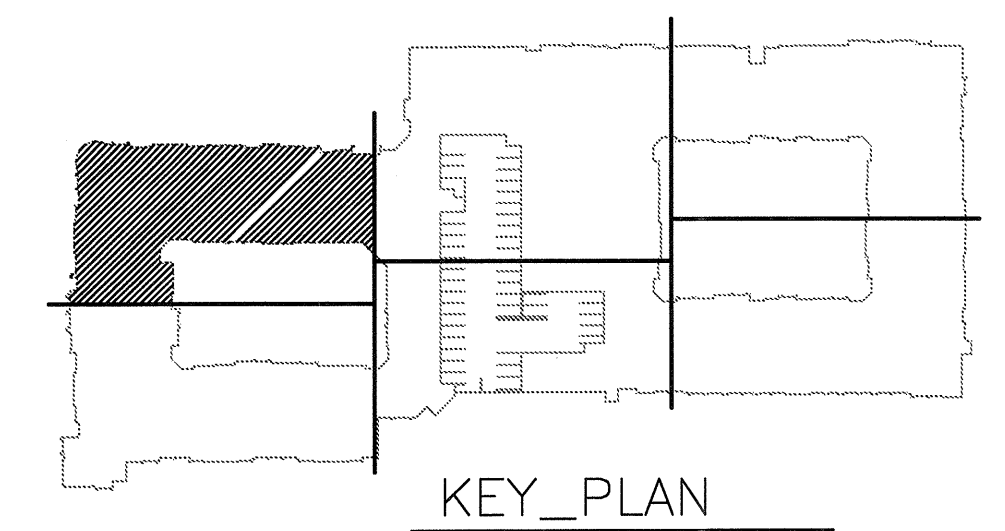

KEY\_PLAN

1 DIVISION 'A' FIRST FLOOR PLAN  
SCALE: 1/8" = 1'-0"

**JSE** Jordan & Skala Engineers  
 14240 Midway Road, Suite 350  
 Dallas, TX 75244-5138  
 Tel: (469) 385-1616 | Fax: (469) 385-1615  
 Project Number - 113-0355  
 Drawn By: CV  
 Texas Firm Registration # F-4990  
 Checked By: RC

**KELLER SPRINGS LOFTS**  
LOFT APARTMENTS IN ADDISON, TEXAS

**BGO** architects  
 4144 N. Central Expy.  
 Suite 855  
 Dallas, TX 75204  
 214.520.8878  
 bgoarchitects.com

DATE  
08-05-11

PROJECT  
11129

SHEET NUMBER

**P-3.1A**