

REVISIONS

1	9-2-2011	DESIGN REVISIONS
2	9-13-2011	ANSI/FHA COMMENTS
3	9-23-2011	DESIGN REVISIONS
4	10-17-2011	CONSTRUCTION ISSUE

**KELLER SPRINGS LOFTS**  
 LOFT APARTMENTS IN ADDISON, TEXAS

**BGO architects**  
 4144 N. Central Expy.  
 Suite 855  
 Dallas, TX 75204  
 214.520.8878  
 bgoarchitects.com


DATE  
 08-05-11

PROJECT  
 11129


SHEET NUMBER

**P-3.1C**

**JSE** Jordan & Skala Engineers  
 14240 Ardmore Road, Suite 350  
 Dallas, TX 75244-5338  
 V: (469) 385-1615, F: (469) 385-1615  
 Project Number - 113-0355 Texas Firm Registration # F-4900  
 Drawn By: CV Checked By: RC

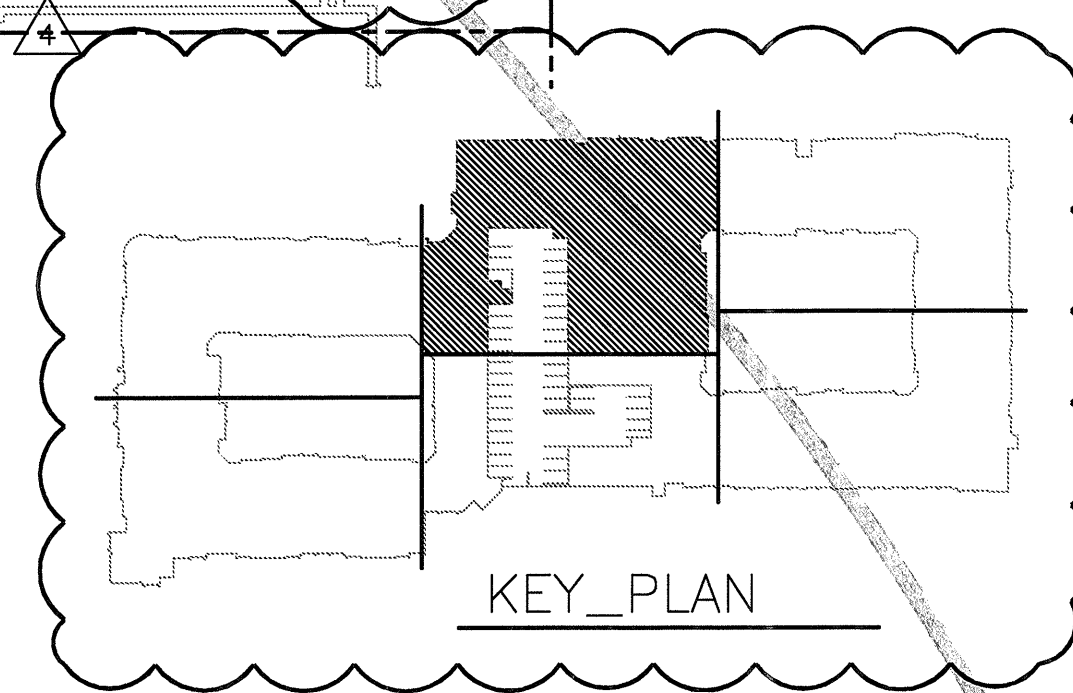

- KEY NOTES:**
- 1 DOMESTIC WATER RISER. REFER TO RISER DIAGRAM FOR SIZES.
  - 2 3" SANITARY WASTE RISER.
  - 3 3" SANITARY VENT RISER.
  - 4 2" SANITARY WASTE RISER.
  - 5 2" SANITARY VENT RISER.
  - 6 3/4" CW FROM ABOVE TO NEWH-1 MTD. @ 24" A.F.G.
  - 7 1" CW FROM ABOVE AND DN. TO BELOW GRADE TO SERVE COURTYARD EQUIPMENT.

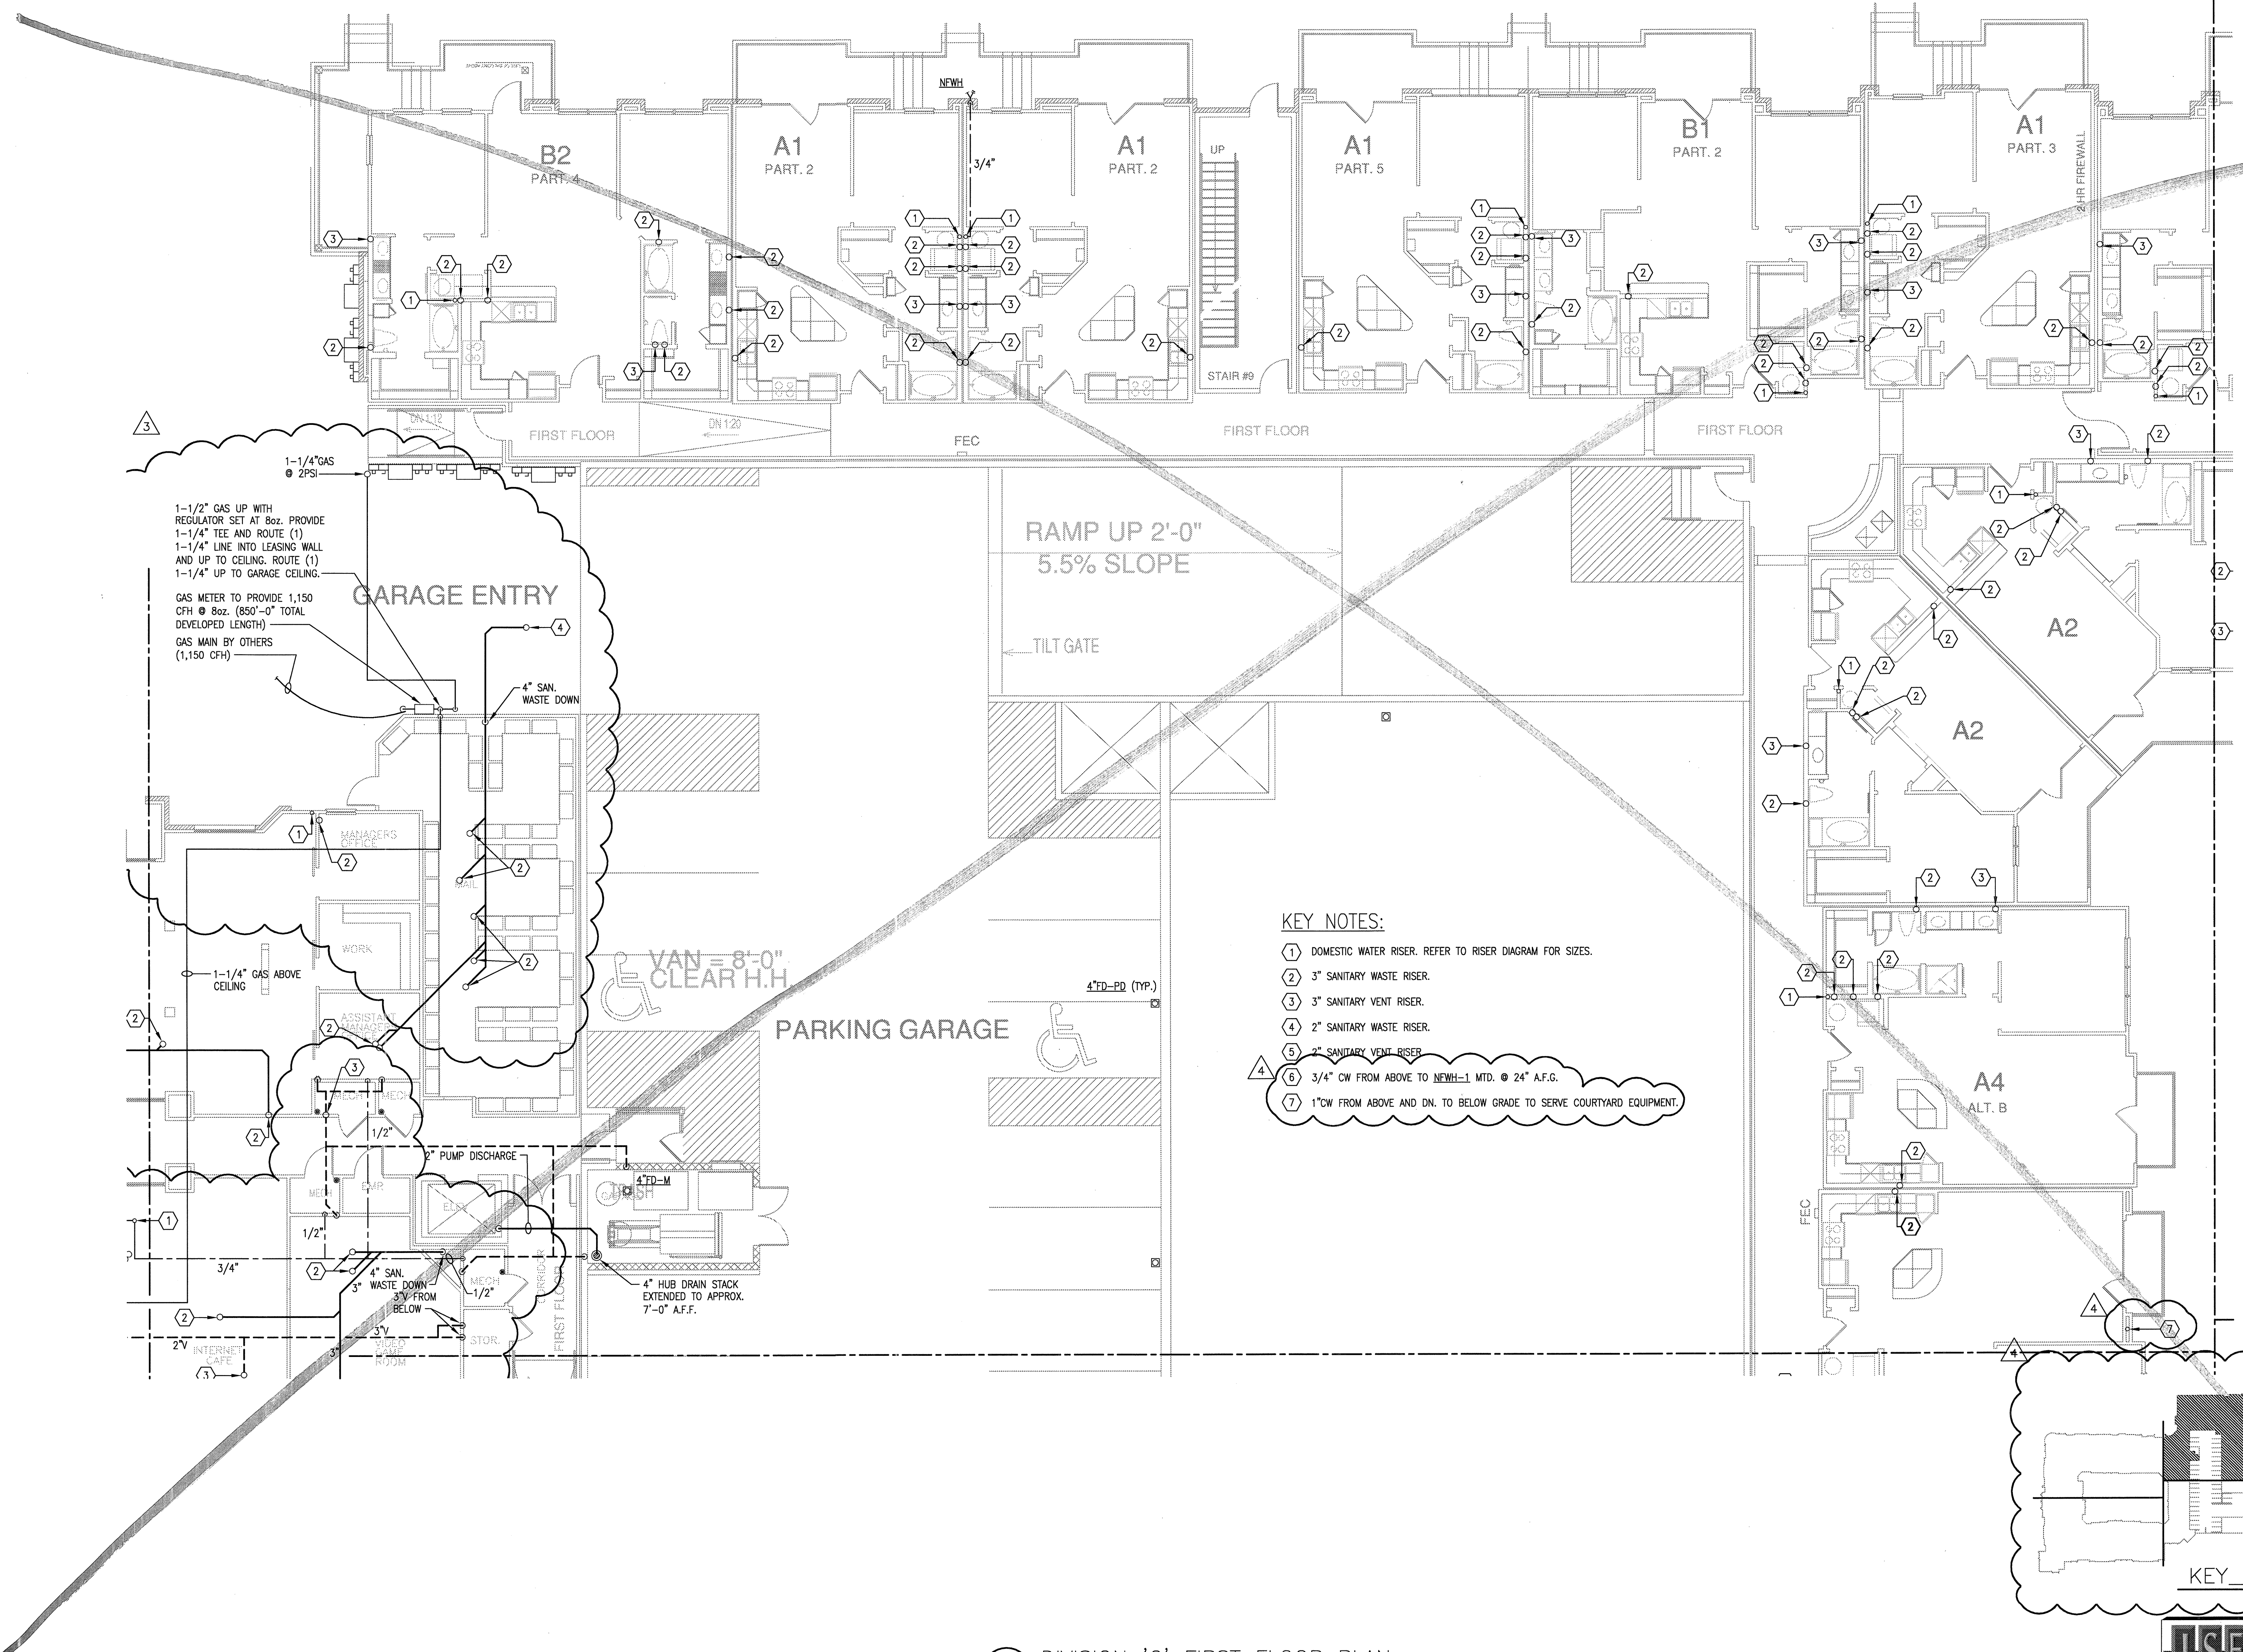

1 DIVISION 'C' FIRST FLOOR PLAN  
 SCALE: 1/8" = 1'-0"