

REVISIONS

1	9-2-2011	DESIGN REVISIONS
2	9-13-2011	ANSI/FHA COMMENTS
3	9-23-2011	DESIGN REVISIONS
4	10-17-2011	CONSTRUCTION ISSUE
5	12-21-2011	DESIGN REVISIONS

KELLER SPRINGS LOFTS

LOFT APARTMENTS IN ADDISON, TEXAS


BGO
architects
4144 N. Central Expy., Suite 855
Dallas, TX 75204
214.520.8878
bgoarchitects.com

DATE
08-05-11

PROJECT
11129


SHEET NUMBER

P-3.1D

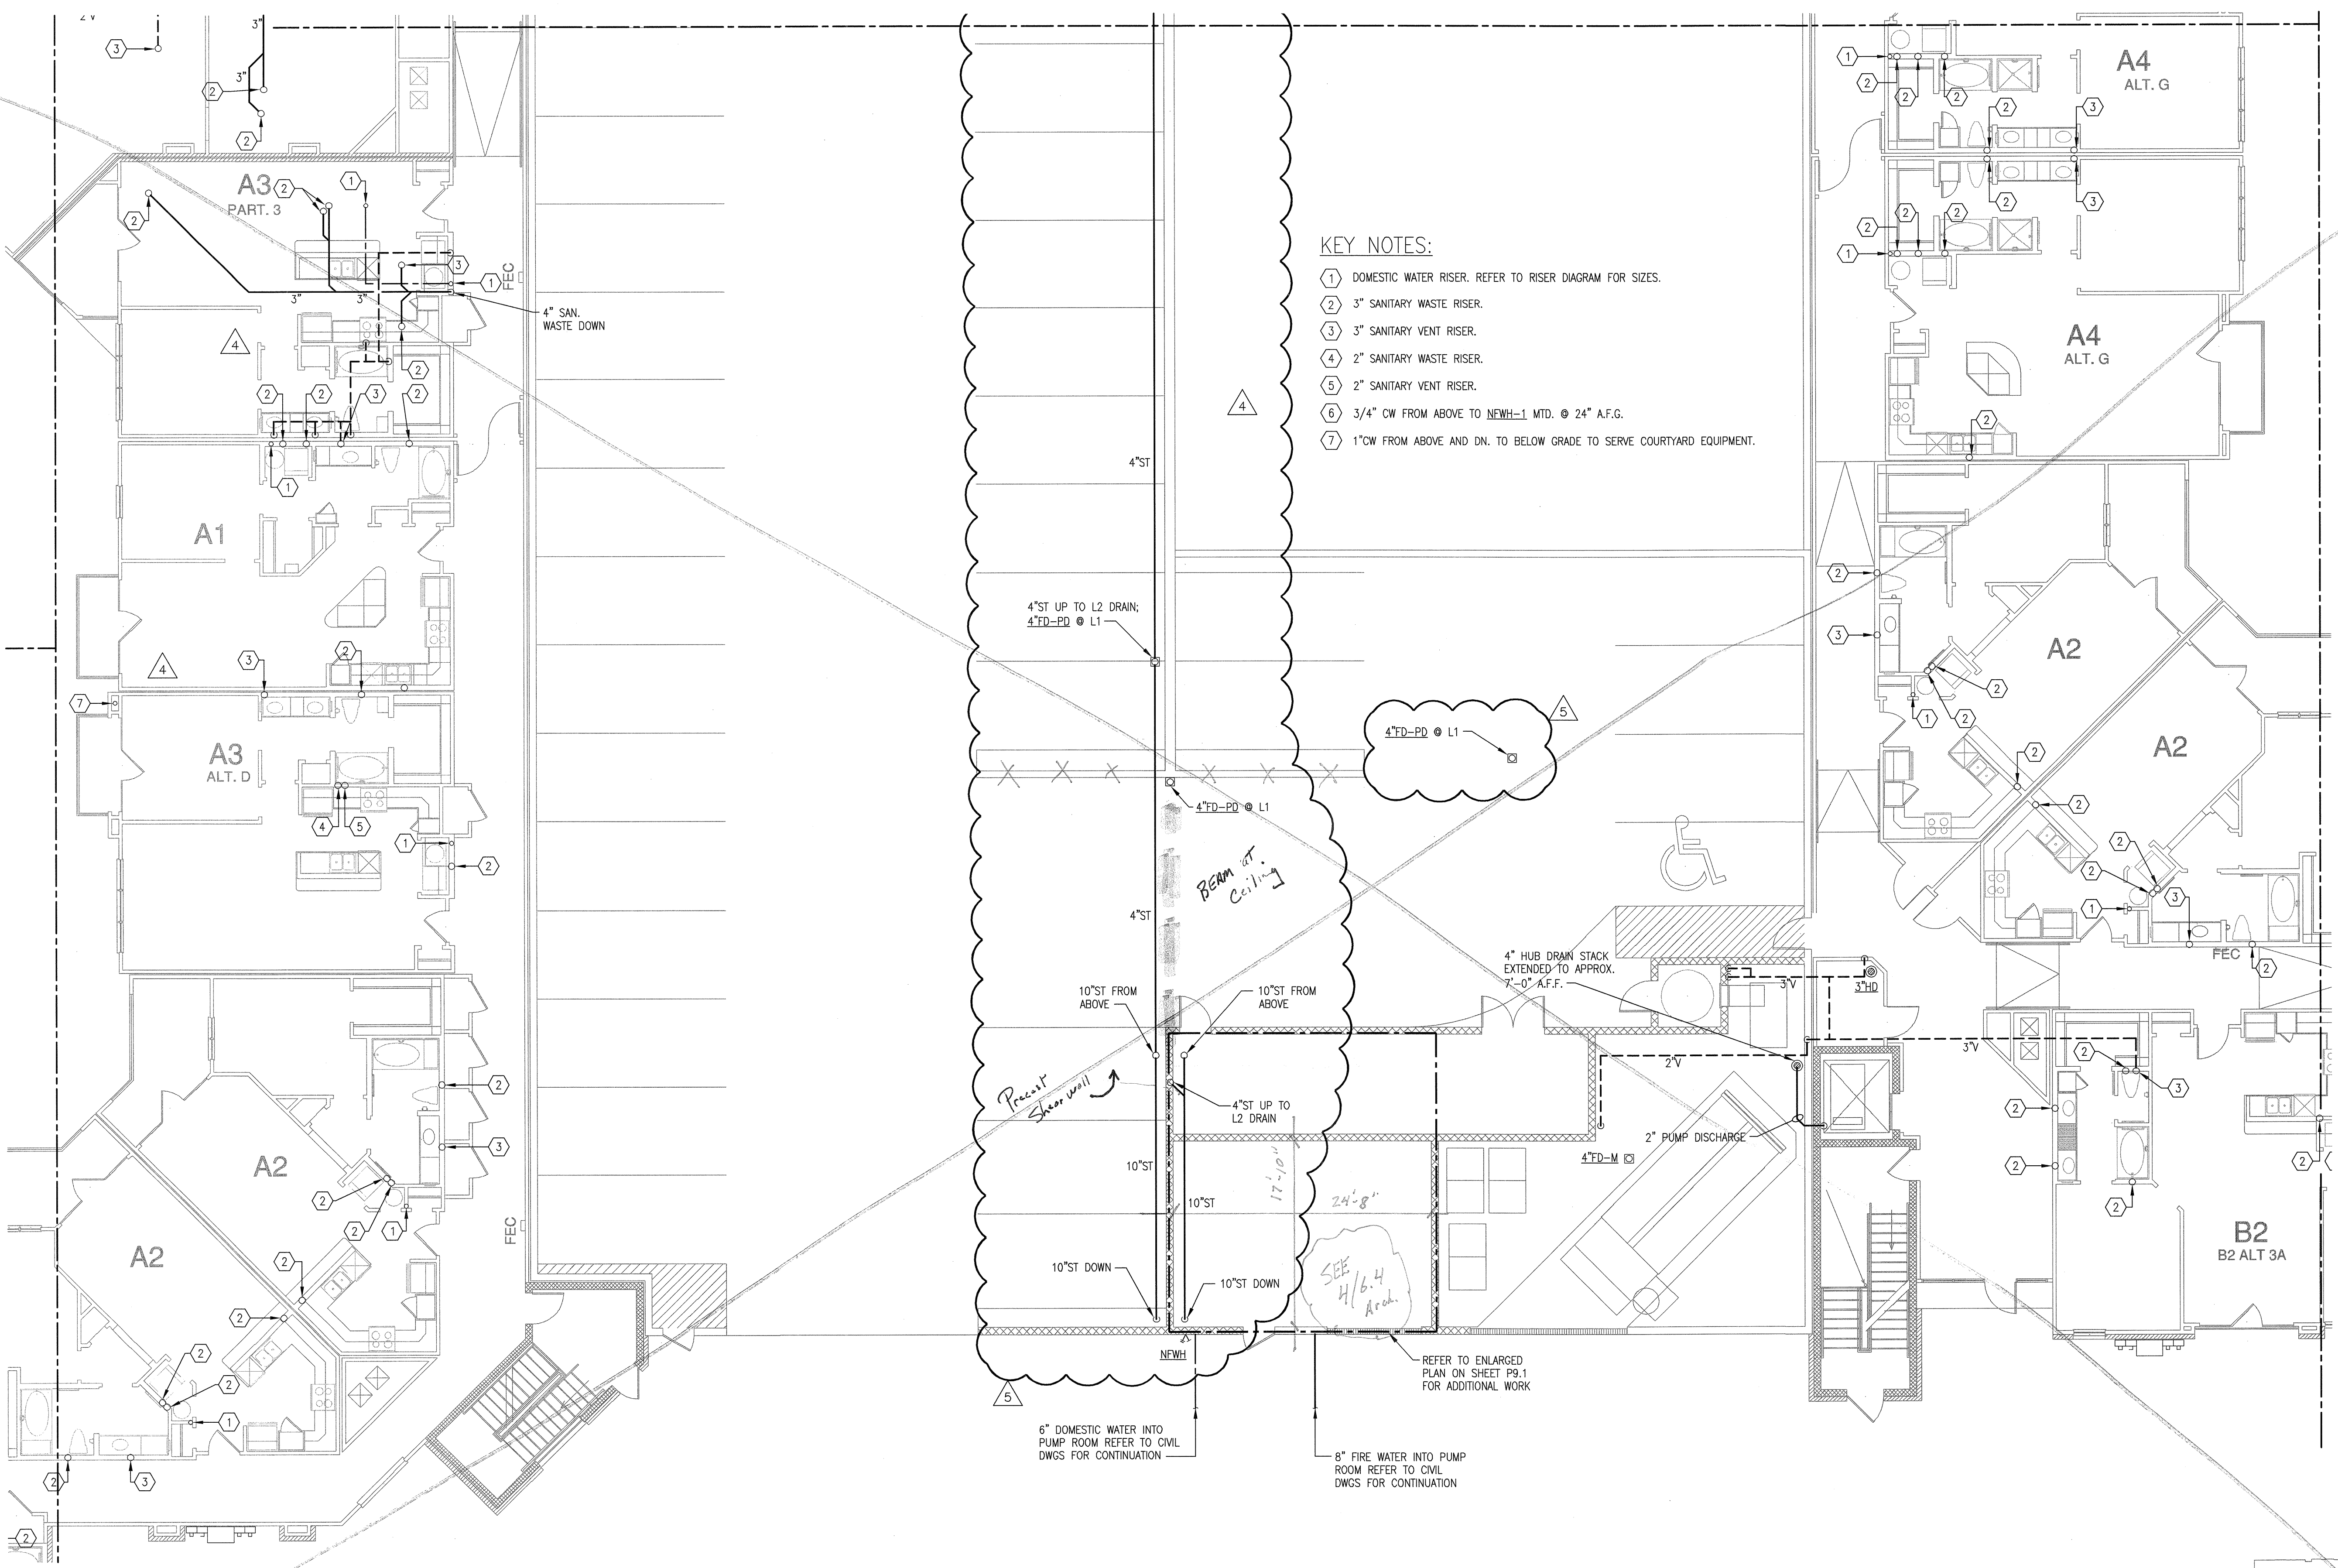

- KEY NOTES:**
- ① DOMESTIC WATER RISER. REFER TO RISER DIAGRAM FOR SIZES.
 - ② 3" SANITARY WASTE RISER.
 - ③ 3" SANITARY VENT RISER.
 - ④ 2" SANITARY WASTE RISER.
 - ⑤ 2" SANITARY VENT RISER.
 - ⑥ 3/4" CW FROM ABOVE TO NEWH-1 MTD. @ 24" A.F.G.
 - ⑦ 1" CW FROM ABOVE AND DN. TO BELOW GRADE TO SERVE COURTYARD EQUIPMENT.

1 DIVISION 'D' FIRST FLOOR PLAN
SCALE: 1/8" = 1'-0"

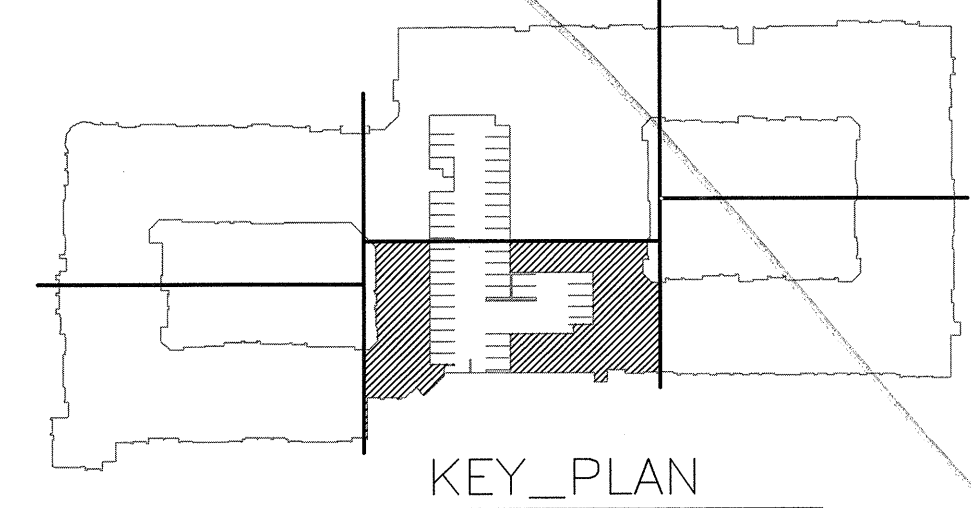

JSE Jordan & Skala Engineers
14240 Midway Road, Suite 350
Dallas, TX 75244-5138
V: (469) 383-1424 F: (469) 383-1615
Project Number - 113-0355 Texas Firm Registration # F-4990
Drawn By: CV Checked By: RC