

REVISIONS

1	9-2-2011	DESIGN REVISIONS
2	9-13-2011	ANSI/FHA COMMENTS
3	9-23-2011	DESIGN REVISIONS
4	10-17-2011	CONSTRUCTION ISSUE

# KELLER SPRINGS LOFTS

LOFT APARTMENTS IN ADDISON, TEXAS

**BGO**  
architects  
4144 N. Central Expy.  
Suite 855  
Dallas, TX 75204  
214.520.8878  
bgoarchitects.com


DATE  
08-05-11

PROJECT  
11129


SHEET NUMBER

**P-3.1D**

**JSE** Jordan & Skala Engineers  
1425 Midway Road, Suite 350  
Dallas, TX 75244-5138  
v: (469) 385-1616, f: (469) 385-1615  
Project Number - 113-0355  
Drawn By: CV  
Texas Firm Registration # F-4990  
Checked By: RC

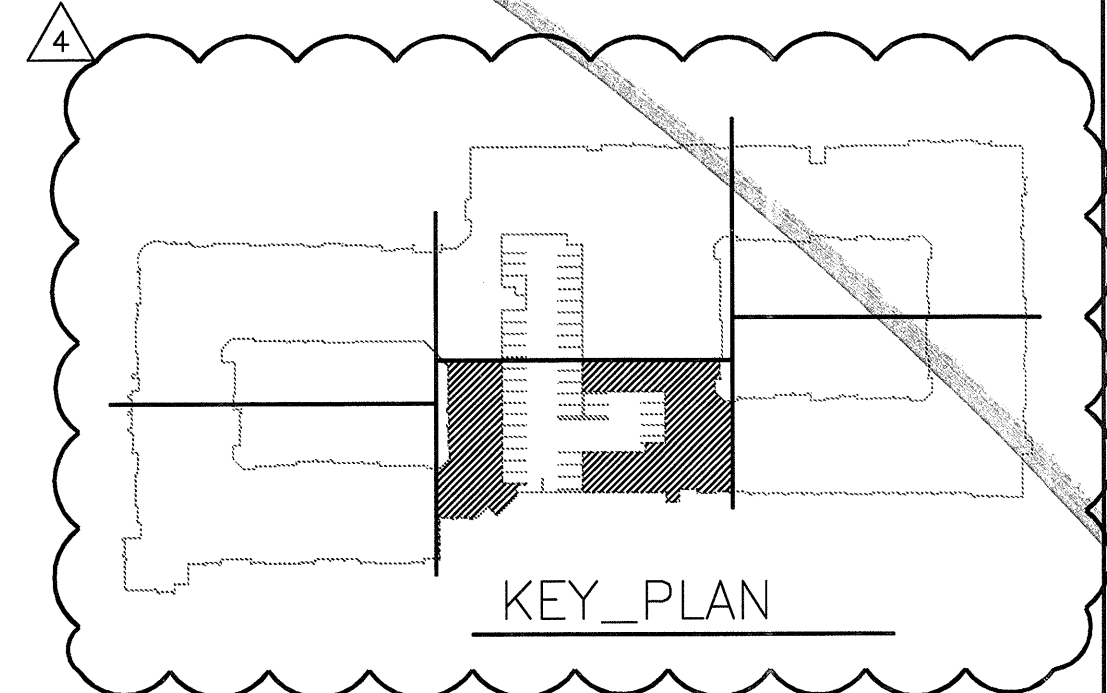

- KEY NOTES:**
- 1 DOMESTIC WATER RISER. REFER TO RISER DIAGRAM FOR SIZES.
  - 2 3" SANITARY WASTE RISER.
  - 3 3" SANITARY VENT RISER.
  - 4 2" SANITARY WASTE RISER.
  - 5 2" SANITARY VENT RISER.
  - 6 3/4" CW FROM ABOVE TO NEWH-1 MTD. @ 24" A.F.G.
  - 7 1" CW FROM ABOVE AND DN. TO BELOW GRADE TO SERVE COURTYARD EQUIPMENT.

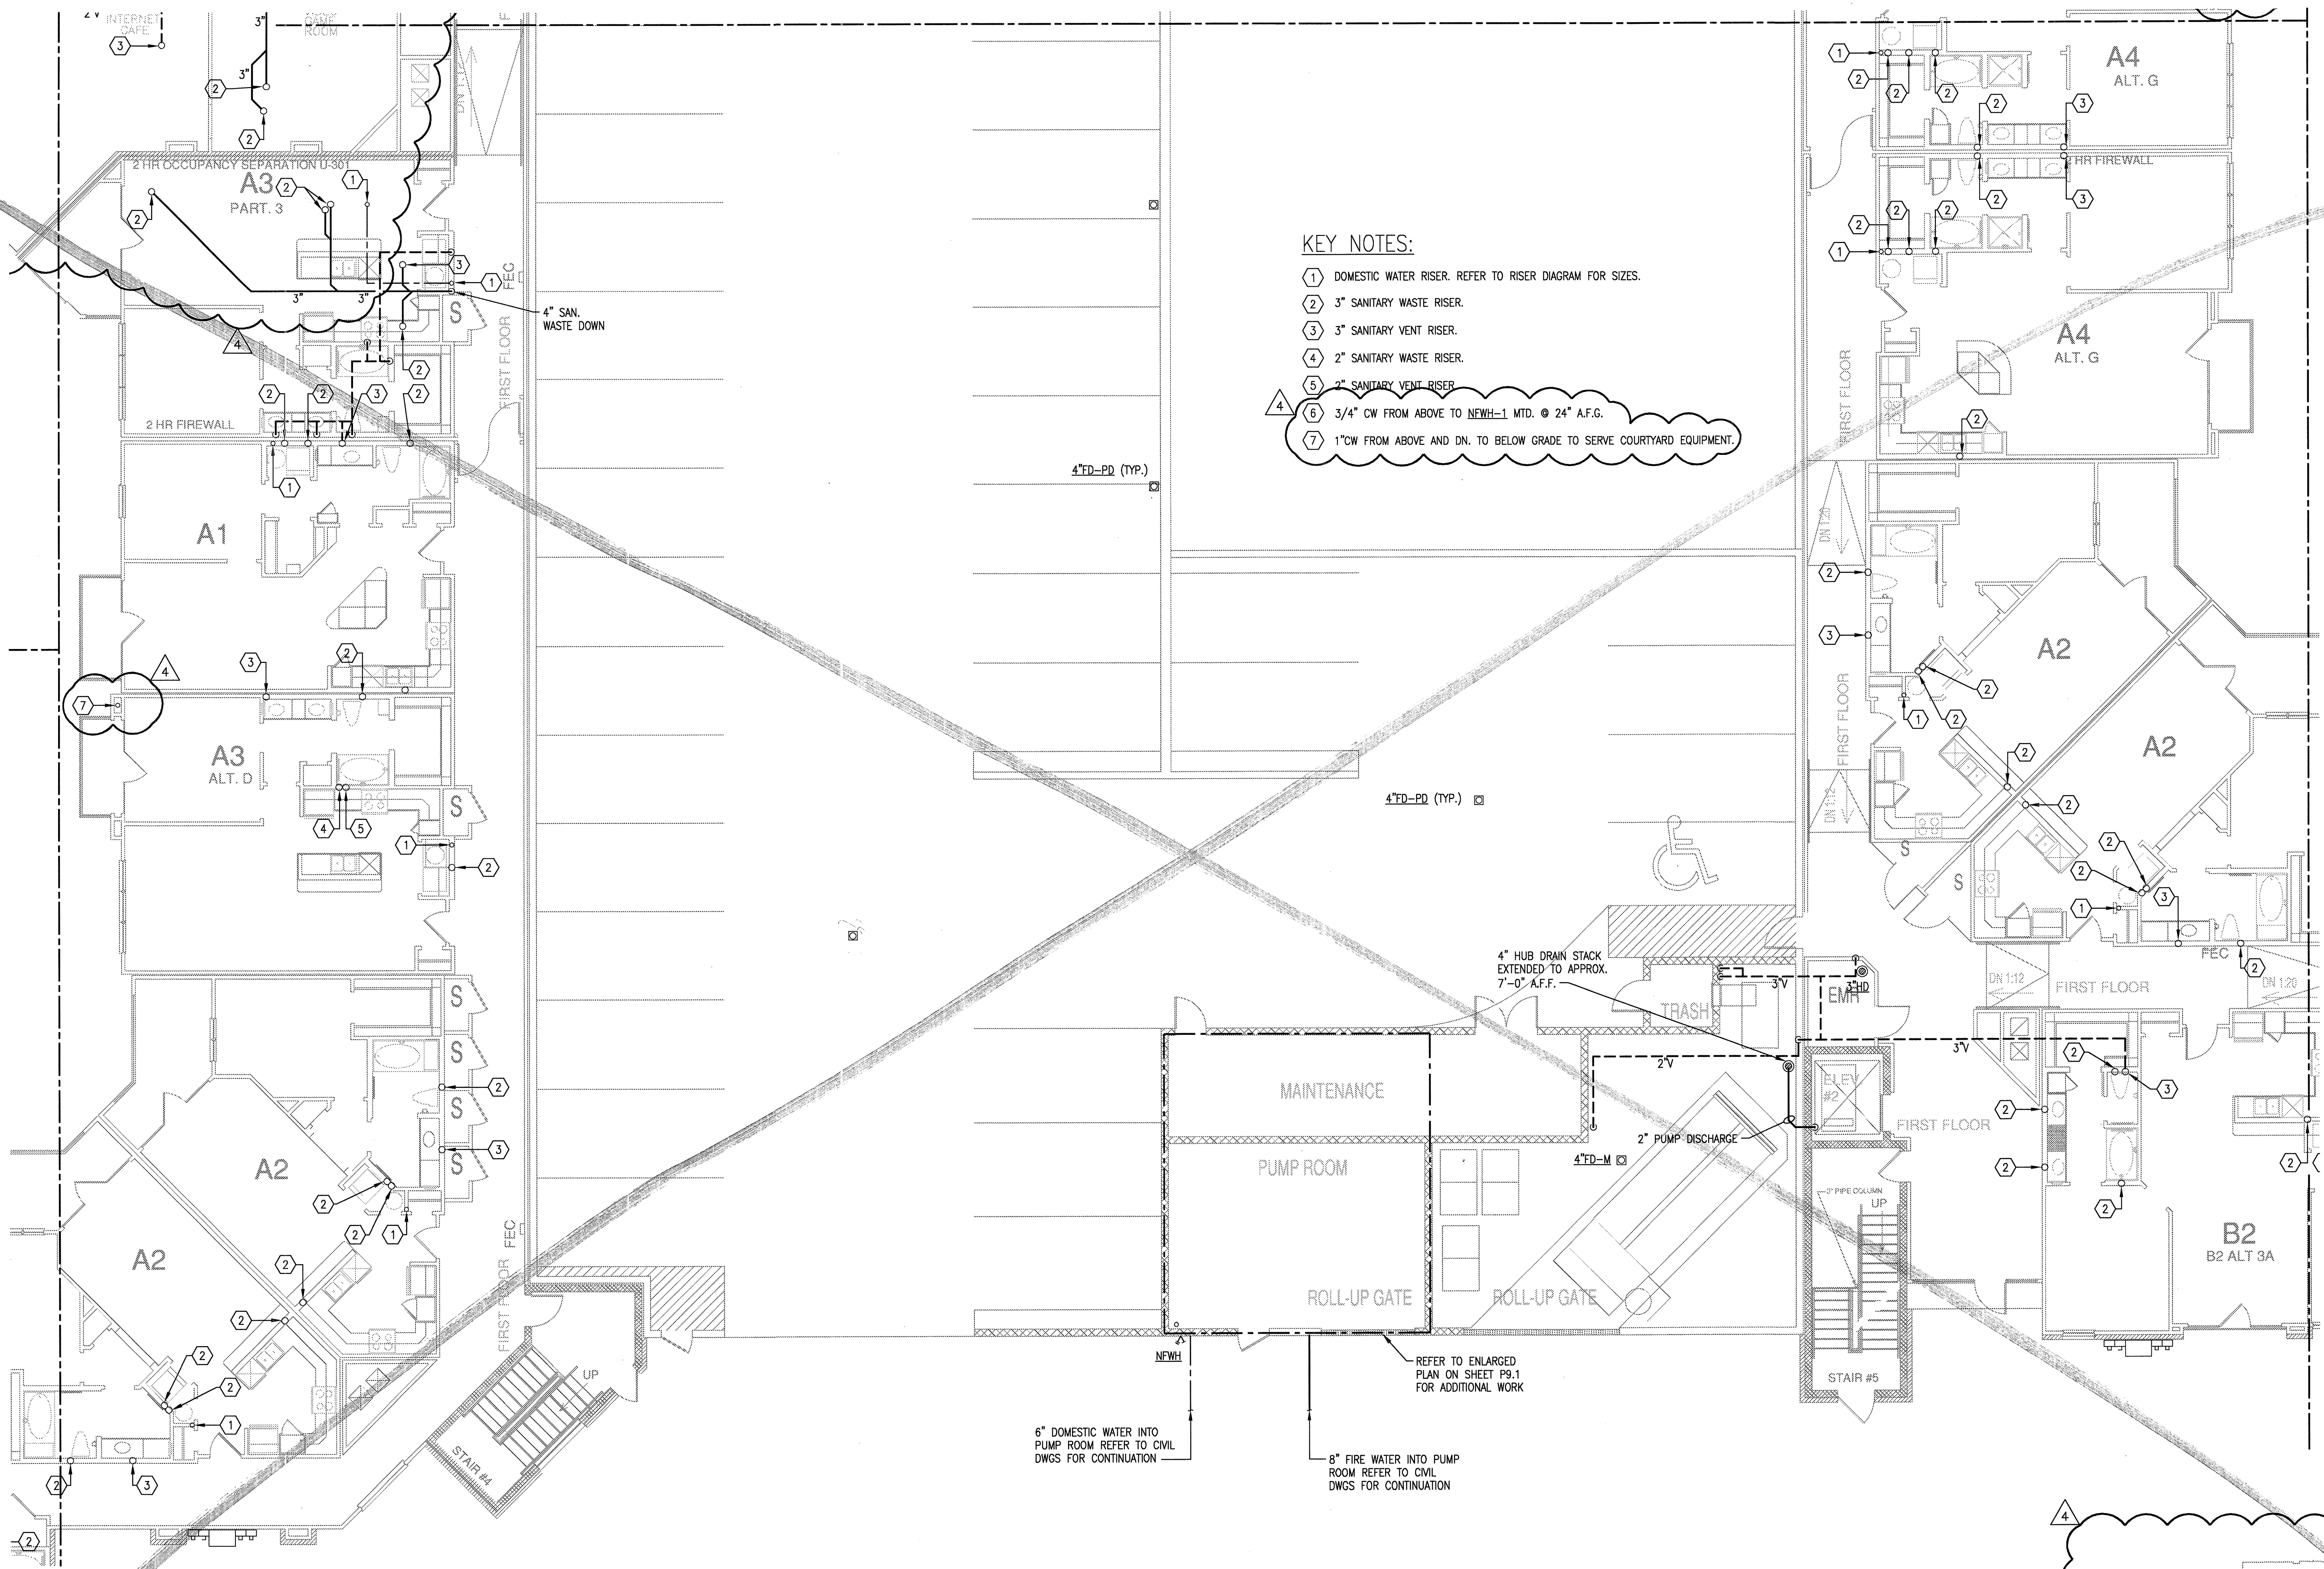

6" DOMESTIC WATER INTO PUMP ROOM REFER TO CIVIL DWGS FOR CONTINUATION

8" FIRE WATER INTO PUMP ROOM REFER TO CIVIL DWGS FOR CONTINUATION

REFER TO ENLARGED PLAN ON SHEET P9.1 FOR ADDITIONAL WORK

1 DIVISION 'D' FIRST FLOOR PLAN  
SCALE: 1/8" = 1'-0"