



REVISIONS		
1	9-2-2011	DESIGN REVISIONS
2	9-13-2011	ANSI/FHA COMMENTS DESIGN
3	9-23-2011	REVISIONS
4	10-17-2011	CONSTRUCTION ISSUE
5	12-21-2011	DESIGN REVISIONS
6	1-17-2012	DESIGN REVISIONS
7	2-15-2012	TRANSFORMER REVISIONS
8	3-27-2012	CLUBHOUSE REVISIONS
9	4-17-2012	COORDINATION

KELLER SPRINGS LOFTS
 LOFT APARTMENTS IN ADDISON, TEXAS

10	5-15-2012	COORDINATION
11	5-30-2012	SITE COORDINATION



4144 N. Central Expy.
 Suite 855
 Dallas, TX 75204
 214.520.8878
 bgoarchitects.com


DATE
 08-05-11

PROJECT
 11129

SHEET NUMBER
P-3.1D



Jordan & Skala Engineers
 17835 N. Dallas Parkway, Suite 330
 Dallas, TX 75297-4857
 V: (469) 385-1616 Web: www.jordanaska.com
 Project Number - 113-0355 Texas Firm Registration # F-4990
 Drawn By: CV Checked By: RC

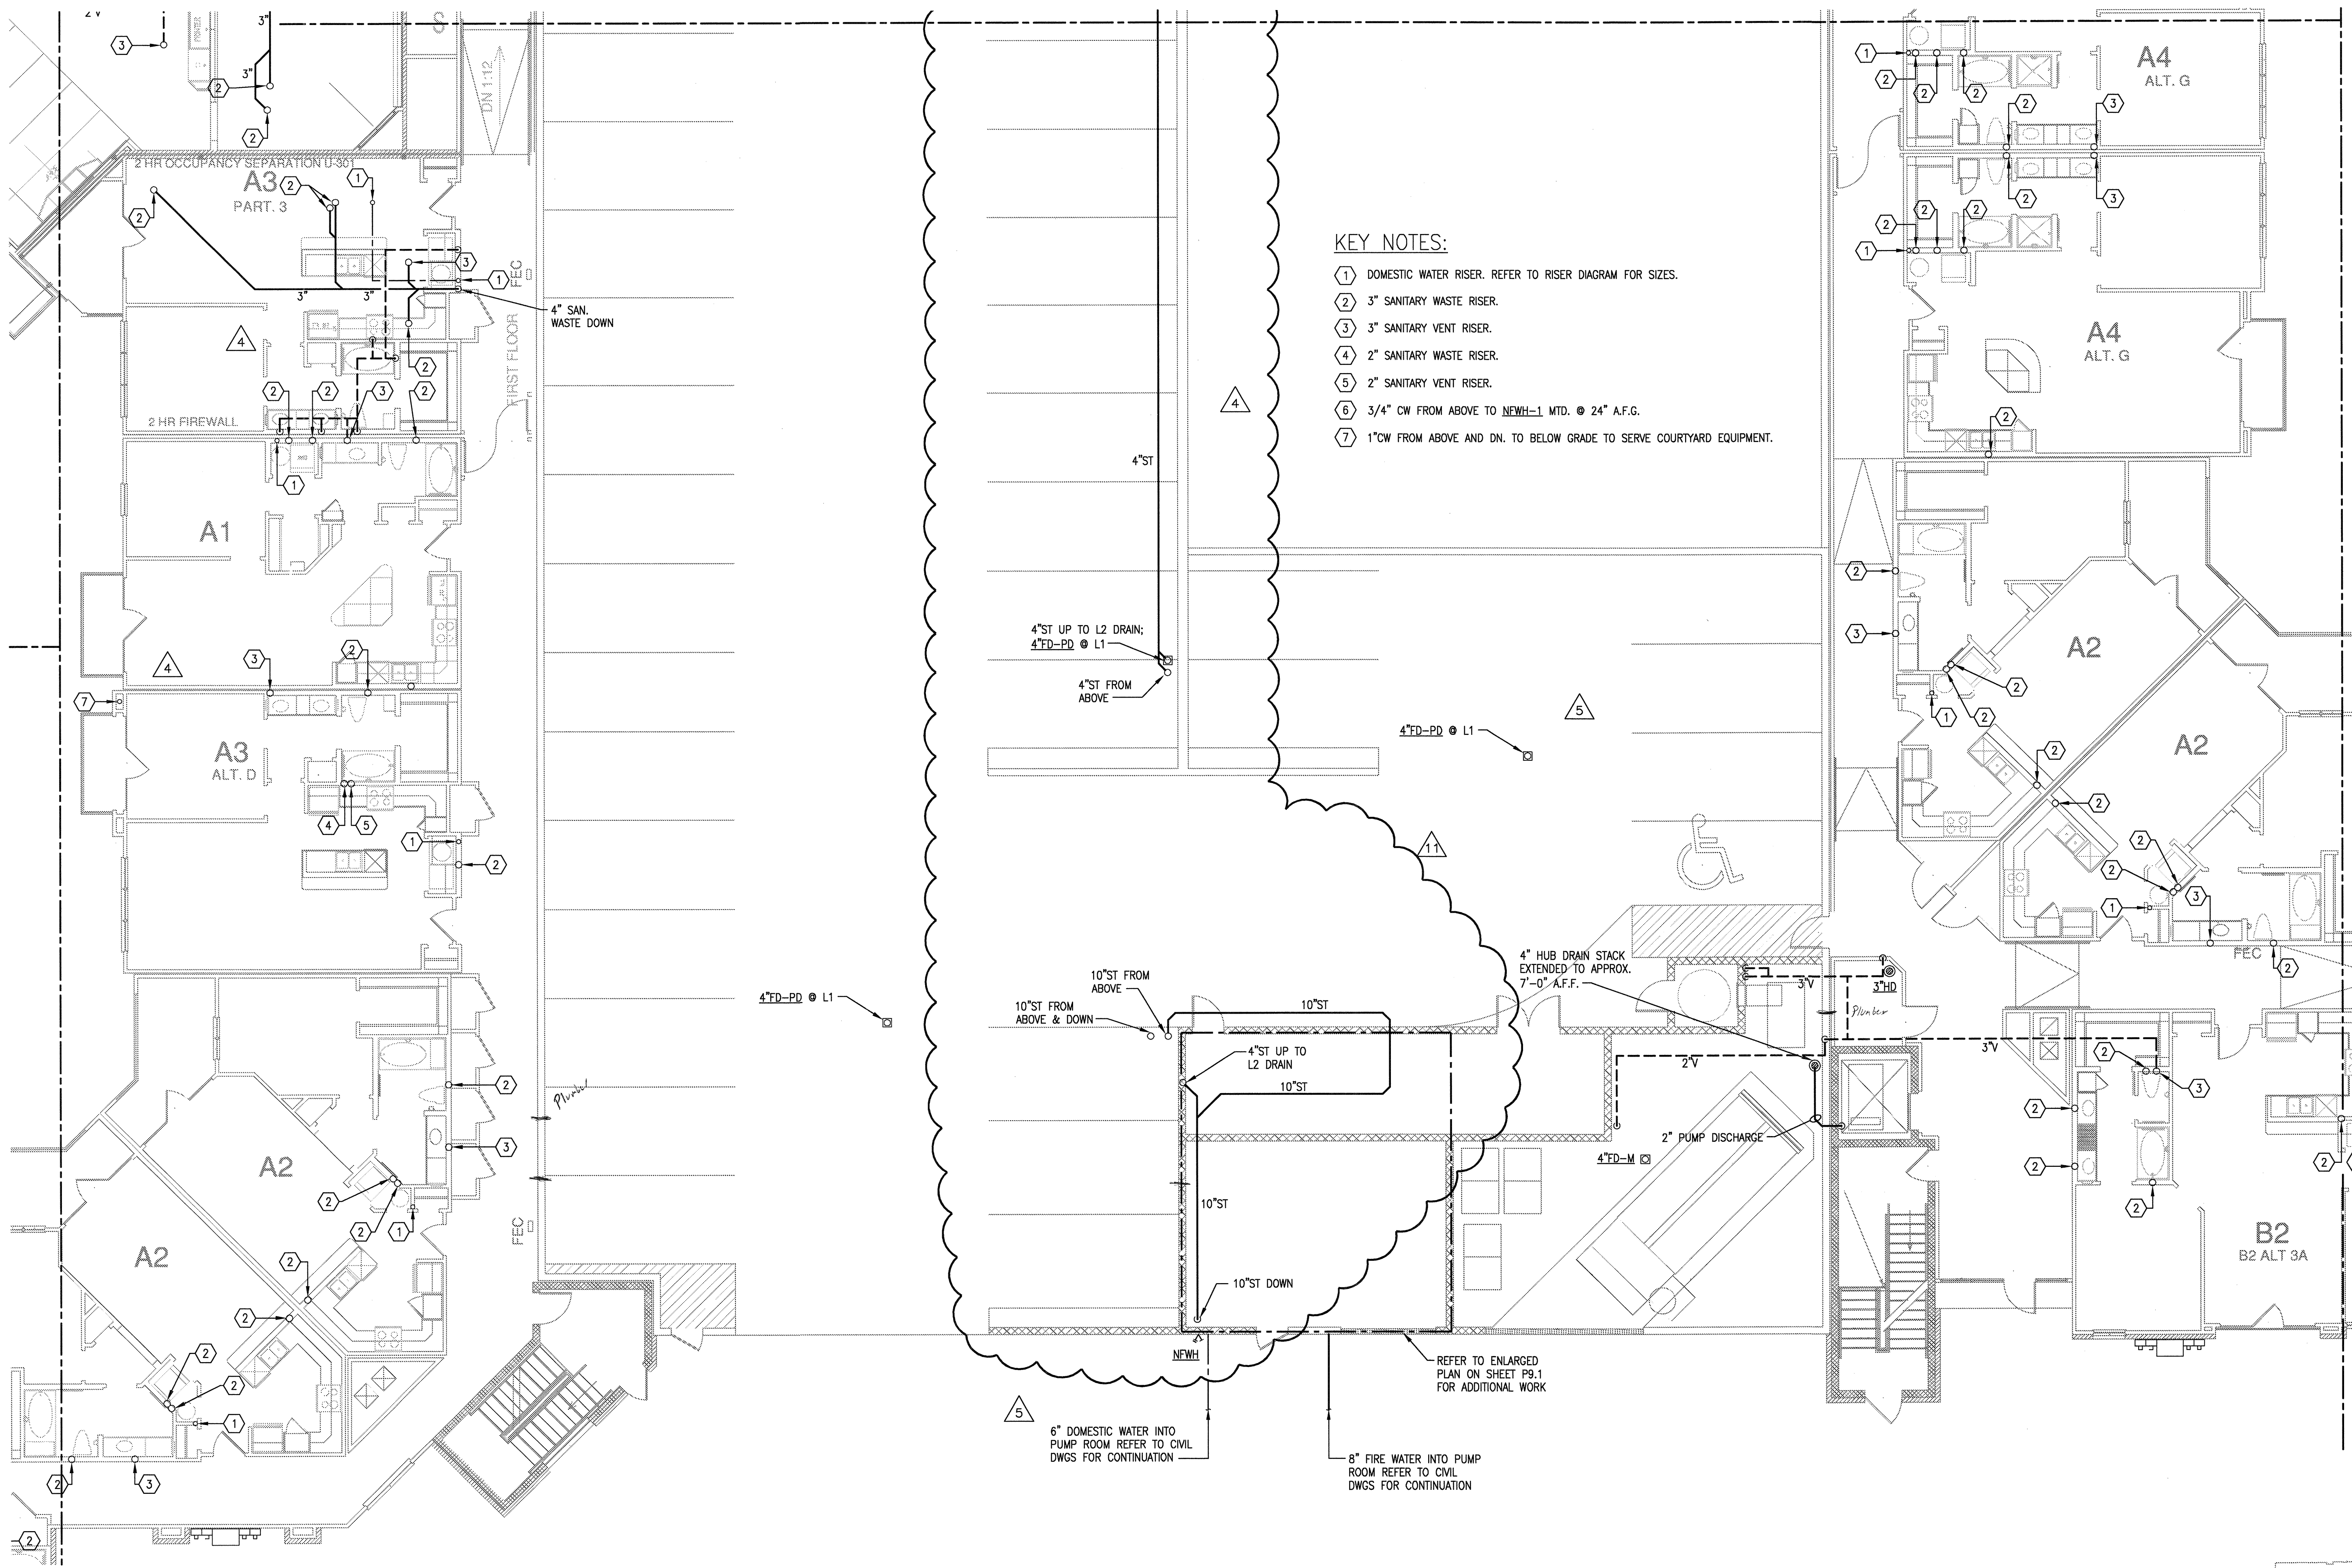

- KEY NOTES:**
- 1 DOMESTIC WATER RISER. REFER TO RISER DIAGRAM FOR SIZES.
 - 2 3" SANITARY WASTE RISER.
 - 3 3" SANITARY VENT RISER.
 - 4 2" SANITARY WASTE RISER.
 - 5 2" SANITARY VENT RISER.
 - 6 3/4" CW FROM ABOVE TO NEWH-1 MTD. @ 24" A.F.G.
 - 7 1" CW FROM ABOVE AND DN. TO BELOW GRADE TO SERVE COURTYARD EQUIPMENT.

1 DIVISION 'D' FIRST FLOOR PLAN
 SCALE: 1/8" = 1'-0"

