

REVISIONS

- △ 9-2-2011 DESIGN REVISIONS
- △ 9-13-2011 ANSI/FHA COMMENTS
- △ 9-23-2011 DESIGN REVISIONS
- △ 10-17-2011 CONSTRUCTION ISSUE
- △ 12-21-2011 DESIGN REVISIONS

KELLER SPRINGS LOFTS

LOFT APARTMENTS IN ADDISON, TEXAS




4144 N. Central Expy.
Suite 855
Dallas, TX 75204
214.520.8878
bgoarchitects.com

DATE
08-05-11

PROJECT
11129

SHEET NUMBER

P-3.2C

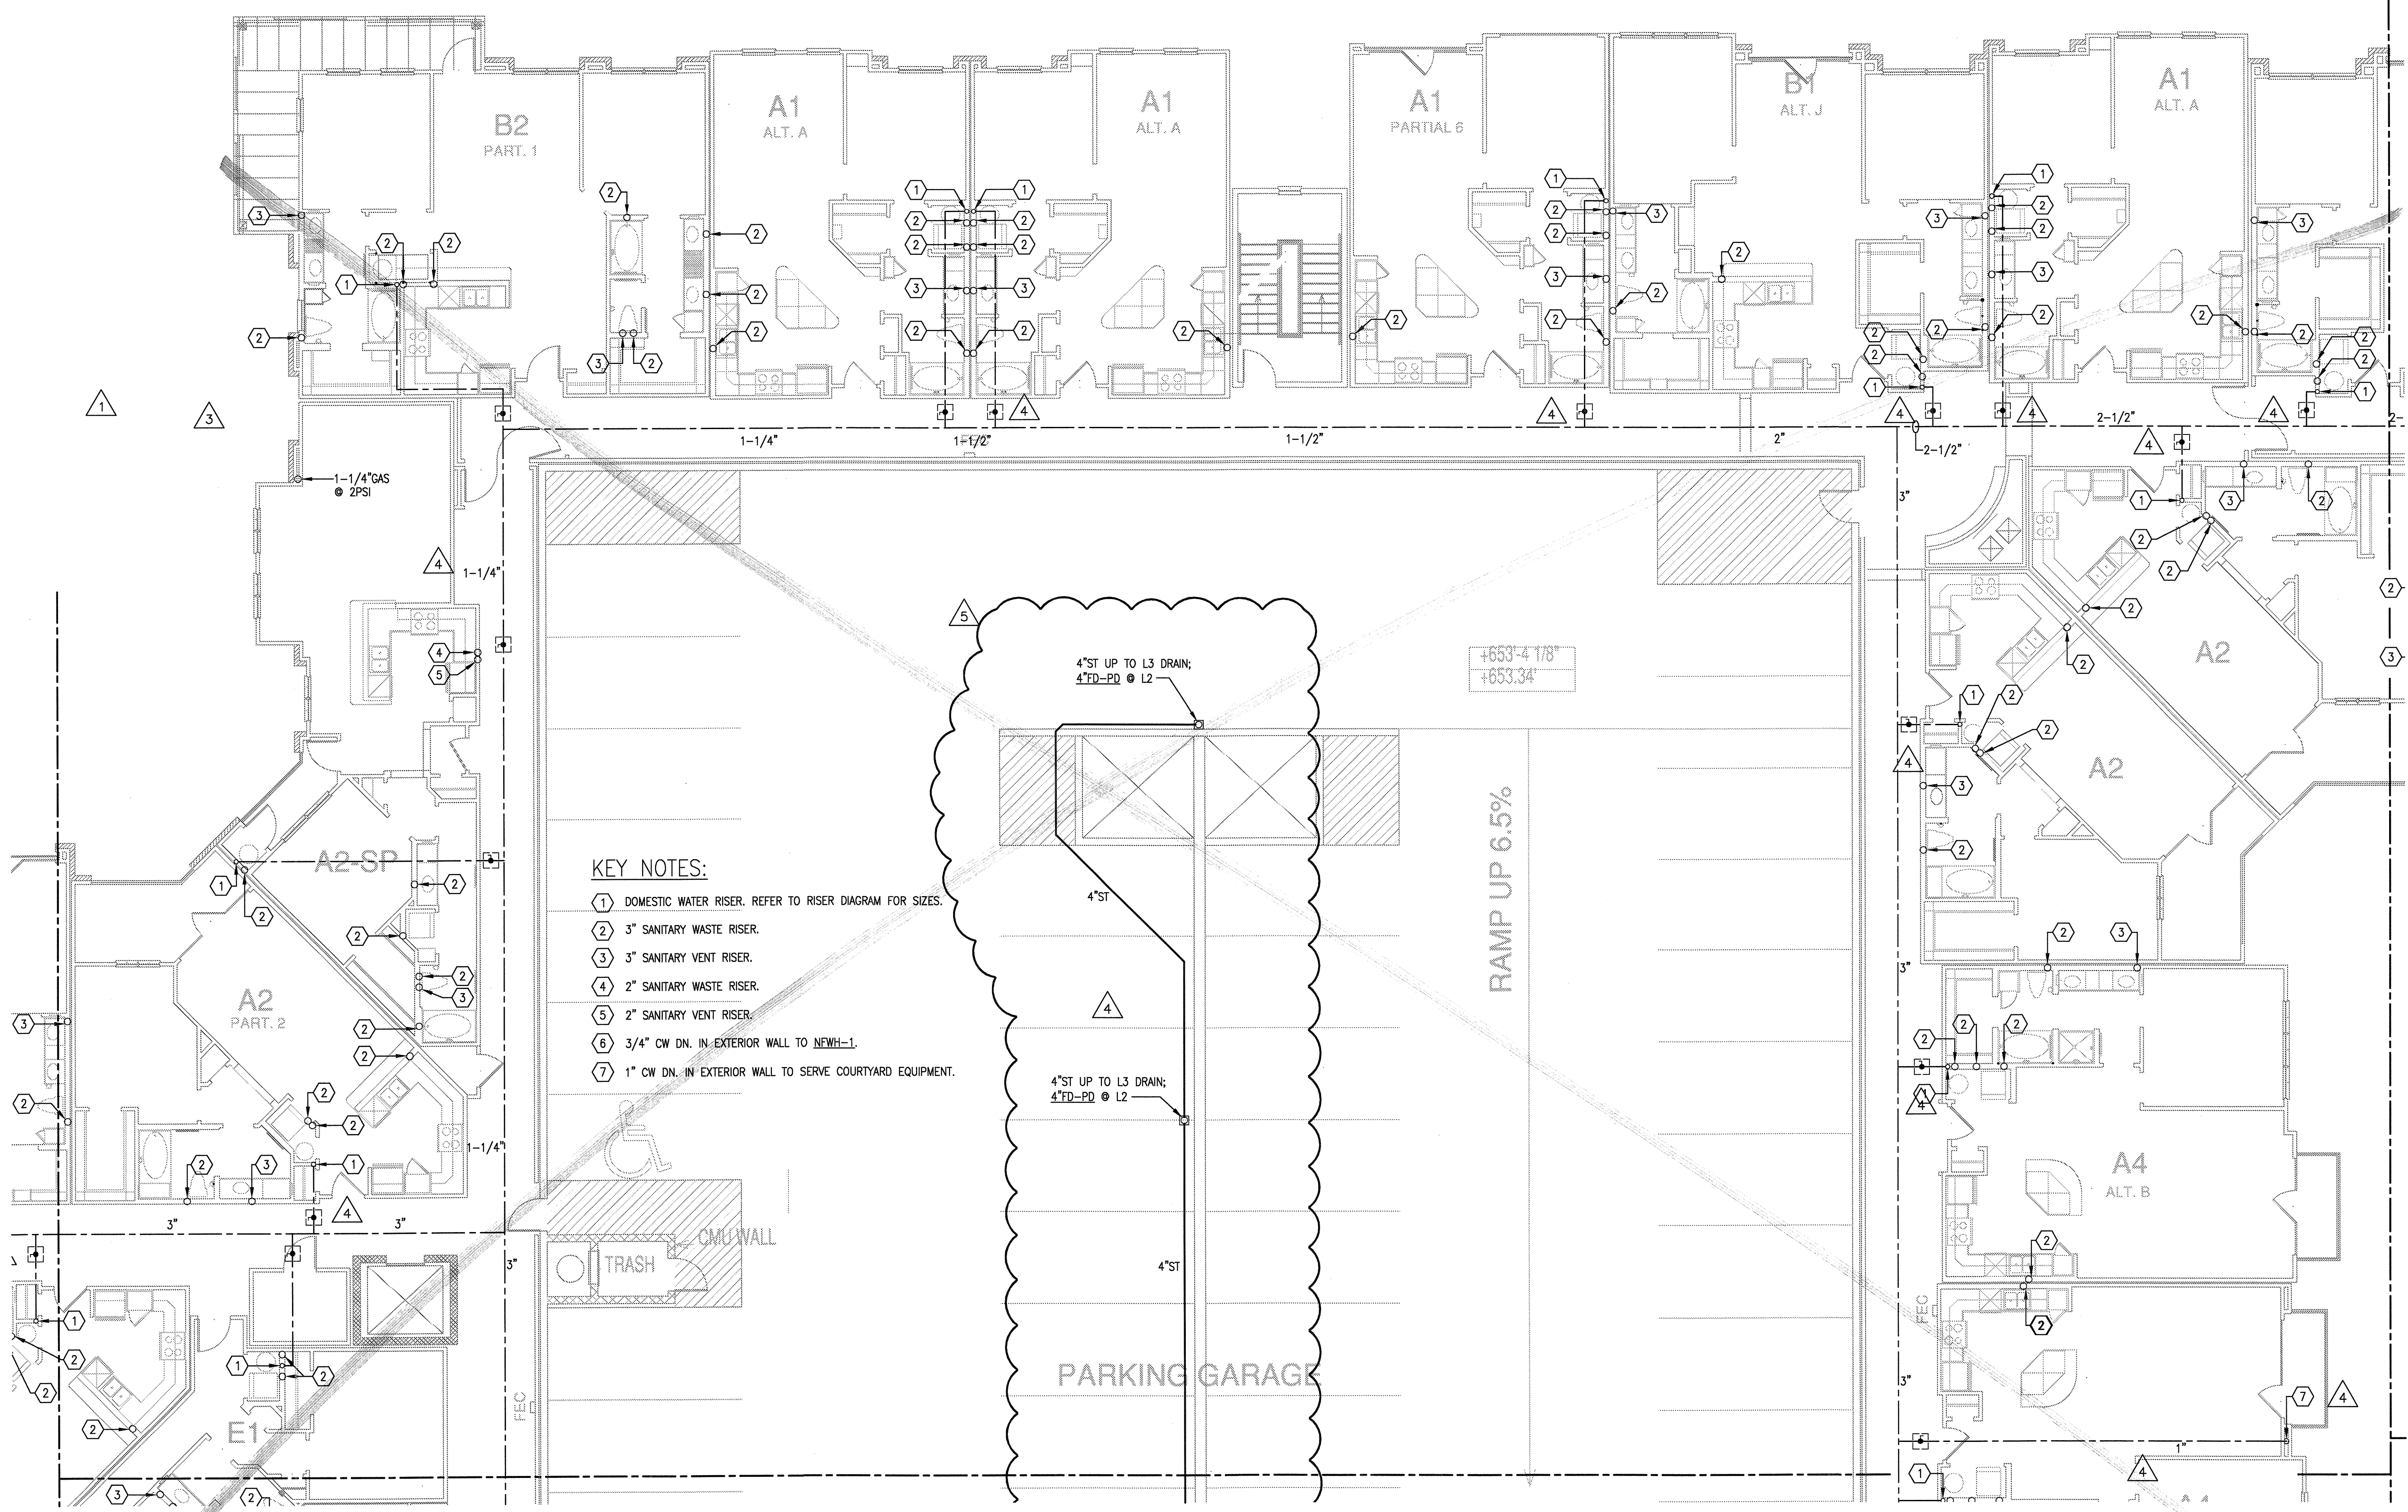

- KEY NOTES:**
- ① DOMESTIC WATER RISER. REFER TO RISER DIAGRAM FOR SIZES.
 - ② 3" SANITARY WASTE RISER.
 - ③ 3" SANITARY VENT RISER.
 - ④ 2" SANITARY WASTE RISER.
 - ⑤ 2" SANITARY VENT RISER.
 - ⑥ 3/4" CW DN. IN EXTERIOR WALL TO NFWH-1.
 - ⑦ 1" CW DN. IN EXTERIOR WALL TO SERVE COURTYARD EQUIPMENT.

1 DIVISION 'C' SECOND FLOOR PLAN
SCALE: 1/8" = 1'-0"