

REVISIONS

1	9-2-2011	DESIGN REVISIONS
2	9-13-2011	ANSI/FHA COMMENTS
3	9-23-2011	DESIGN REVISIONS
4	10-17-2011	CONSTRUCTION ISSUE
5	12-21-2011	DESIGN REVISIONS

KELLER SPRINGS LOFTS

LOFT APARTMENTS IN ADDISON, TEXAS




4144 N. Central Expy.
Suite 855
Dallas, TX 75204
214.520.8878
bgoarchitects.com

DATE
08-05-11

PROJECT
11129

SHEET NUMBER
P-3.2C

JSE Jordan & Skala Engineers
14240 Midway Road, Suite 330
Dallas, TX 75244-3138
V: (469) 385-1616 F: (469) 385-1615
Project Number - 113-0355 Texas Firm Registration # F-4990
Drawn By: CV Checked By: RC

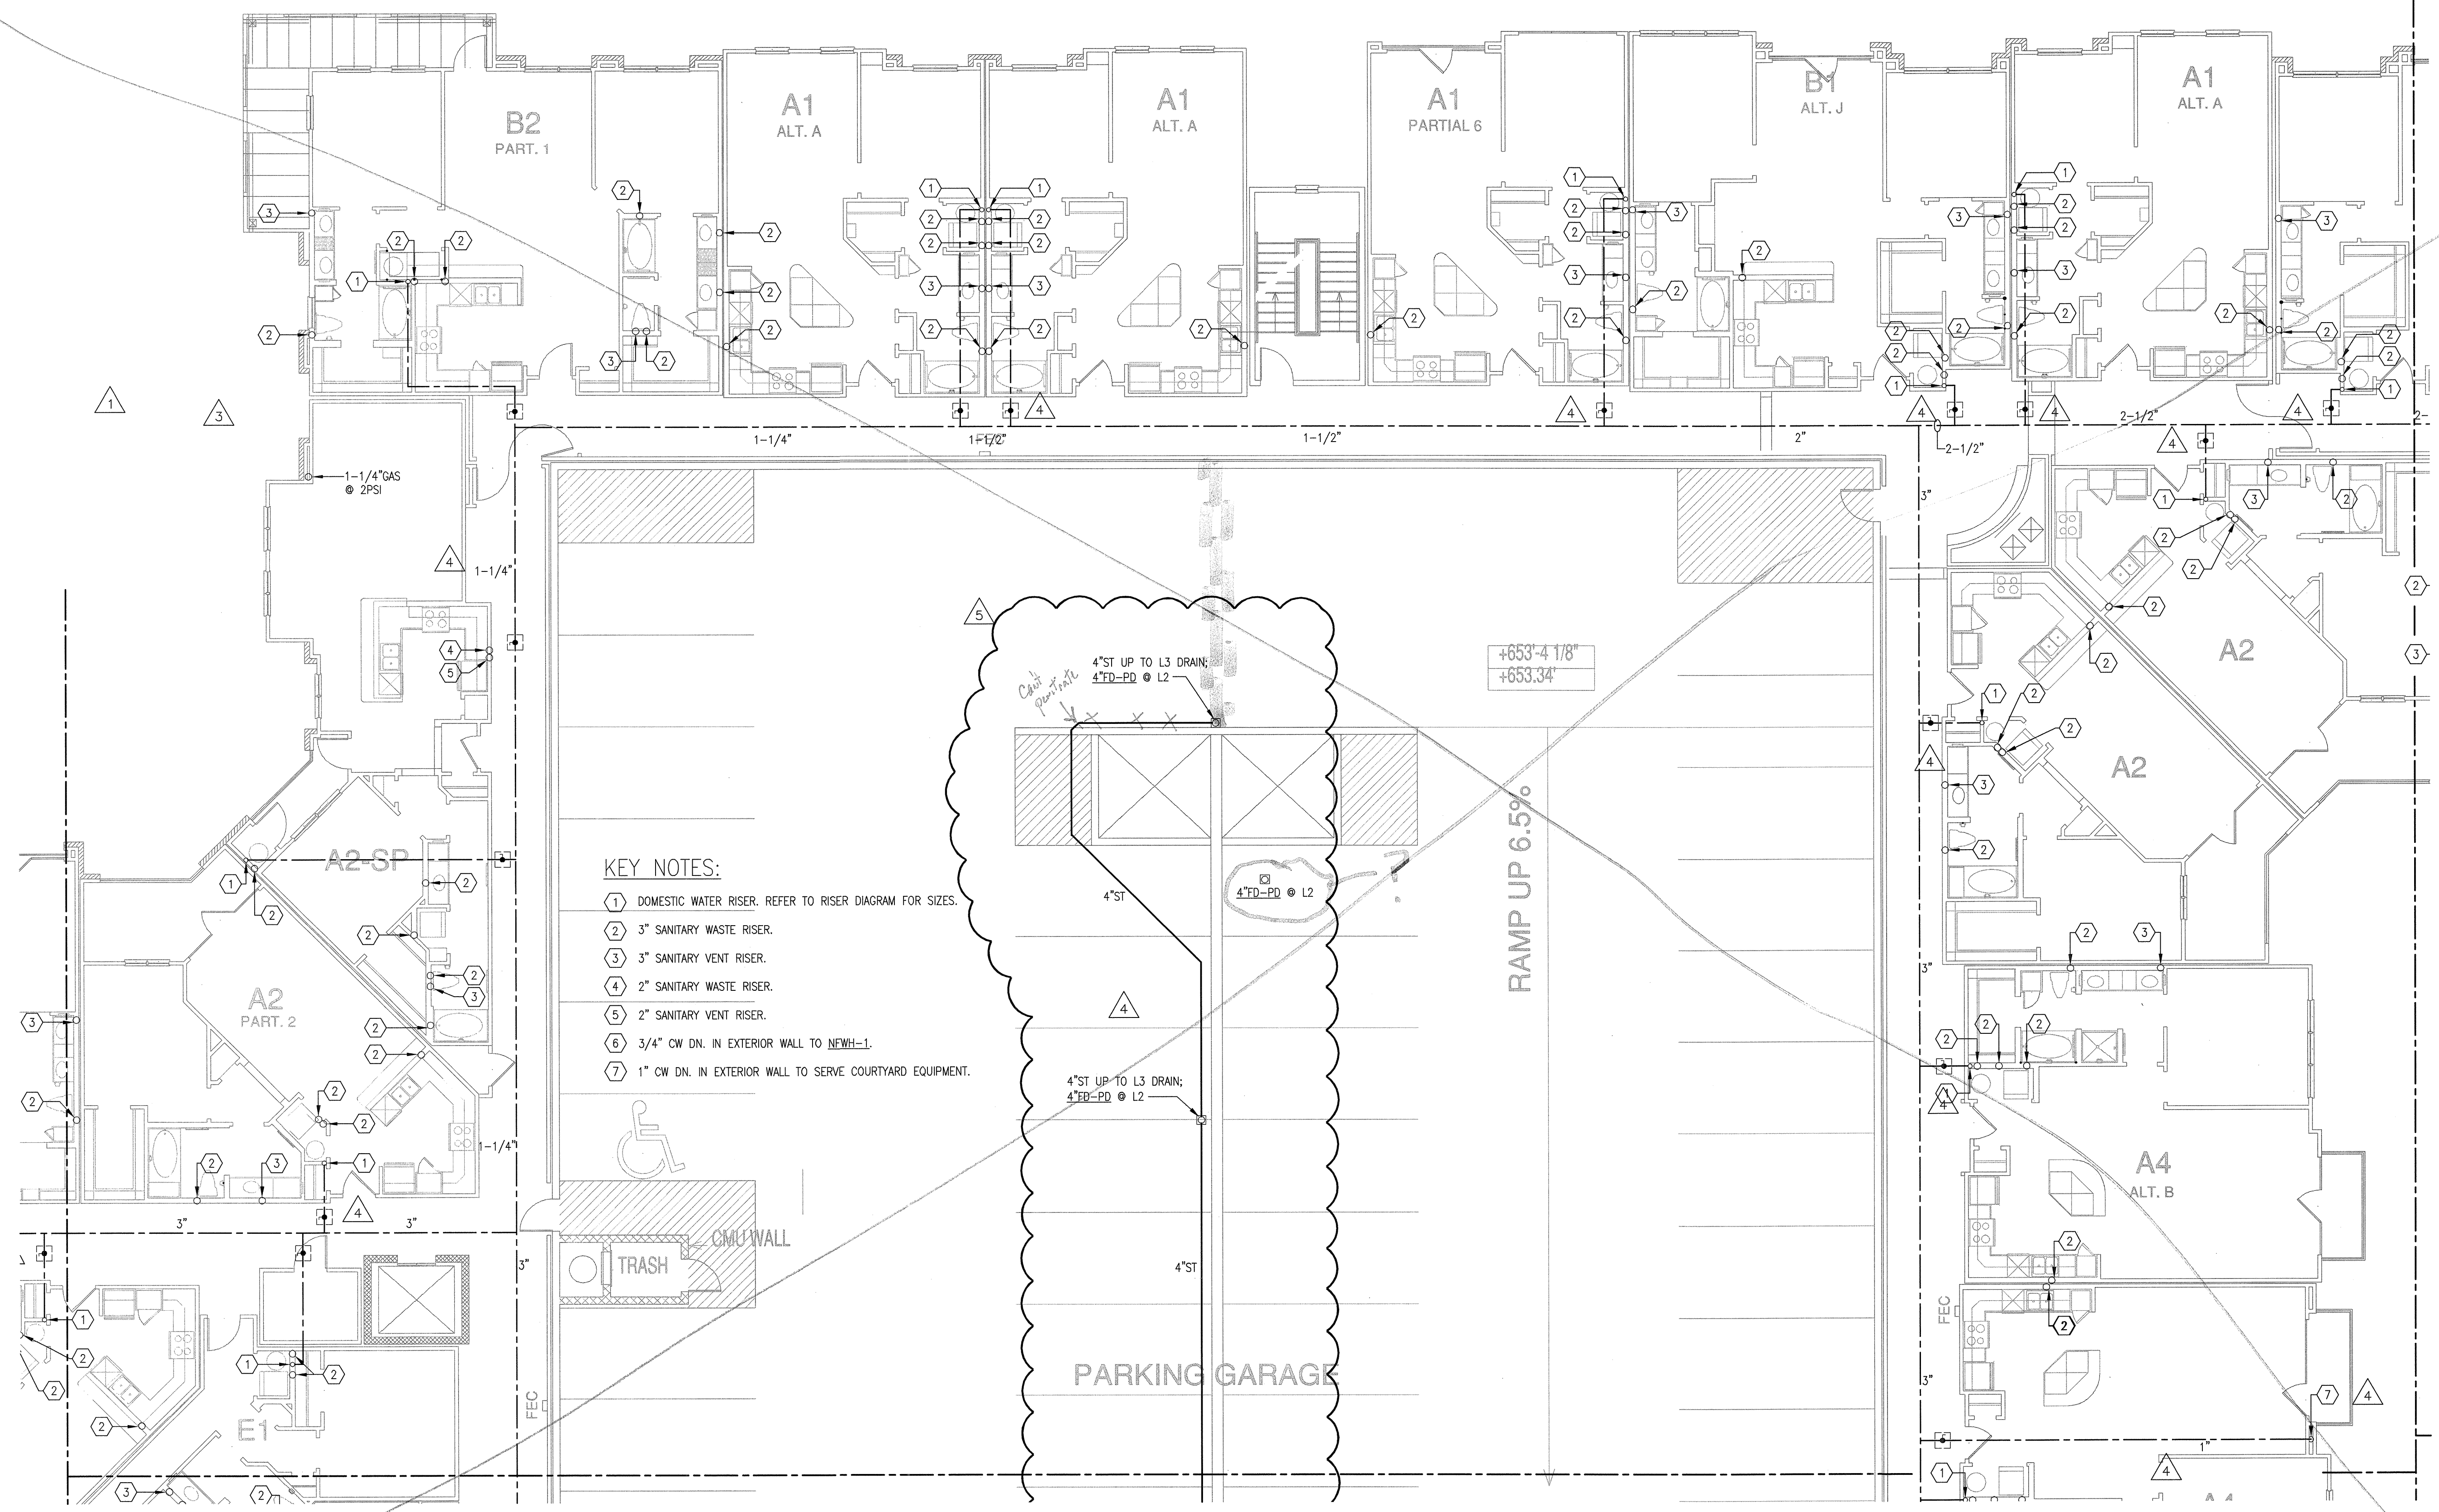

- KEY NOTES:
- 1 DOMESTIC WATER RISER. REFER TO RISER DIAGRAM FOR SIZES.
 - 2 3" SANITARY WASTE RISER.
 - 3 3" SANITARY VENT RISER.
 - 4 2" SANITARY WASTE RISER.
 - 5 2" SANITARY VENT RISER.
 - 6 3/4" CW DN. IN EXTERIOR WALL TO NEWH-1.
 - 7 1" CW DN. IN EXTERIOR WALL TO SERVE COURTYARD EQUIPMENT.

1 DIVISION 'C' SECOND FLOOR PLAN
SCALE: 1/8" = 1'-0"