

REVISIONS		
△ 9-2-2011	DESIGN REVISIONS	
△ 9-13-2011	ANSI/FHA COMMENTS	
△ 9-23-2011	DESIGN REVISIONS	
△ 10-17-2011	CONSTRUCTION ISSUE	
△ 12-21-2011	DESIGN REVISIONS	

KELLER SPRINGS LOFTS

LOFT APARTMENTS IN ADDISON, TEXAS



4144 N. Central Expy.
Suite 855
Dallas, TX 75204
214.520.8878
bgoarchitects.com


DATE
08-05-11

PROJECT
11129

SHEET NUMBER

P-3.2D

JSE Jordan & Skala Engineers
14240 Midway Road, Suite 330
Dallas, TX 75244-5138
V: (469) 385-1676 F: (469) 385-1615
Project Number - 113-0355 Texas Firm Registration # F-4990
Drawn By: CV Checked By: RC

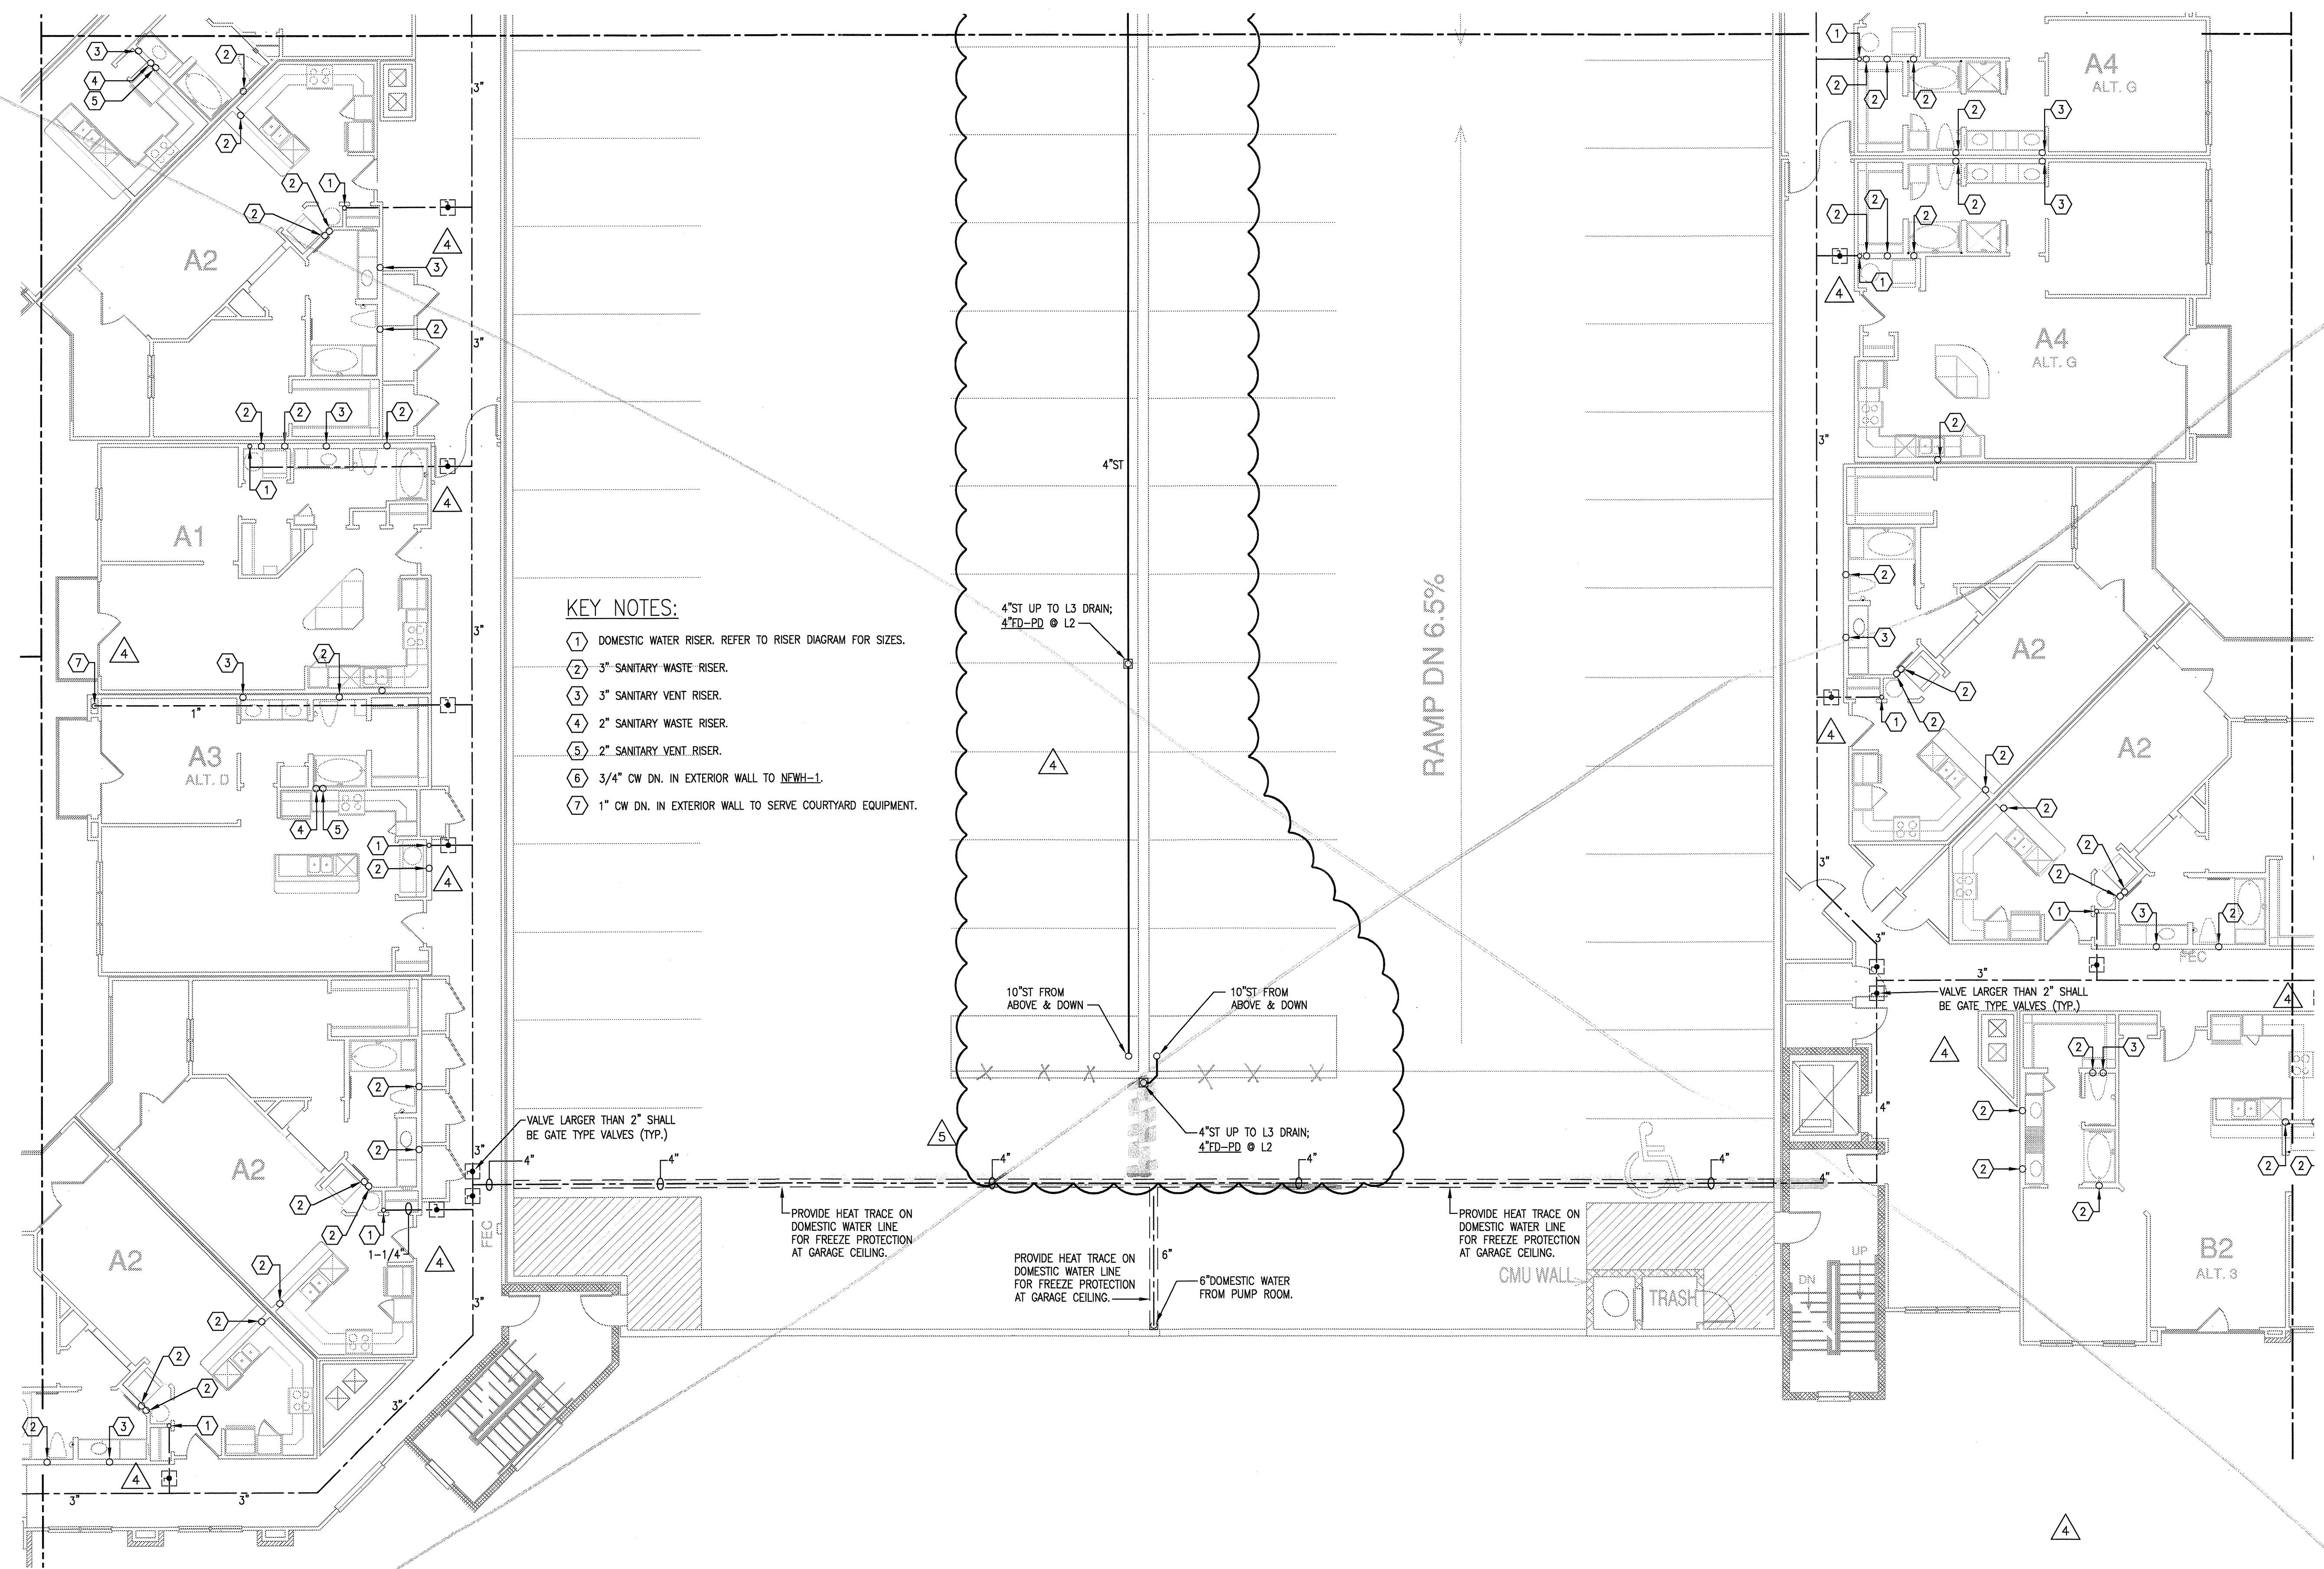

- KEY NOTES:**
- ① DOMESTIC WATER RISER. REFER TO RISER DIAGRAM FOR SIZES.
 - ② 3" SANITARY WASTE RISER.
 - ③ 3" SANITARY VENT RISER.
 - ④ 2" SANITARY WASTE RISER.
 - ⑤ 2" SANITARY VENT RISER.
 - ⑥ 3/4" CW DN. IN EXTERIOR WALL TO NEWH-1.
 - ⑦ 1" CW DN. IN EXTERIOR WALL TO SERVE COURTYARD EQUIPMENT.

1 DIVISION 'D' SECOND FLOOR PLAN
SCALE: 1/8" = 1'-0"

