

- KEY NOTES:**
- ① DOMESTIC WATER RISER. REFER TO RISER DIAGRAM FOR SIZES.
 - ② 3" SANITARY WASTE RISER.
 - ③ 3" SANITARY VENT RISER.
 - ④ 2" SANITARY WASTE RISER.
 - ⑤ 2" SANITARY VENT RISER.
 - ⑥ 3/4" CW DN. IN EXTERIOR WALL TO NEWH-1.
 - ⑦ 1" CW DN. IN EXTERIOR WALL TO SERVE COURTYARD EQUIPMENT.

VALVE LARGER THAN 2" SHALL BE GATE TYPE VALVES (TYP.)

PROVIDE HEAT TRACE ON DOMESTIC WATER LINE FOR FREEZE PROTECTION AT GARAGE CEILING.

PROVIDE HEAT TRACE ON DOMESTIC WATER LINE FOR FREEZE PROTECTION AT GARAGE CEILING.

PROVIDE HEAT TRACE ON DOMESTIC WATER LINE FOR FREEZE PROTECTION AT GARAGE CEILING.

VALVE LARGER THAN 2" SHALL BE GATE TYPE VALVES (TYP.)


4"ST UP TO L3 DRAIN;
4"FD-PD @ L2

4"ST FROM ABOVE & DOWN

10"ST FROM ABOVE & DOWN

4"ST UP TO L3 DRAIN;
4"FD-PD @ L2

RAMP DN 6.5%

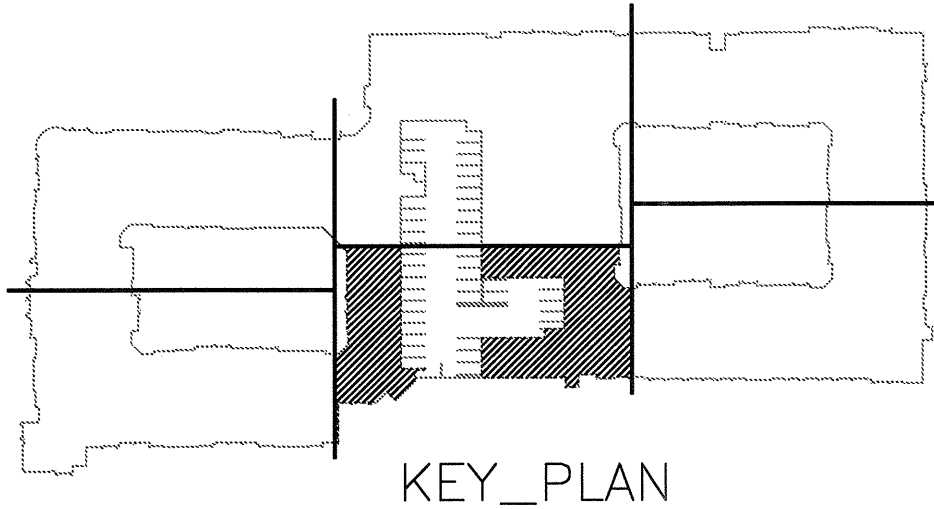

1 DIVISION 'D' SECOND FLOOR PLAN
SCALE: 1/8" = 1'-0"



REVISIONS		
①	9-2-2011	DESIGN REVISIONS
②	9-13-2011	ANSI/FHA COMMENTS
③	9-23-2011	DESIGN REVISIONS
④	10-17-2011	CONSTRUCTION ISSUE
⑤	12-21-2011	DESIGN REVISIONS
⑥	1-17-2012	DESIGN REVISIONS
⑦	2-15-2012	TRANSFORMER REVISIONS
⑧	3-27-2012	CLUBHOUSE REVISIONS
⑨	4-17-2012	COORDINATION

KELLER SPRINGS LOFTS
LOFT APARTMENTS IN ADDISON, TEXAS

⑩	5-15-2012	COORDINATION
⑪	5-30-2012	SITE COORDINATION



4144 N. Central Expy.
Suite 855
Dallas, TX 75204
214.520.8878
bgoarchitects.com

DATE
08-05-11

PROJECT
11129

SHEET NUMBER
P-3.2D

JSE Jordan & Skala Engineers
17850 N. Dallas Parkway, Suite 320
Dallas, TX 75287-6857
V: 469.385.1616 Web: www.jordanskala.com
Project Number - 113-0355 Texas Firm Registration # F-4990
Drawn By: CV Checked By: RC