



REVISIONS

1	9-2-2011	DESIGN REVISIONS
2	9-13-2011	ANSI/FHA COMMENTS
3	9-23-2011	DESIGN REVISIONS
4	10-17-2011	CONSTRUCTION ISSUE
5	12-21-2011	DESIGN REVISIONS


**KELLER SPRINGS LOFTS**  
 LOFT APARTMENTS IN ADDISON, TEXAS

**BGO architects**  
 4144 N. Central Expy.  
 Suite 855  
 Dallas, TX 75204  
 214.520.8878  
 bgoarchitects.com


DATE  
 08-05-11

PROJECT  
 11129

SHEET NUMBER  
**P-3.3C**

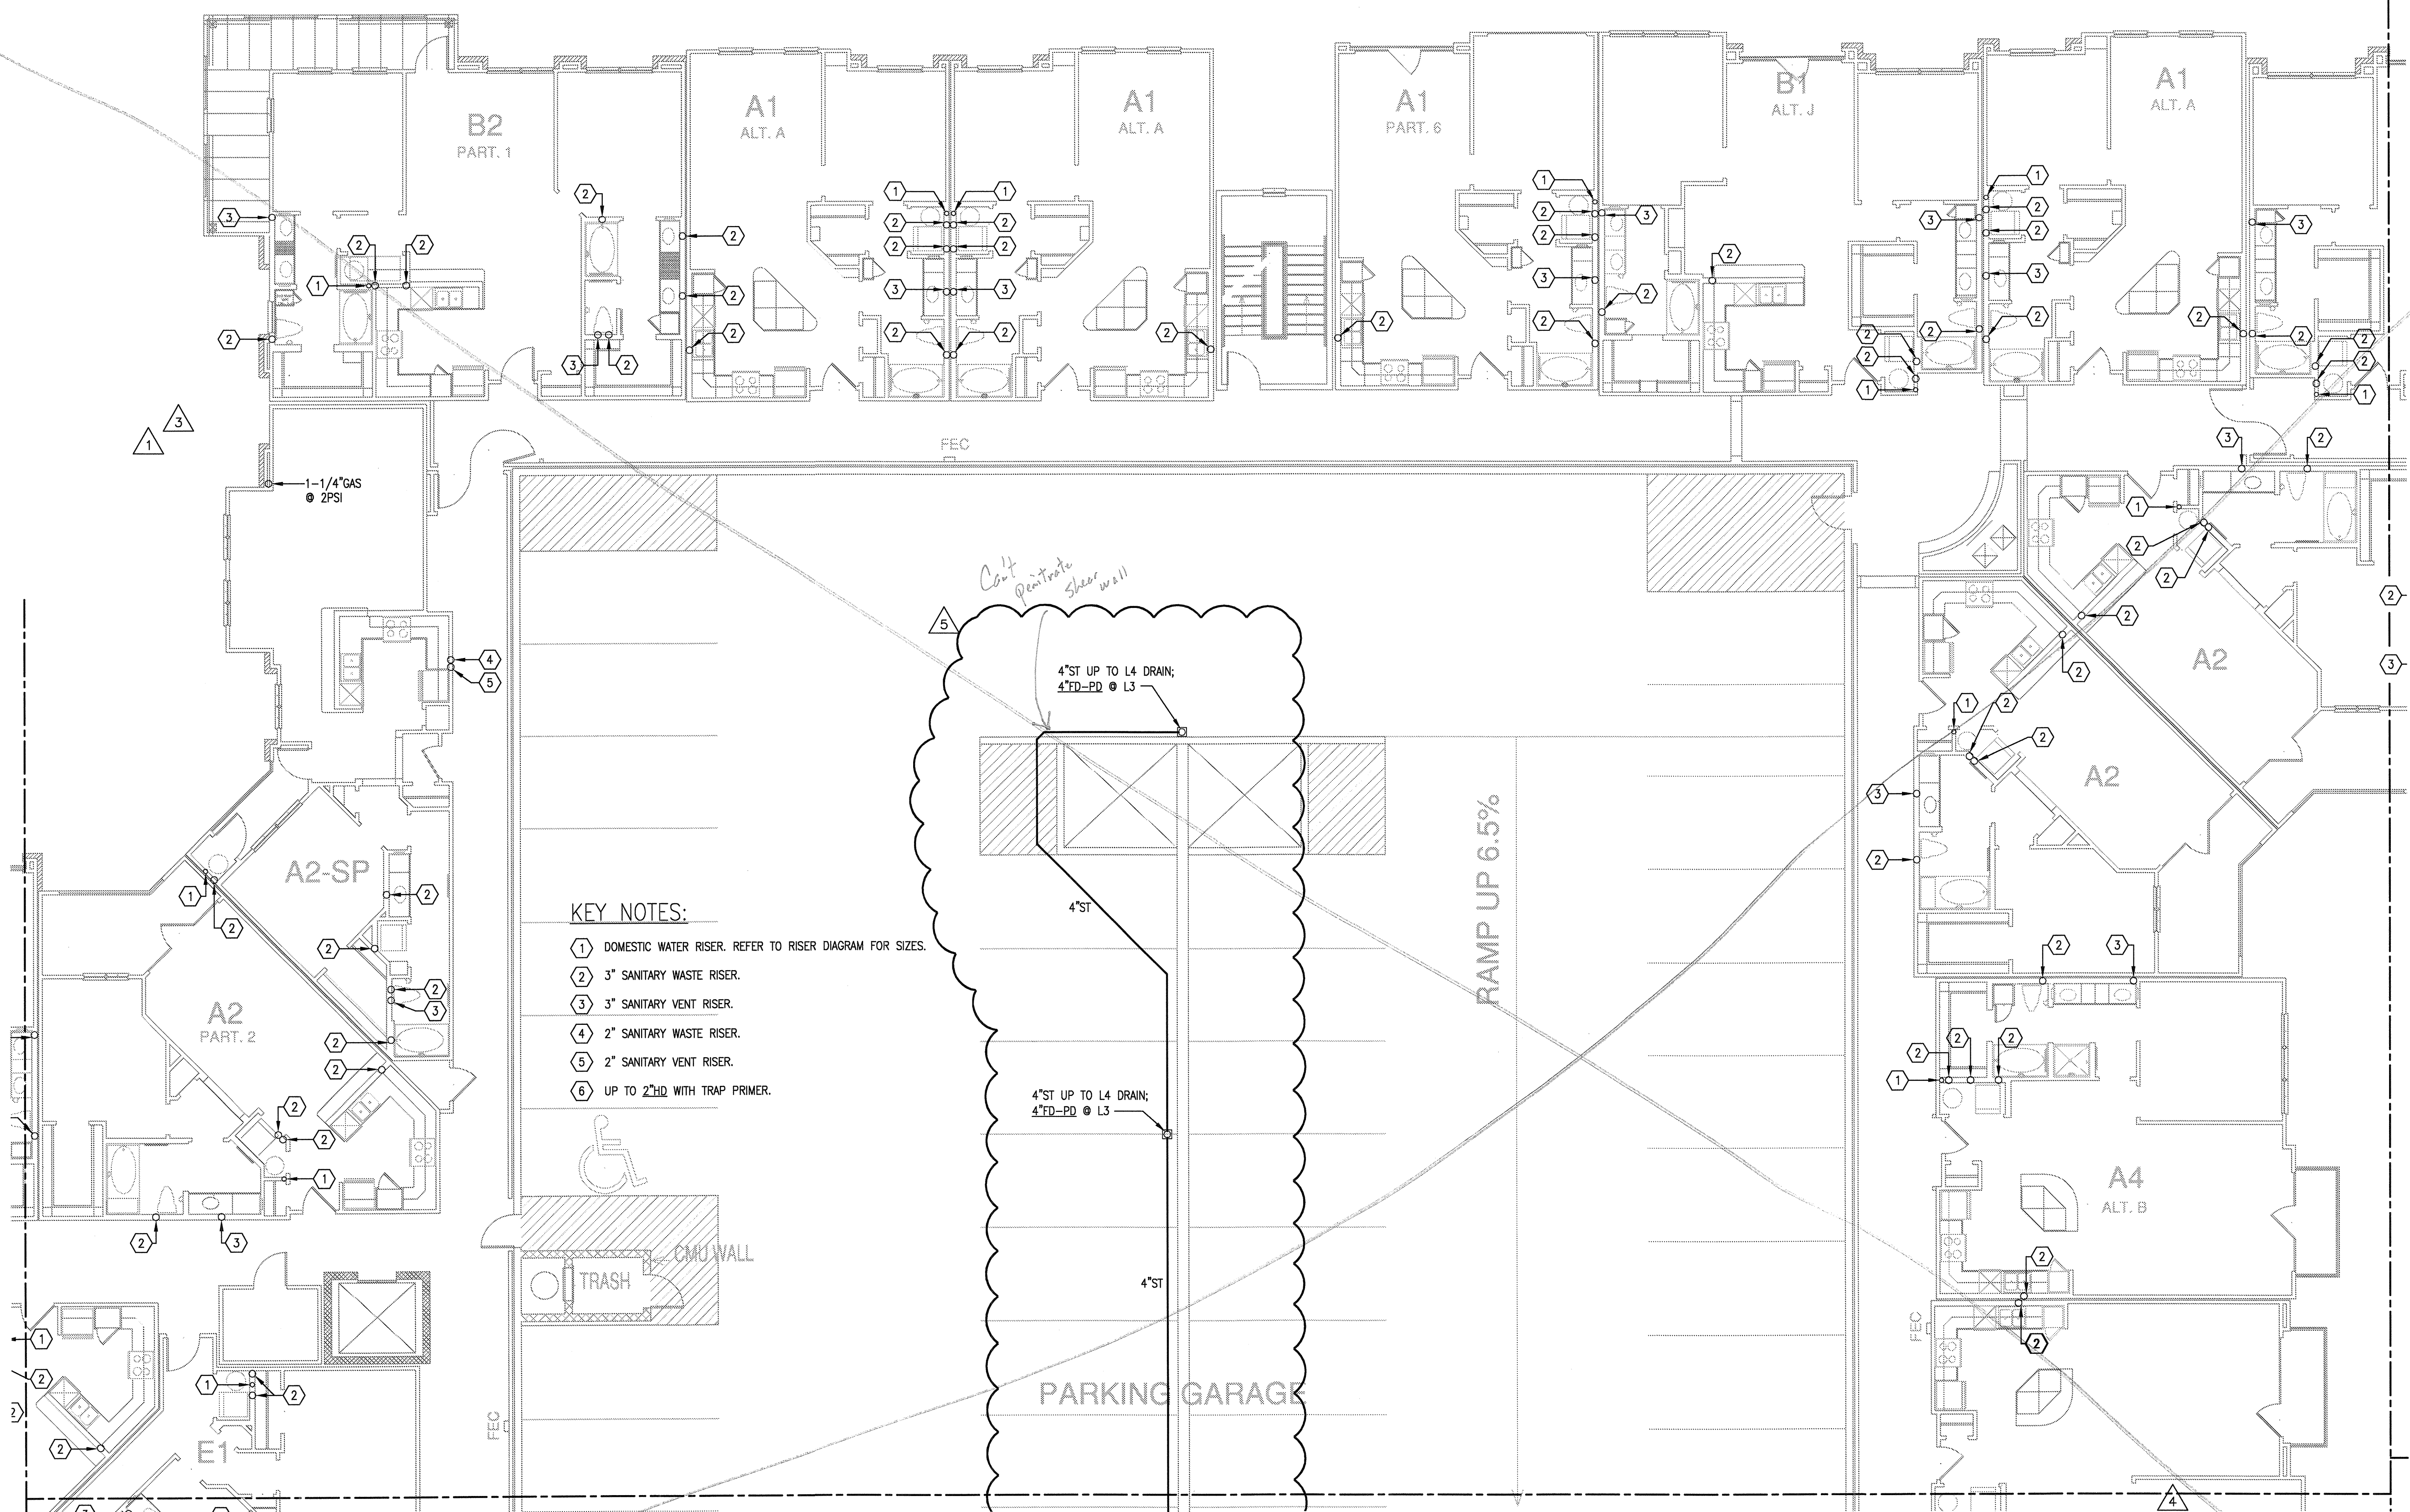

- KEY NOTES:**
- 1 DOMESTIC WATER RISER. REFER TO RISER DIAGRAM FOR SIZES.
  - 2 3" SANITARY WASTE RISER.
  - 3 3" SANITARY VENT RISER.
  - 4 2" SANITARY WASTE RISER.
  - 5 2" SANITARY VENT RISER.
  - 6 UP TO 2<sup>ND</sup> FLOOR WITH TRAP PRIMER.

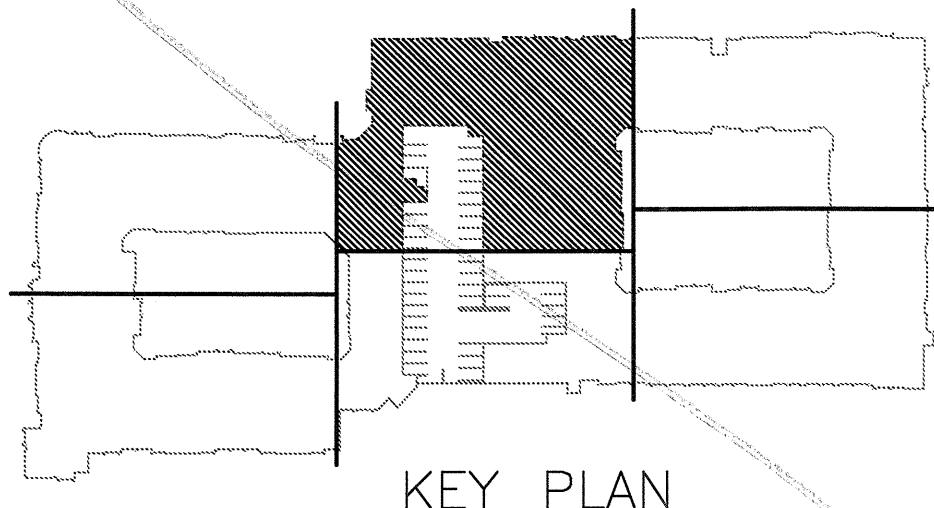

KEY\_PLAN

**JSE** Jordan & Skala Engineers  
 14240 Midway Road, Suite 330  
 Dallas, TX 75244-5138  
 V: (469) 385-1616 F: (469) 385-1615  
 Project Number - 113-0355 Texas Firm Registration # F-4990  
 Drawn By: CV Checked By: RC

1 DIVISION 'C' THIRD FLOOR PLAN  
 SCALE: 1/8" = 1'-0"