



REVISIONS		
△	9-2-2011	DESIGN REVISIONS
△	9-13-2011	ANSI/FHA COMMENTS
△	9-23-2011	DESIGN REVISIONS
△	10-17-2011	CONSTRUCTION ISSUE

KELLER SPRINGS LOFTS

LOFT APARTMENTS IN ADDISON, TEXAS

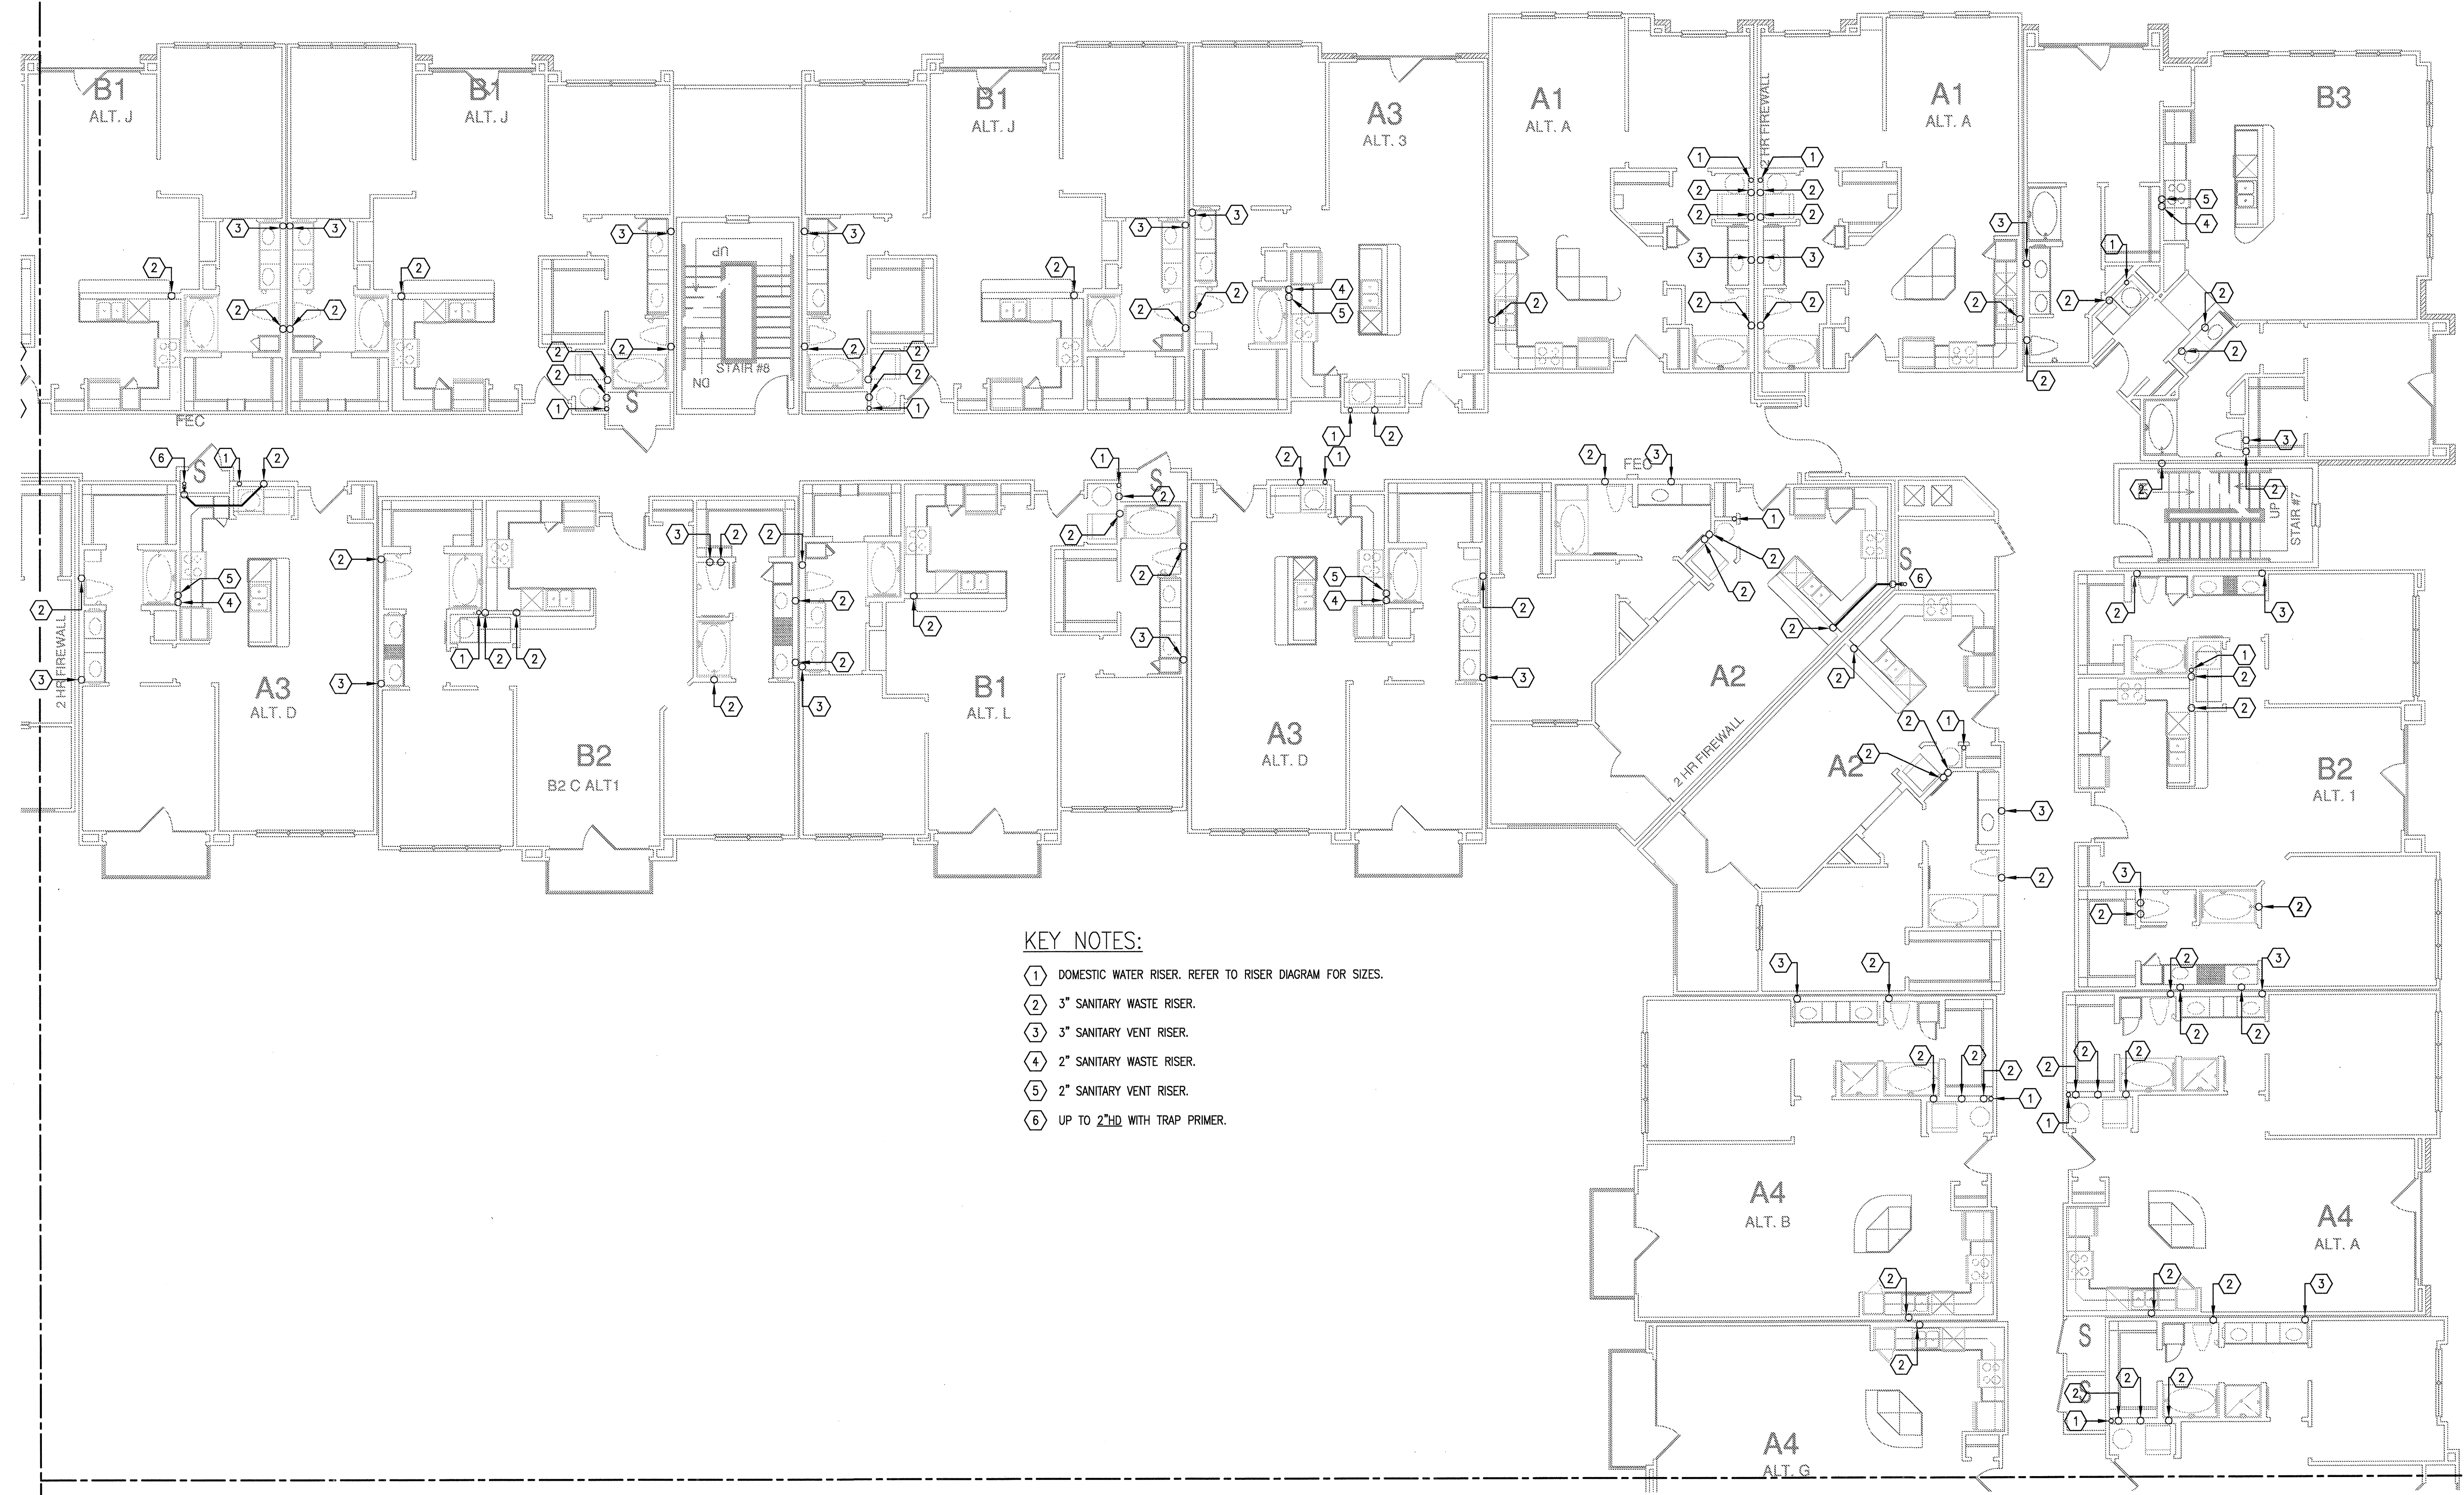

- KEY NOTES:**
- ① DOMESTIC WATER RISER. REFER TO RISER DIAGRAM FOR SIZES.
 - ② 3" SANITARY WASTE RISER.
 - ③ 3" SANITARY VENT RISER.
 - ④ 2" SANITARY WASTE RISER.
 - ⑤ 2" SANITARY VENT RISER.
 - ⑥ UP TO 2ND FLOOR WITH TRAP PRIMER.

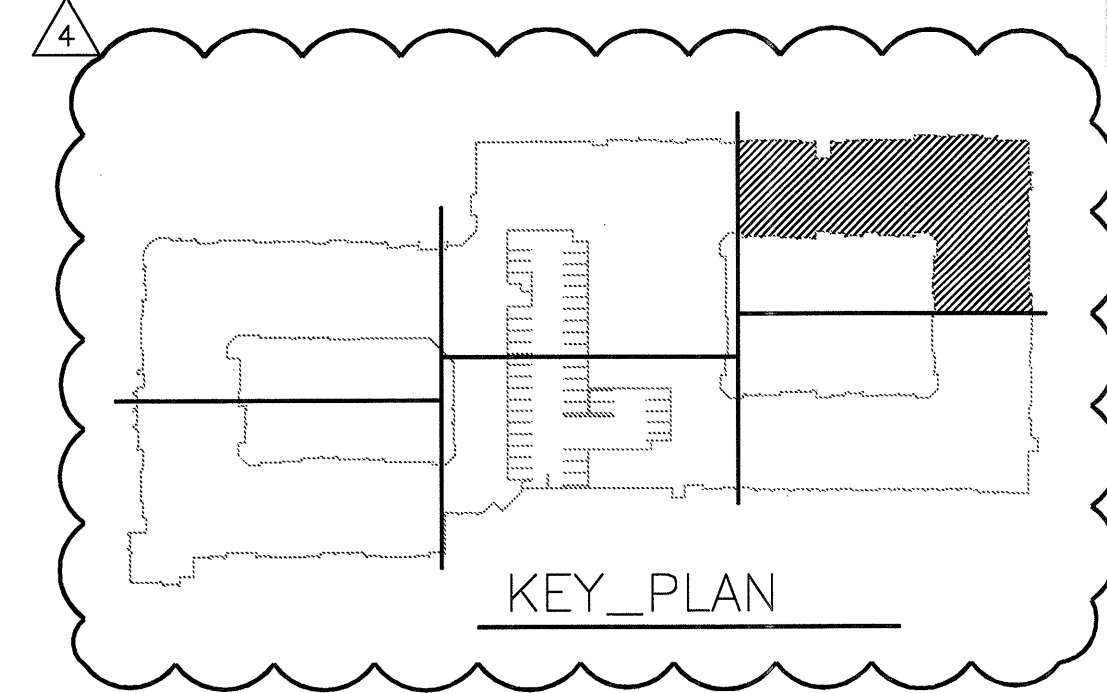

1 DIVISION 'E' THIRD FLOOR PLAN
SCALE: 1/8" = 1'-0"

BGO
architects
4144 N. Central Expy.
Suite 855
Dallas, TX 75204
214.520.8878
bgoarchitects.com

DATE
08-05-11

PROJECT
11129

SHEET NUMBER

P-3.3E

JSE Jordan & Skala Engineers
14240 Midway Road, Suite 330
Dallas, TX 75244-5138
Tel: (469) 383-1618, Fax: (469) 383-1615
Project Number - 113-0355 Texas Firm Registration # F-4990
Drawn By: CV Checked By: RC