

REVISIONS	
1	9-2-2011 DESIGN REVISIONS
2	9-13-2011 ANSI/FHA COMMENTS
3	9-23-2011 DESIGN REVISIONS
4	10-17-2011 CONSTRUCTION ISSUE

**KELLER SPRINGS LOFTS**

LOFT APARTMENTS IN ADDISON, TEXAS


**BGO**  
architects  
4144 N. Central Expy.  
Suite 855  
Dallas, TX 75204  
214.520.8878  
bgoarchitects.com

DATE  
08-05-11

PROJECT  
11129

SHEET NUMBER


**P-3.4B**

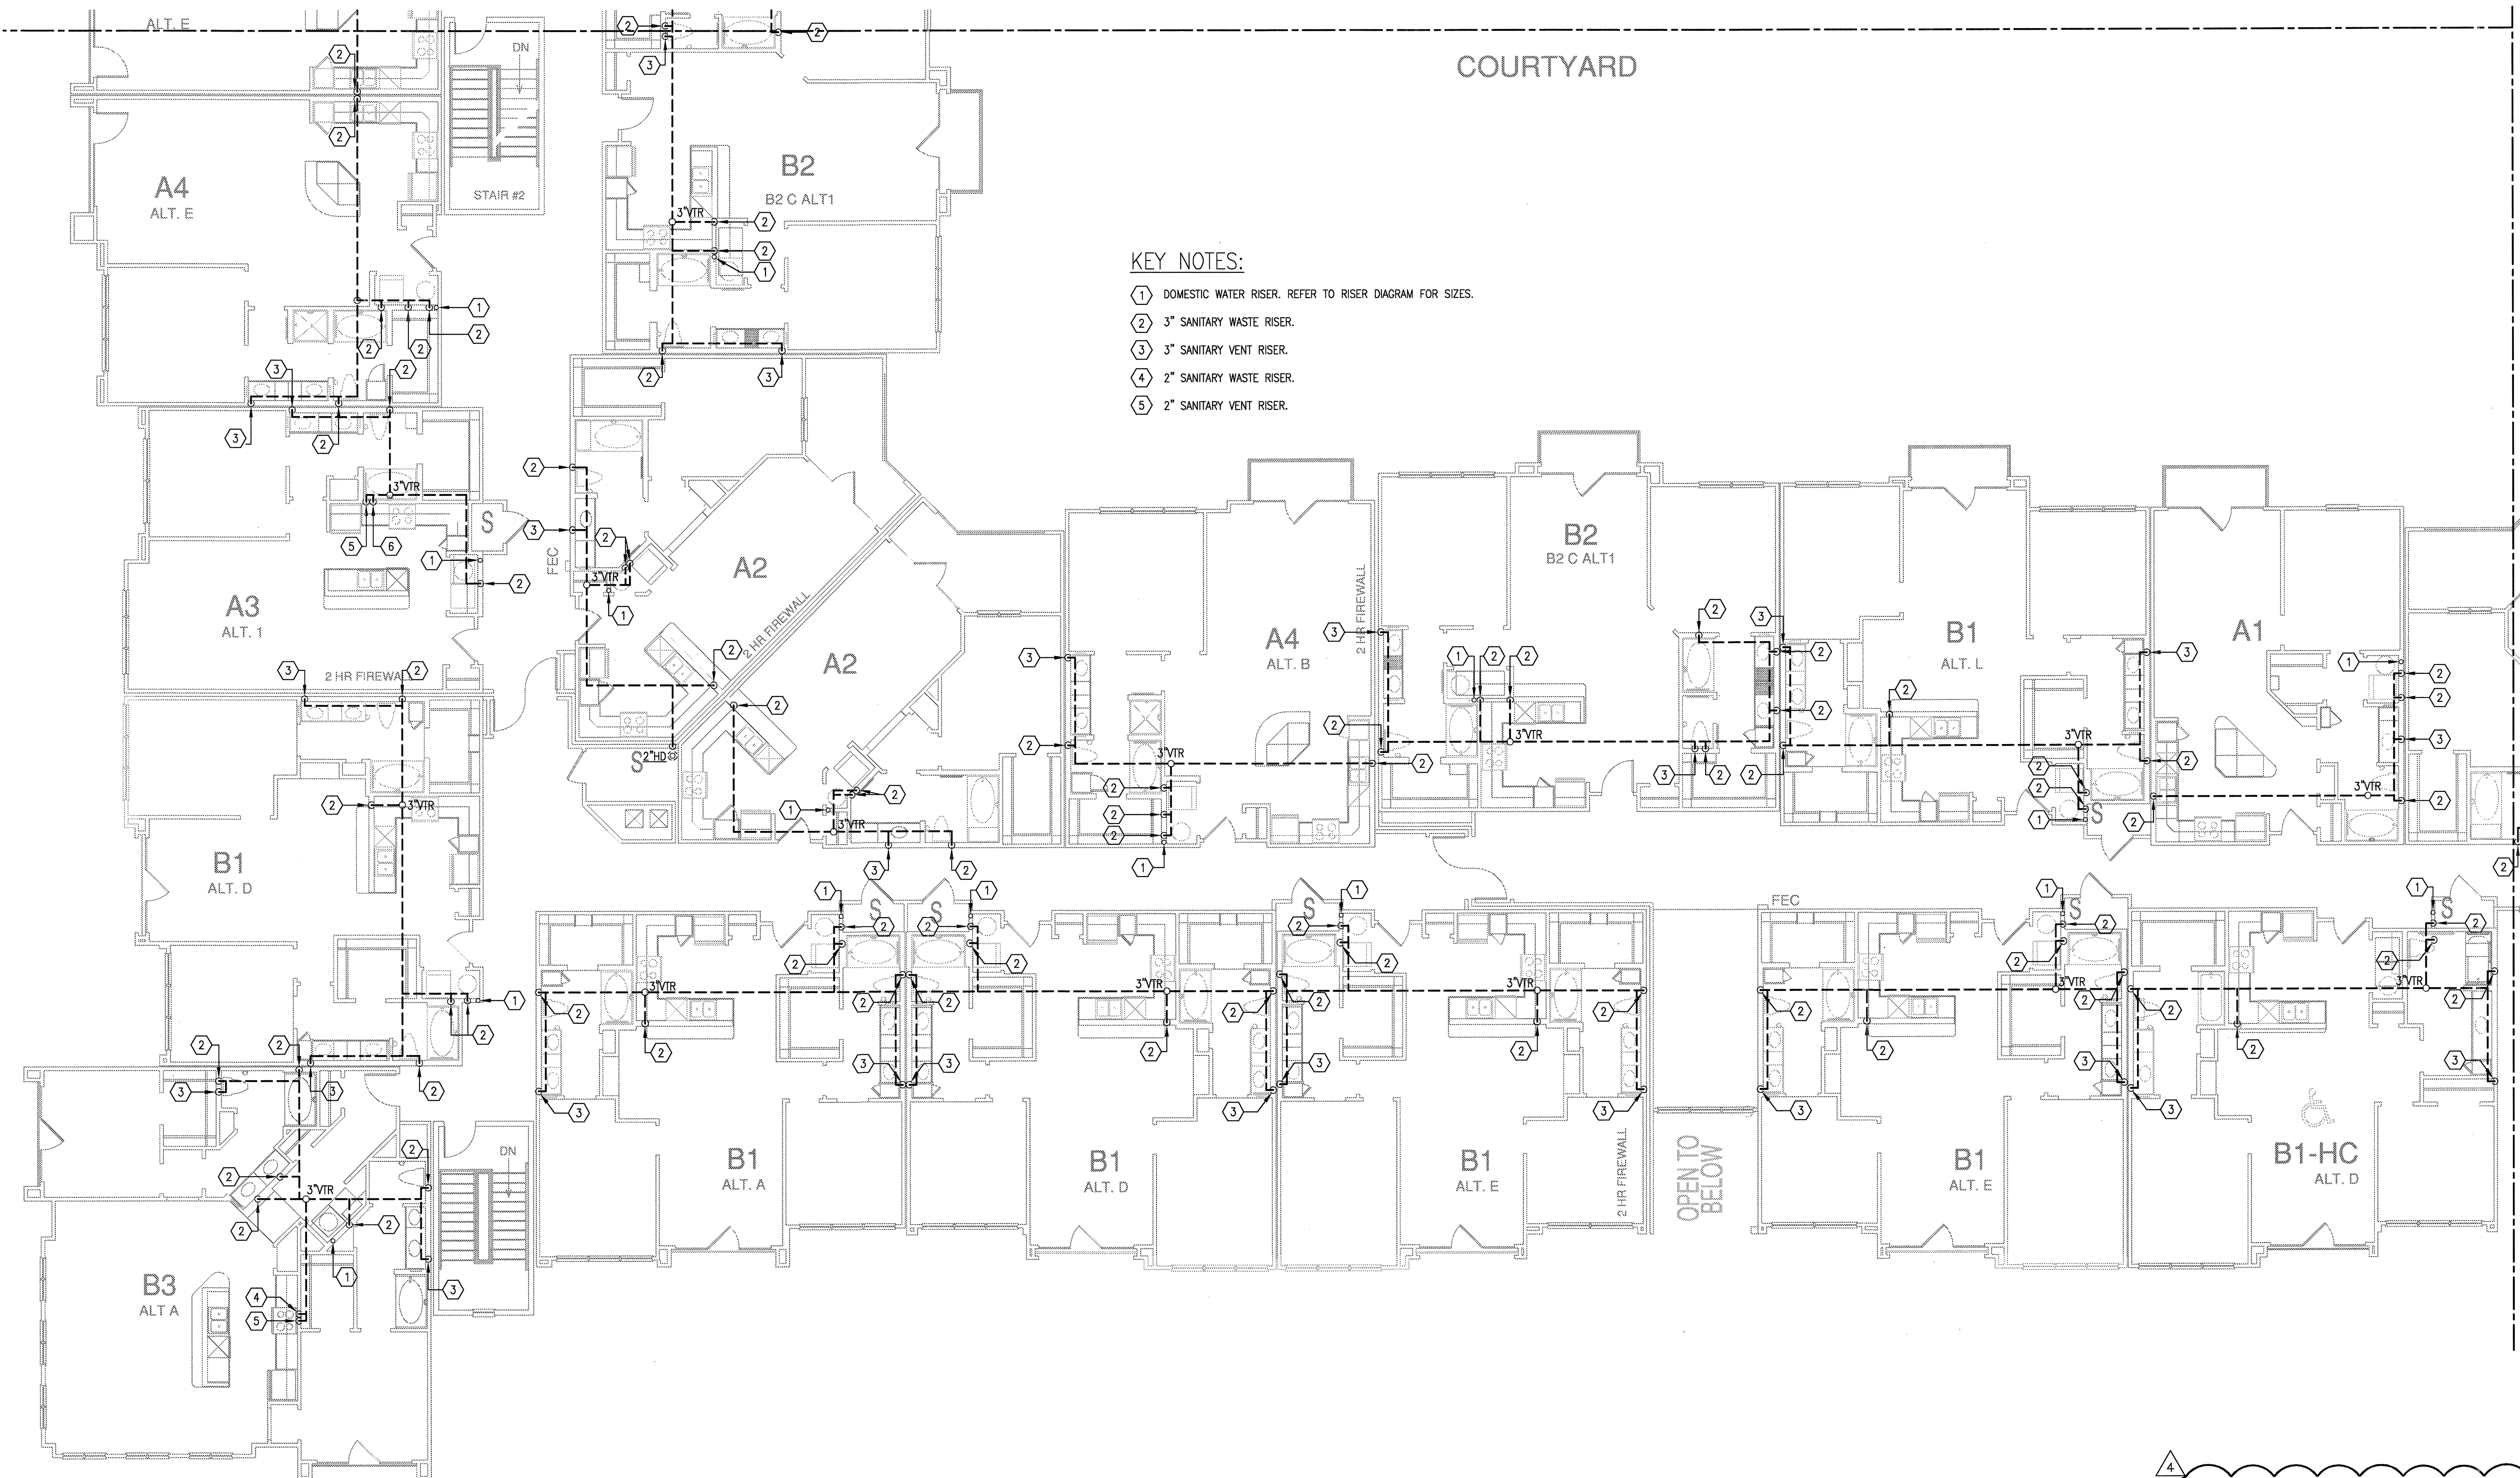

**KEY NOTES:**

- 1 DOMESTIC WATER RISER. REFER TO RISER DIAGRAM FOR SIZES.
- 2 3" SANITARY WASTE RISER.
- 3 3" SANITARY VENT RISER.
- 4 2" SANITARY WASTE RISER.
- 5 2" SANITARY VENT RISER.

1 DIVISION 'B' FOURTH FLOOR PLAN  
SCALE: 1/8" = 1'-0"

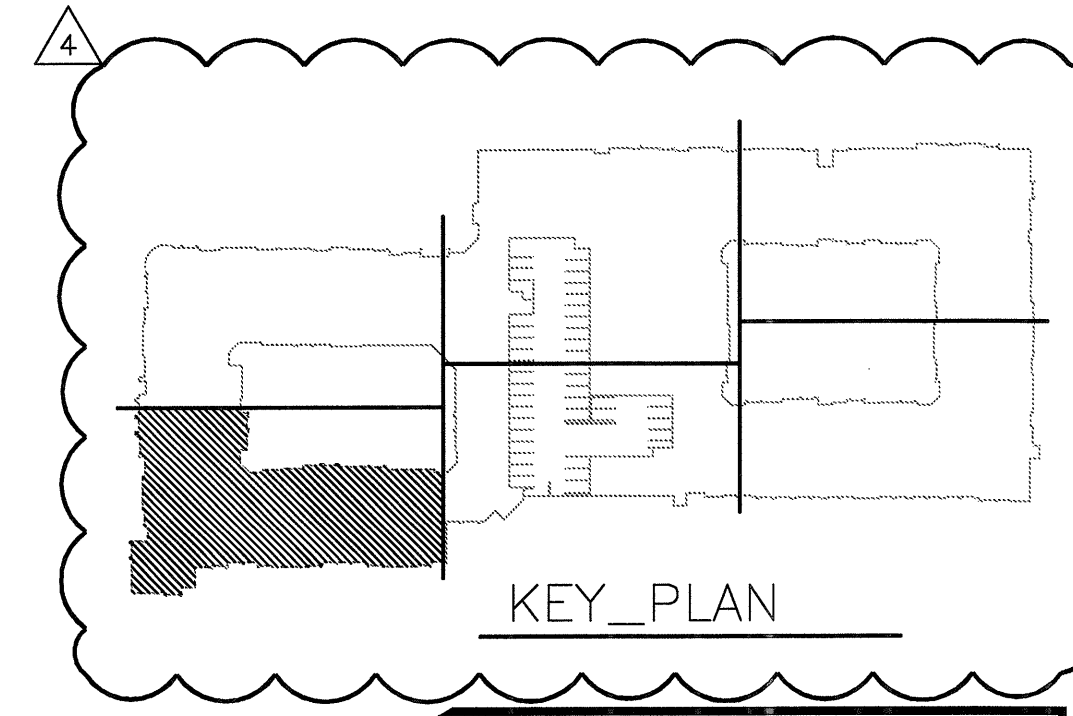

**JSE** Jordan & Skala Engineers  
14240 Midway Road, Suite 350  
Dallas, TX 75244-9138  
Tel: (469) 385-1616 Fax: (469) 385-1615  
Project Number - 113-0355 Texas Firm Registration # F-4990  
Drawn By: CV Checked By: RC