

REVISIONS

1	9-2-2011	DESIGN REVISIONS
2	9-13-2011	ANSI/FHA COMMENTS DESIGN
3	9-23-2011	DESIGN REVISIONS
4	10-17-2011	CONSTRUCTION ISSUE DESIGN REVISIONS
5	12-21-2011	DESIGN REVISIONS
6	1-17-2012	DESIGN REVISIONS
7	2-15-2012	TRANSFORMER REVISIONS
8	3-27-2012	CLUBHOUSE REVISIONS
9	4-17-2012	COORDINATION

KELLER SPRINGS LOFTS
 LOFT APARTMENTS IN ADDISON, TEXAS


10	5-15-2012	COORDINATION
11	5-30-2012	SITE COORDINATION
12	6-01-12	LIGHTING REVISIONS
13	6-29-12	SITE COORDINATION

BGO architects
 4144 N. Central Expy.
 Suite 855
 Dallas, TX 75204
 214.520.8878
 bgoarchitects.com

DATE
 08-05-11

PROJECT
 11129

SHEET NUMBER
P-3.5D

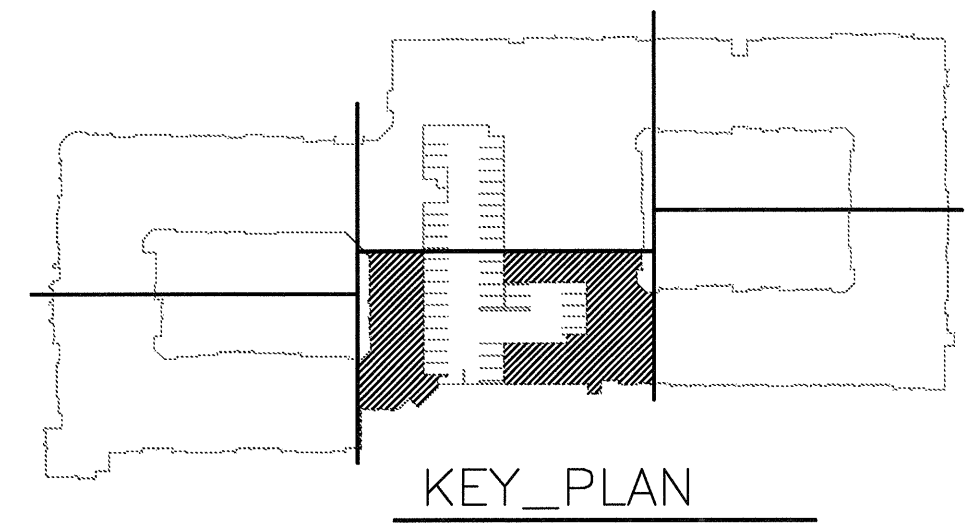

1 DIVISION 'D' ROOF PLAN
 SCALE: 1/8" = 1'-0"

JSE Jordan & Skala Engineers
 17833 N. Lindale Parkway, Suite 320
 Dallas, TX 75247-4857
 V: (469) 383-1616 Web: www.jordanskala.com
 Project Number - 113-0355 Texas Firm Registration # F-4990
 Drawn By: CV Checked By: RC