


REVISIONS		
1	9-2-2011	DESIGN REVISIONS
2	9-13-2011	ANSI/FHA COMMENTS
3	9-23-2011	DESIGN REVISIONS
4	10-17-2011	CONSTRUCTION ISSUE

KELLER SPRINGS LOFTS
 LOFT APARTMENTS IN ADDISON, TEXAS

BGO
architects
 4144 N. Central Expy., Suite 855
 Dallas, TX 75204
 214.520.8878
 bgoarchitects.com

DATE
 08-05-11
 PROJECT
 11129
 SHEET NUMBER

P-3.5E

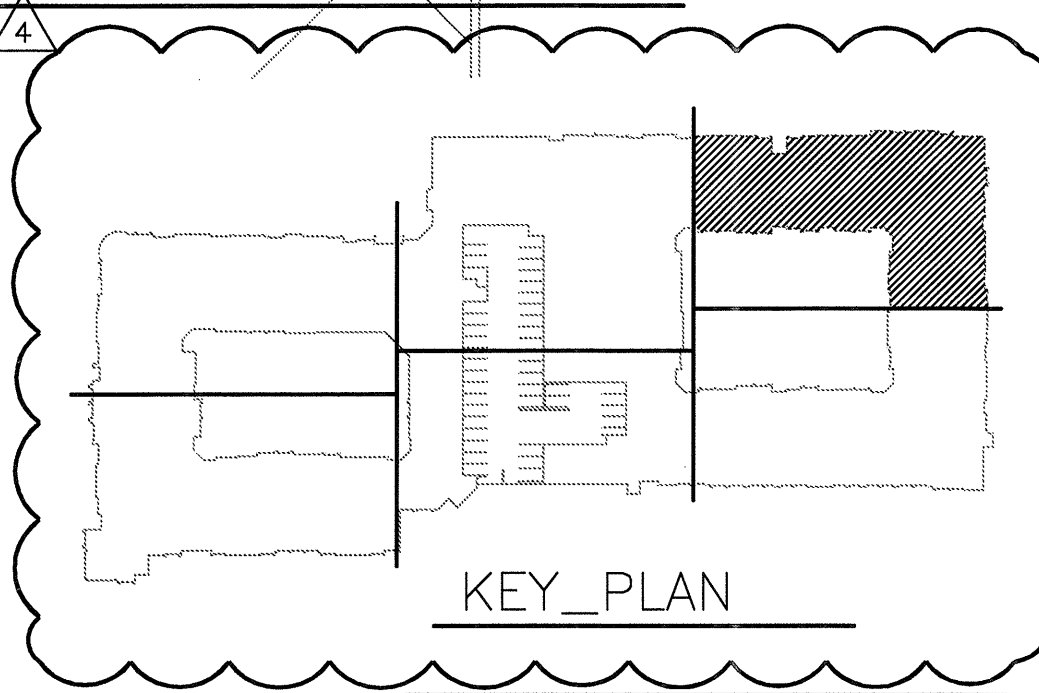

JSE Jordan & Skala Engineers
 14240 Midway Road, Suite 330
 Dallas, TX 75244-5138
 Project Number - 113-0355
 Drawn By: CV
 Texas Firm Registration # F-4990
 Checked By: RC

1 DIVISION 'E' ROOF PLAN
 SCALE: 1/8" = 1'-0"