

| REVISIONS | | |
|-----------|------------|--------------------|
| 1 | 9-2-2011 | DESIGN REVISIONS |
| 2 | 9-13-2011 | ANSI/FHA COMMENTS |
| 3 | 9-23-2011 | DESIGN REVISIONS |
| 4 | 10-17-2011 | CONSTRUCTION ISSUE |

KELLER SPRINGS LOFTS
 LOFT APARTMENTS IN ADDISON, TEXAS


BGO architects
 4144 N. Central Expy.
 Suite 555
 Dallas, TX 75204
 214.520.8878
 bgoarchitects.com

DATE
 08-05-11

PROJECT
 11129

SHEET NUMBER

P-3.5F

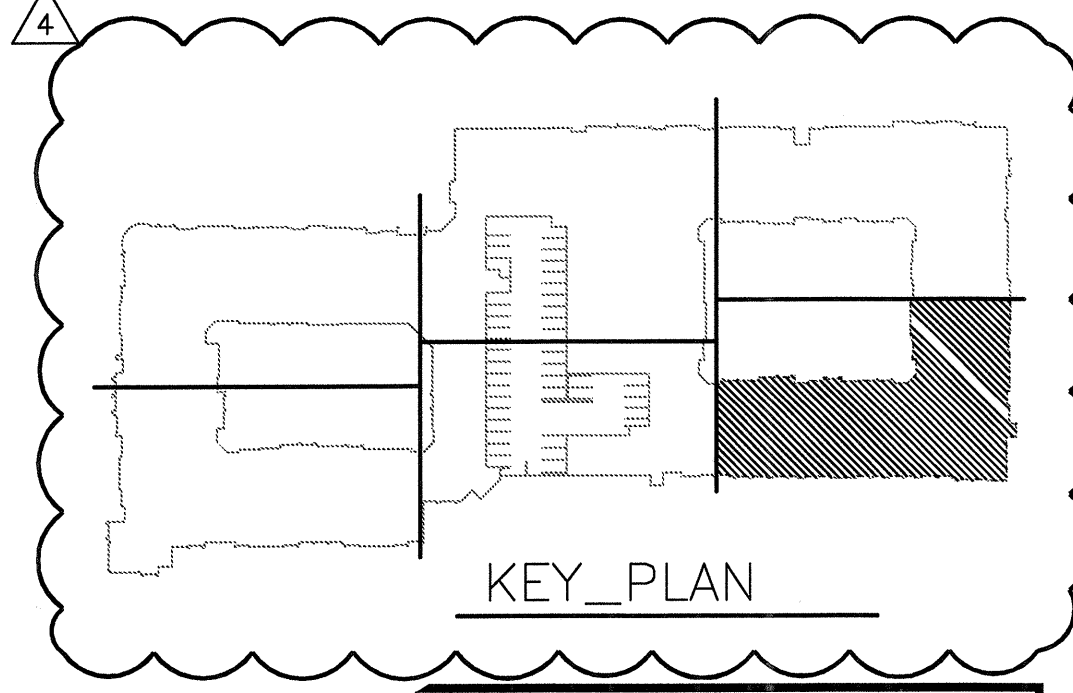

1 DIVISION 'F' ROOF PLAN
 SCALE: 1/8" = 1'-0"

JSE Jordan & Skala Engineers
 14240 Midway Road, Suite 150
 Dallas, TX 75244-5138
 Tel: (469) 385-1616 Fax: (469) 385-1615
 Project Number - 113-0355 Texas Firm Registration # F-4990
 Drawn By: CV Checked By: RC