

RFI

To: Heath Parnell
 Jordan & Skala Engineers, Inc.
 14240 Midway Road, Suite 350
 Dallas, TX 75244
 Ph: 469/385-1616 Fax: 469/385-1615

RFI #: 137
Date: 6/1/2012
Job: EB-02 Keller Springs Lofts
Phone: 877-777-5115

CC: Erik Earnshaw (Beeler Guest Owens Architects)

Subject: Trench Drain in Garage

Drawing: P-3.6
Cost Impact: None

Spec Section:
Schedule Impact: None

Request: The trench drain shown on P-3.6 scales to about 24 feet in length. The actual opening in the double tee is about 6'-3" x 10". Is the 6'-3" size enough to handle the water load coming down the ramp? What size drain (depth) would be needed to handle the water?
Date Required: 6/11/2012

Requested by: David Miller
 Embrey Builders LLC

Response:

See the attached sketch sent for the latest trench drain layout and pipe sizing.


Heath Parnell

Answered by: Jordan & Skala
 Date: 6/12/12

Company: _____

RFI 137

≡

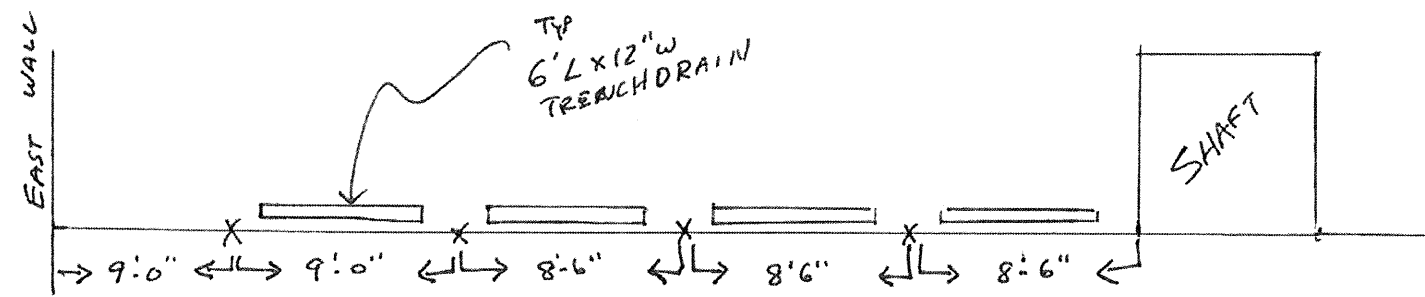

X = CONNECTIONS

N

