


REVISIONS	
1	9-2-2011 DESIGN REVISIONS
2	9-13-2011 ANSI/FHA COMMENTS
3	9-23-2011 DESIGN REVISIONS
4	10-17-2011 CONSTRUCTION ISSUE
5	12-21-2011 DESIGN REVISIONS


KELLER SPRINGS LOFTS

LOFT APARTMENTS IN ADDISON, TEXAS

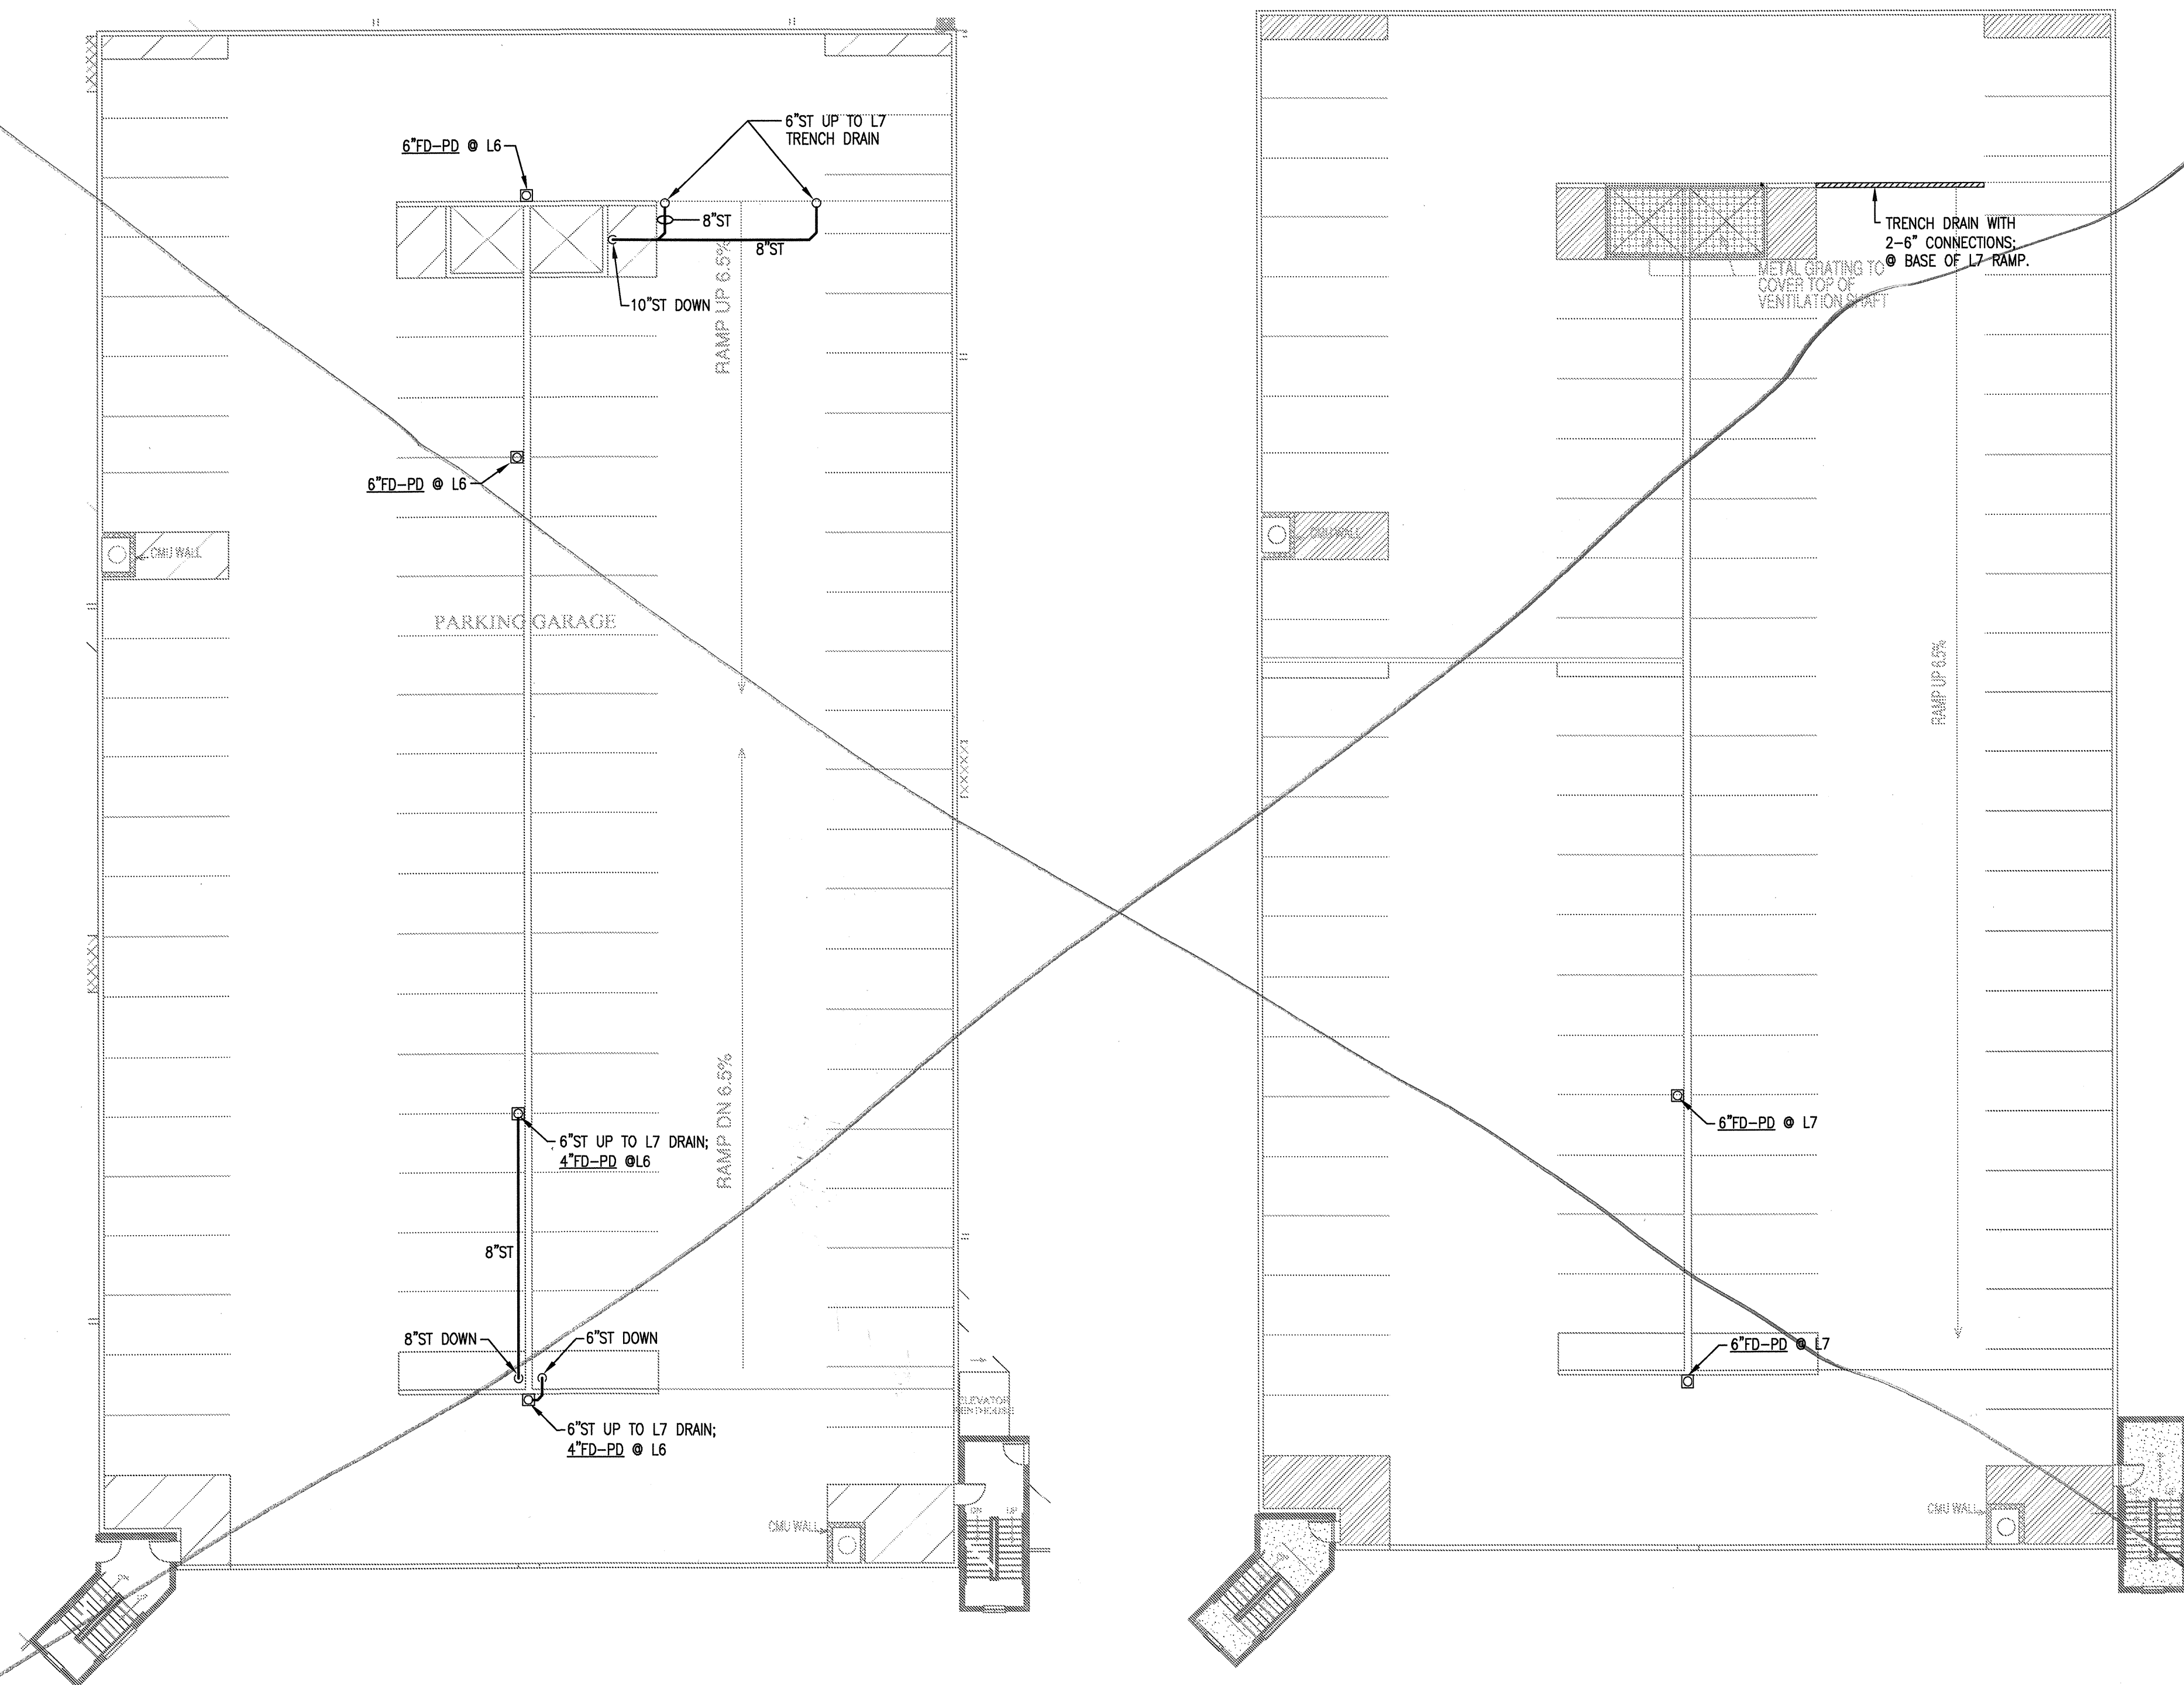

1 LEVEL 6 GARAGE
SCALE: 1/16" = 1'-0"

2 LEVEL 7 GARAGE
SCALE: 1/16" = 1'-0"

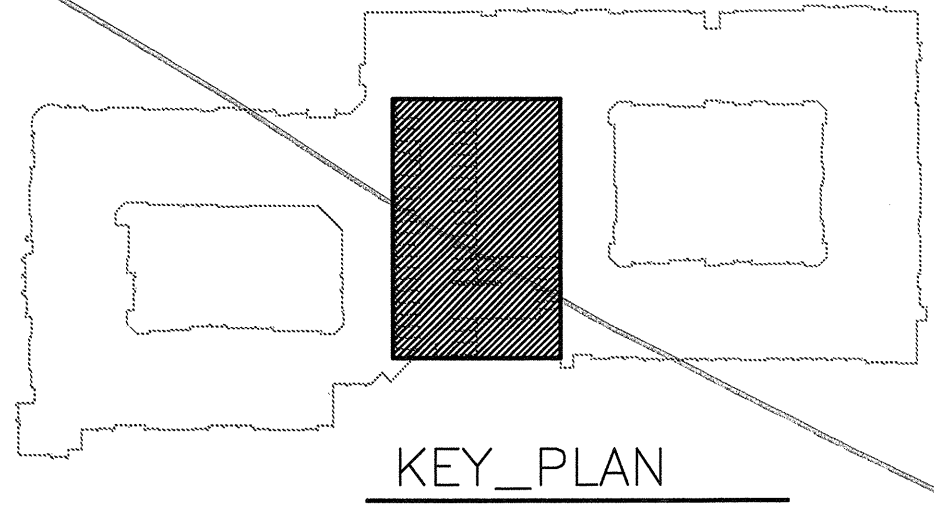

KEY_PLAN

JSE Jordan & Skala Engineers
 14240 Midway Road, Suite 330
 Dallas, TX 75244-5138
 V: (469) 385-7616 F: (469) 385-7615
 Project Number - 113-0355 Texas Firm Registration # F-4990
 Drawn By: CV Checked By: RC

BGO architects
 4144 N. Central Expy.
 Suite 855
 Dallas, TX 75204
 214.520.8878
 bgoarchitects.com

DATE
08-05-11

PROJECT
11129

SHEET NUMBER
5

P-3.6