




REVISIONS		
1	9-2-2011	DESIGN REVISIONS
2	9-13-2011	ANSI/PHA COMMENTS
3	9-23-2011	DESIGN REVISIONS
4	10-17-2011	CONSTRUCTION ISSUE
5	12-21-2011	DESIGN REVISIONS
6	1-17-2012	DESIGN REVISIONS
7	2-15-2012	TRANSFORMER REVISIONS
8	3-27-2012	CLUBHOUSE REVISIONS
9	4-17-2012	COORDINATION

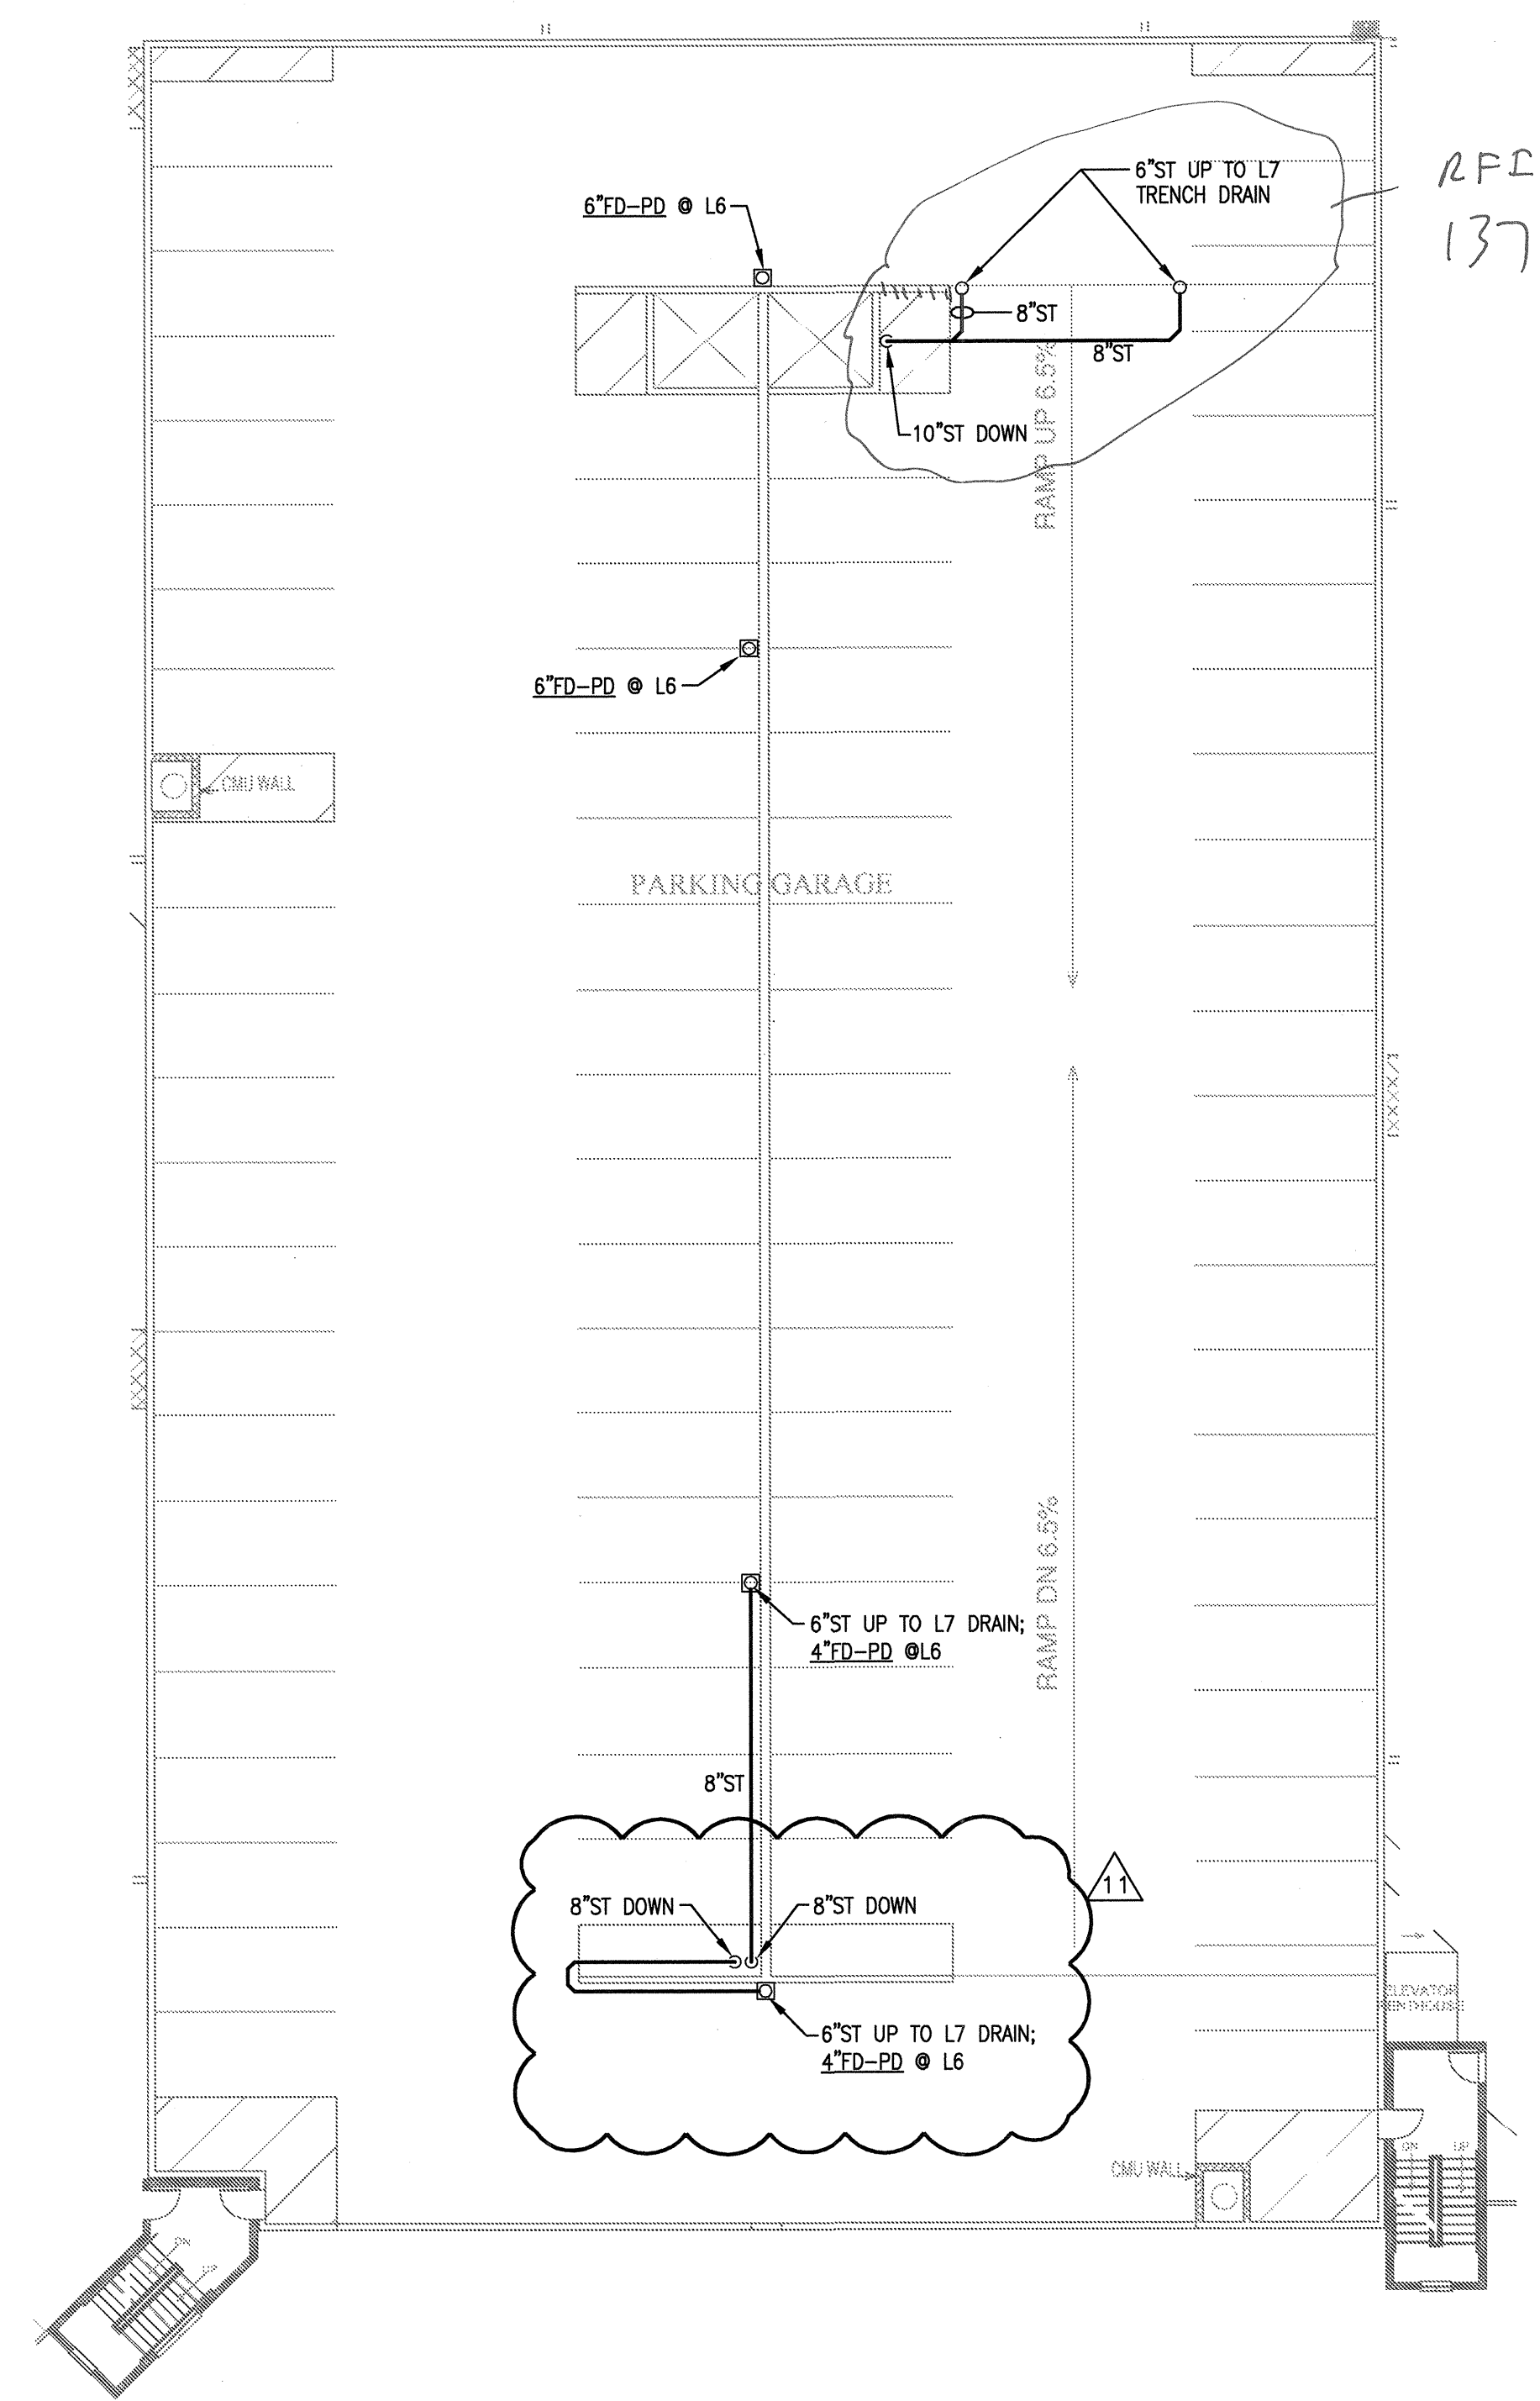

1 LEVEL 6 GARAGE
SCALE: 1/16" = 1'-0"

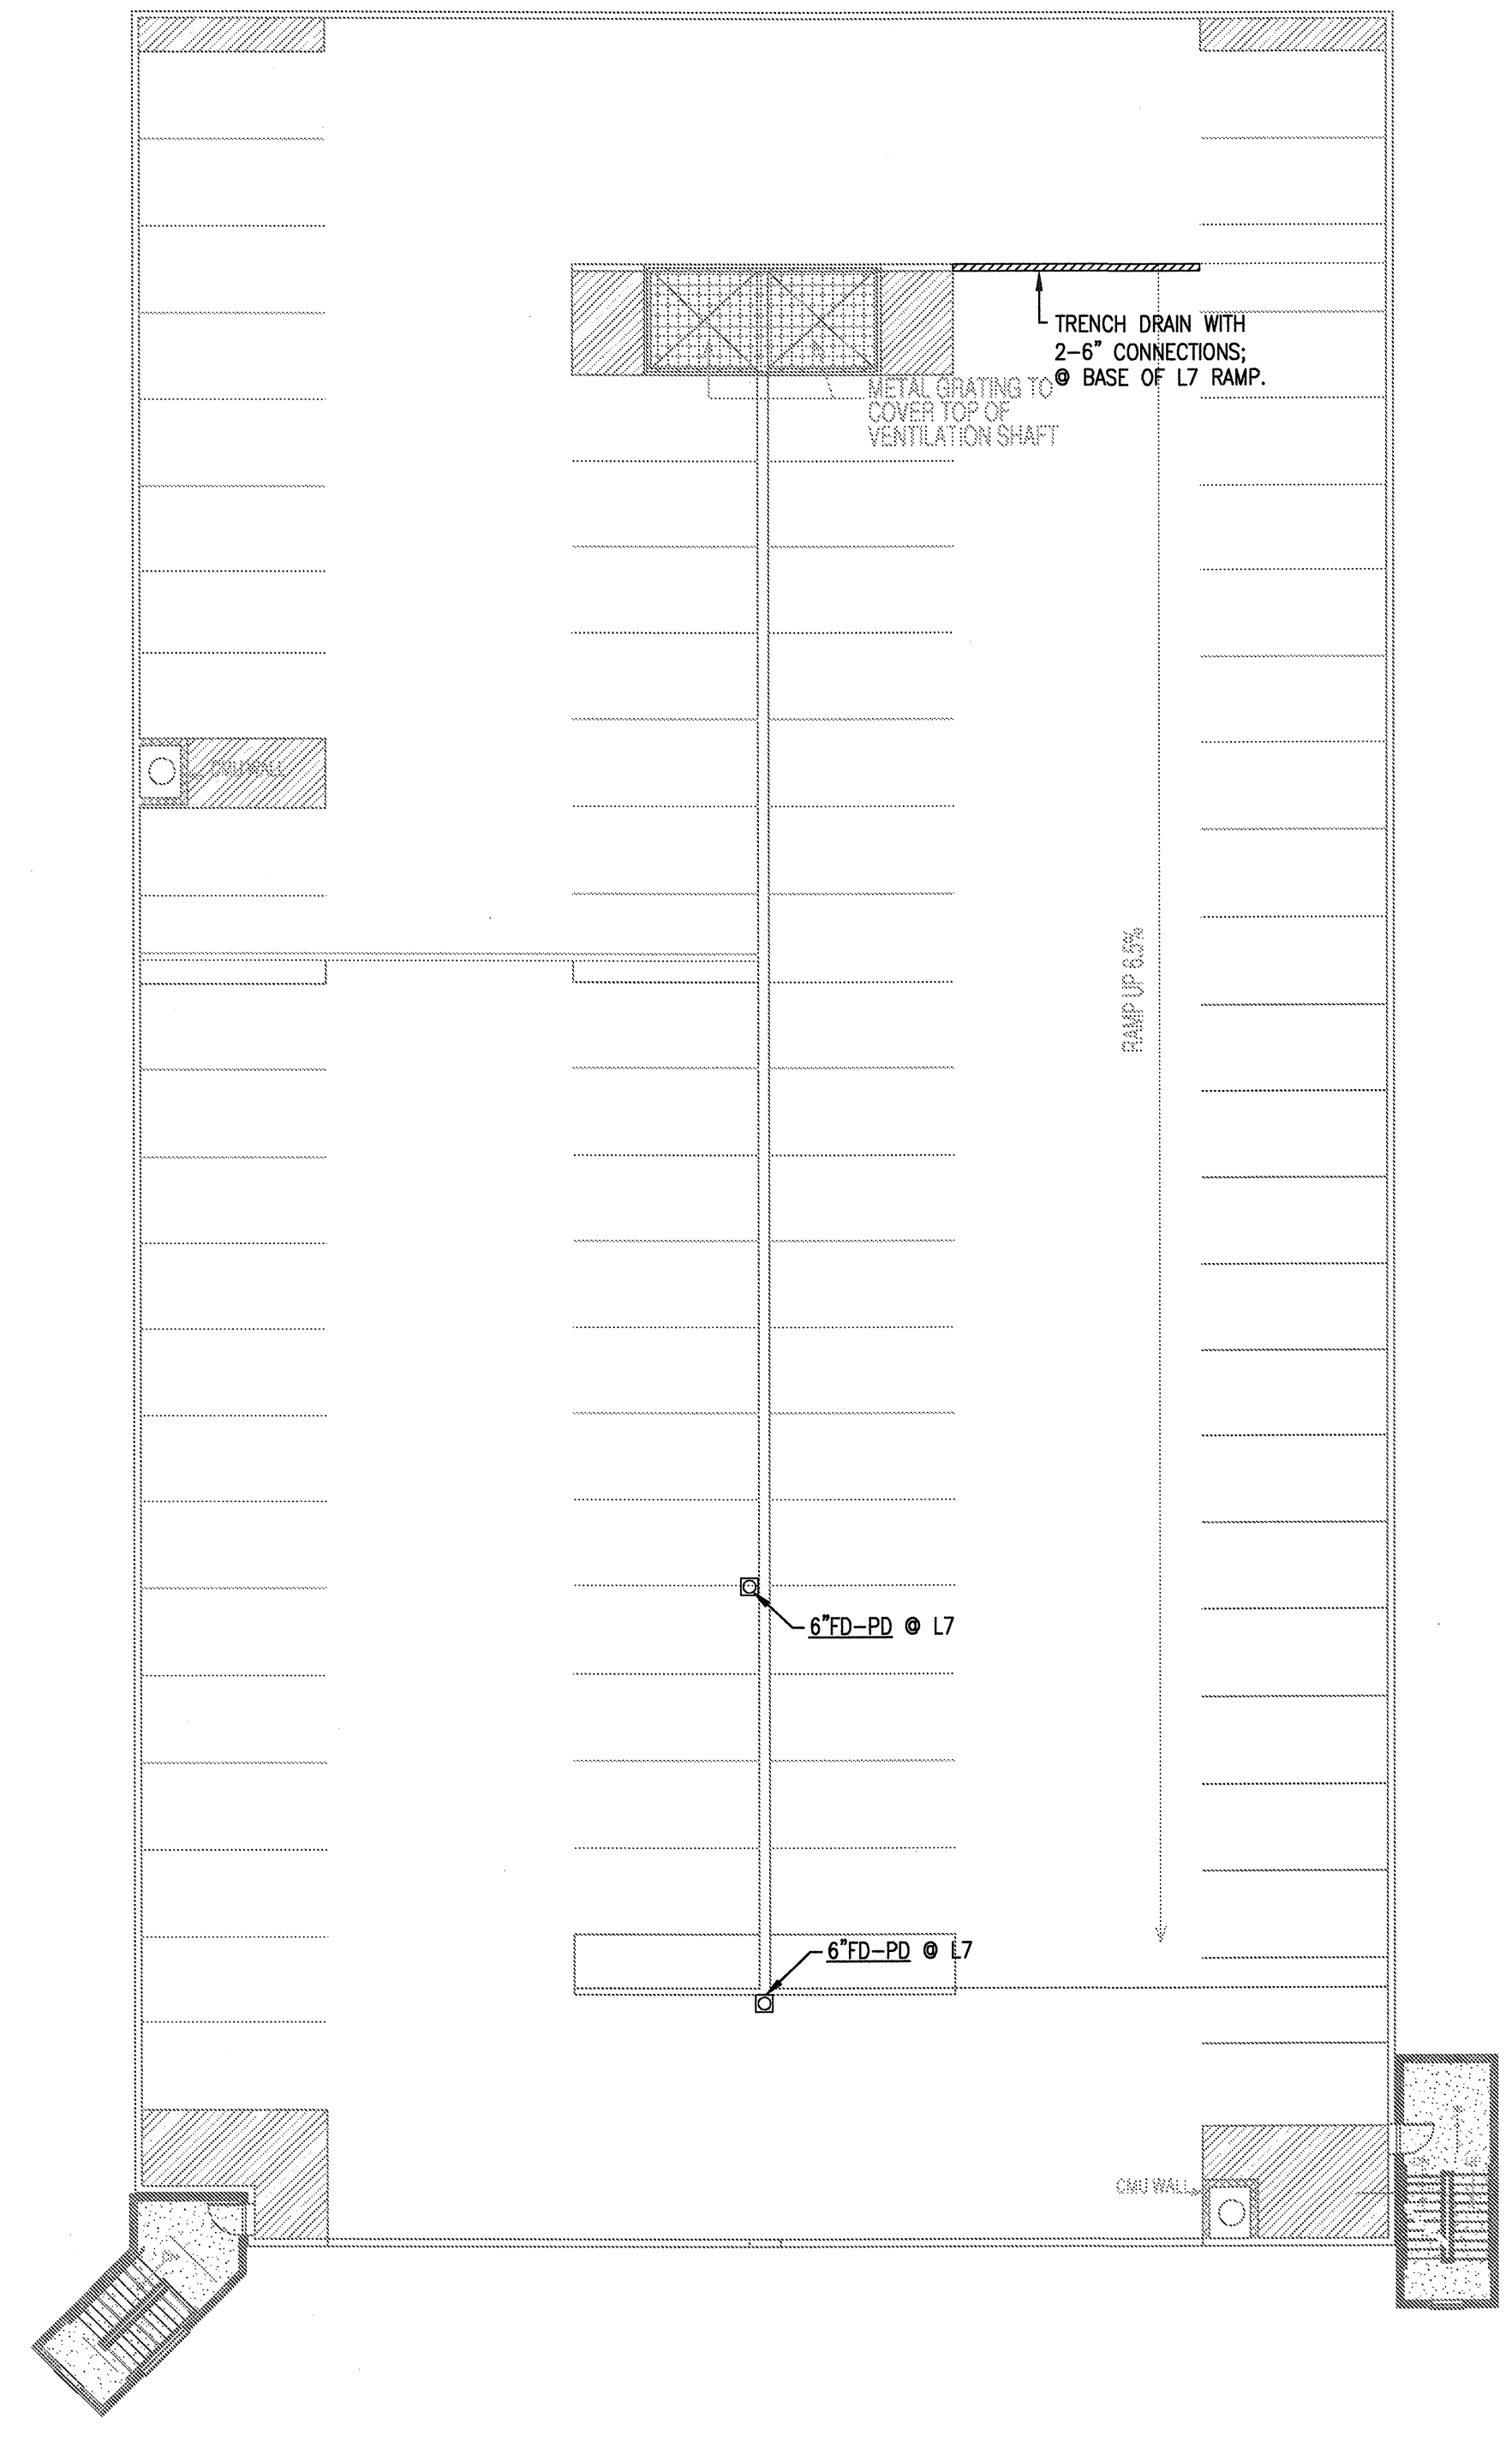

2 LEVEL 7 GARAGE
SCALE: 1/16" = 1'-0"

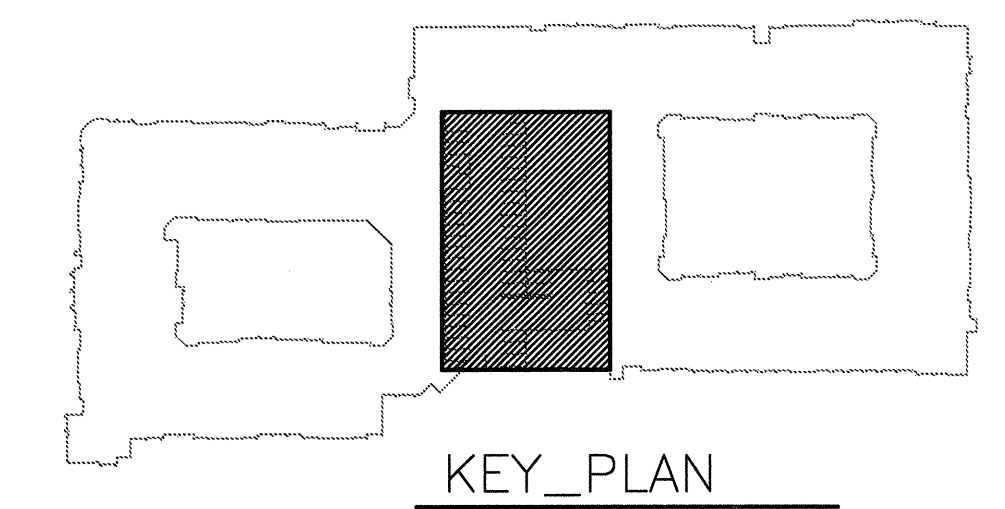

JSE Jordan & Skala Engineers
 17855 N. Dallas Parkway, Suite 320
 Dallas, TX 75287-6557
 Project Number - 113-0355 Texas Firm Registration # F-4990
 Drawn By: CV Checked By: RC

KELLER SPRINGS LOFTS
 LOFT APARTMENTS IN ADDISON, TEXAS

10	5-15-2012	COORDINATION
11	5-30-2012	SITE COORDINATION

BGO architects
 4144 N. Central Expy.
 Suite 855
 Dallas, TX 75204
 214.520.8878
 bgoarchitects.com

DATE
08-05-11

PROJECT
11129

SHEET NUMBER

P-3.6