




SECTION 1
SCALE: 3/4"=1'-0"

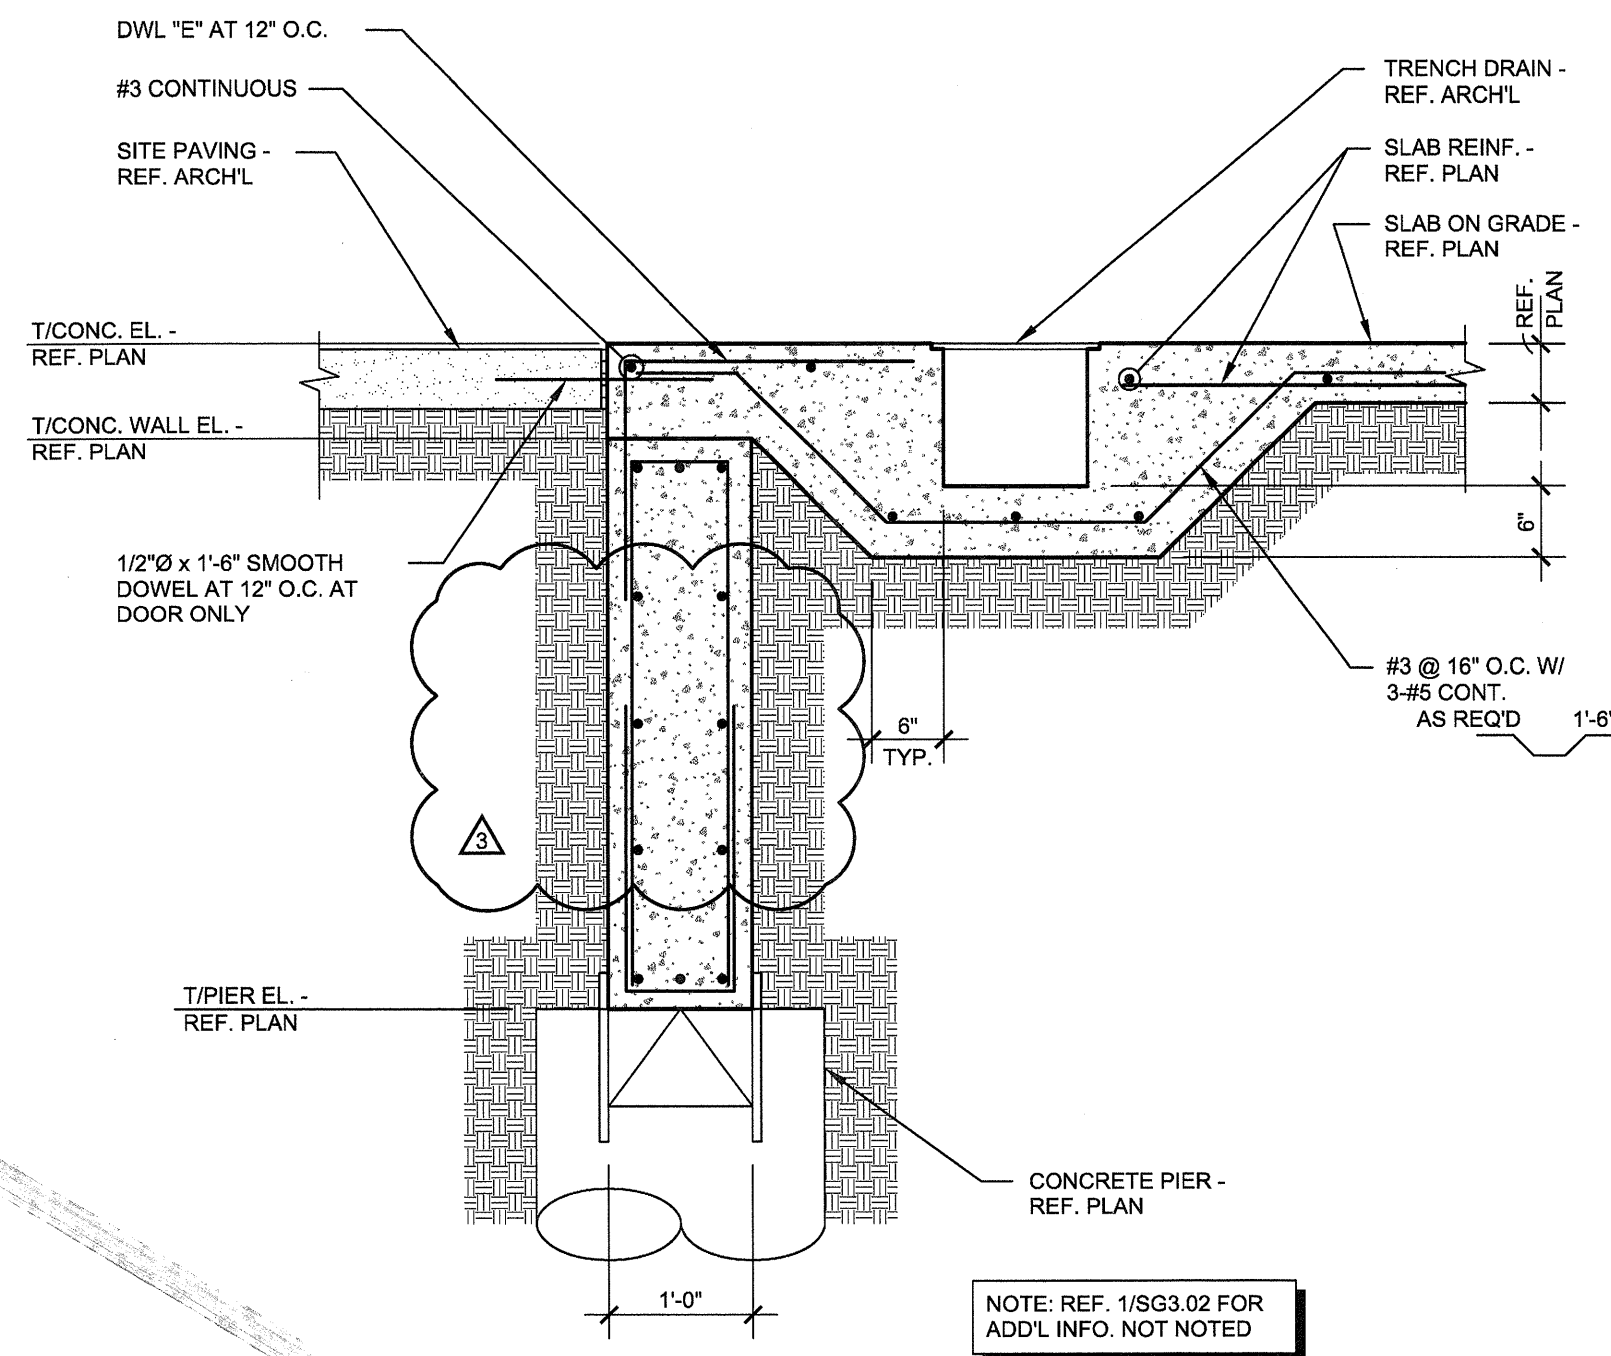

SECTION 2
SCALE: 3/4"=1'-0"

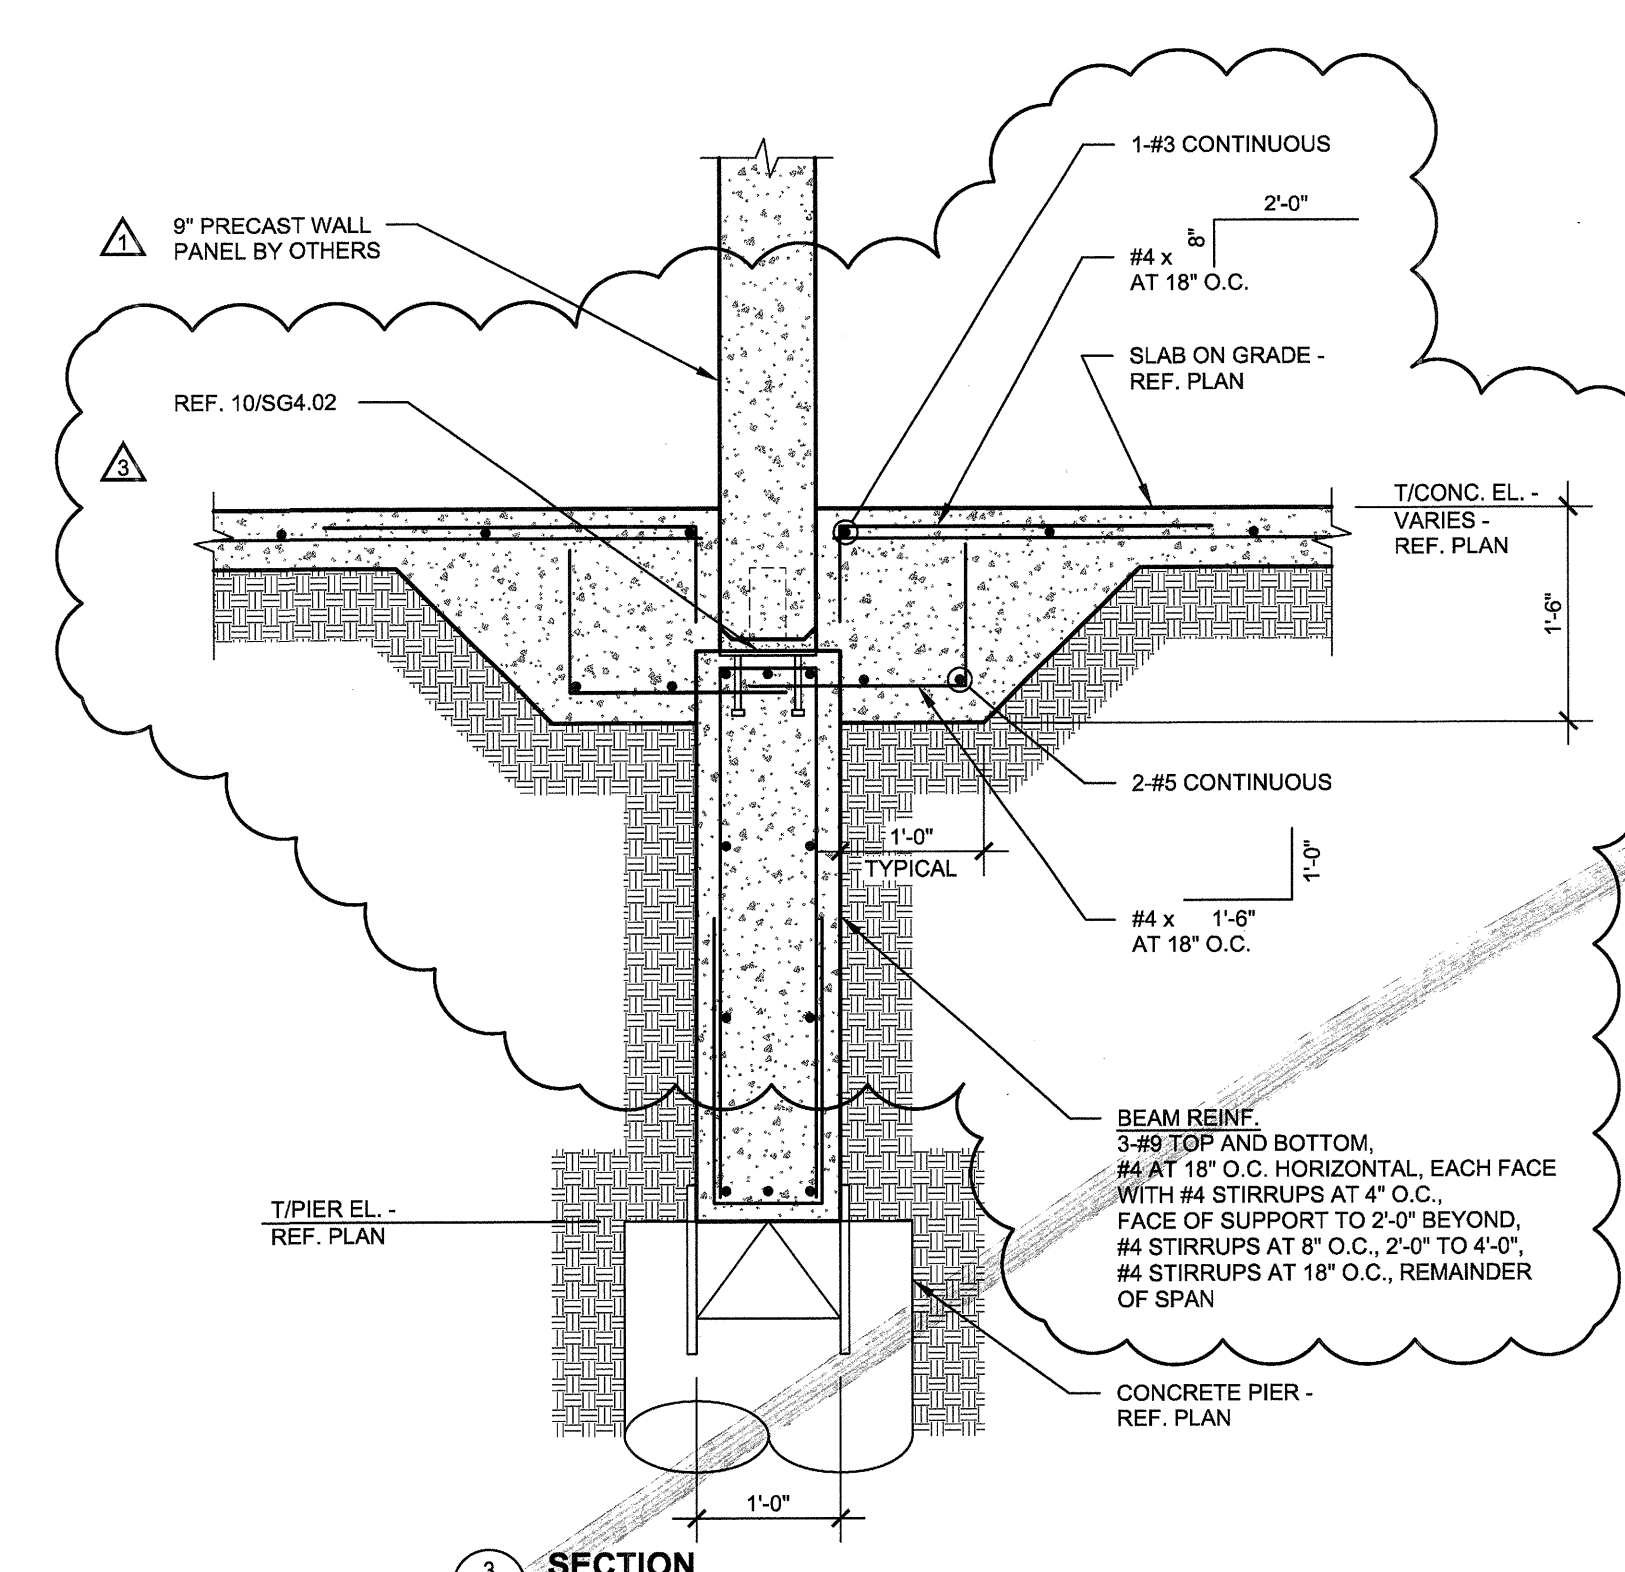


SECTION 3
SCALE: 3/4"=1'-0"

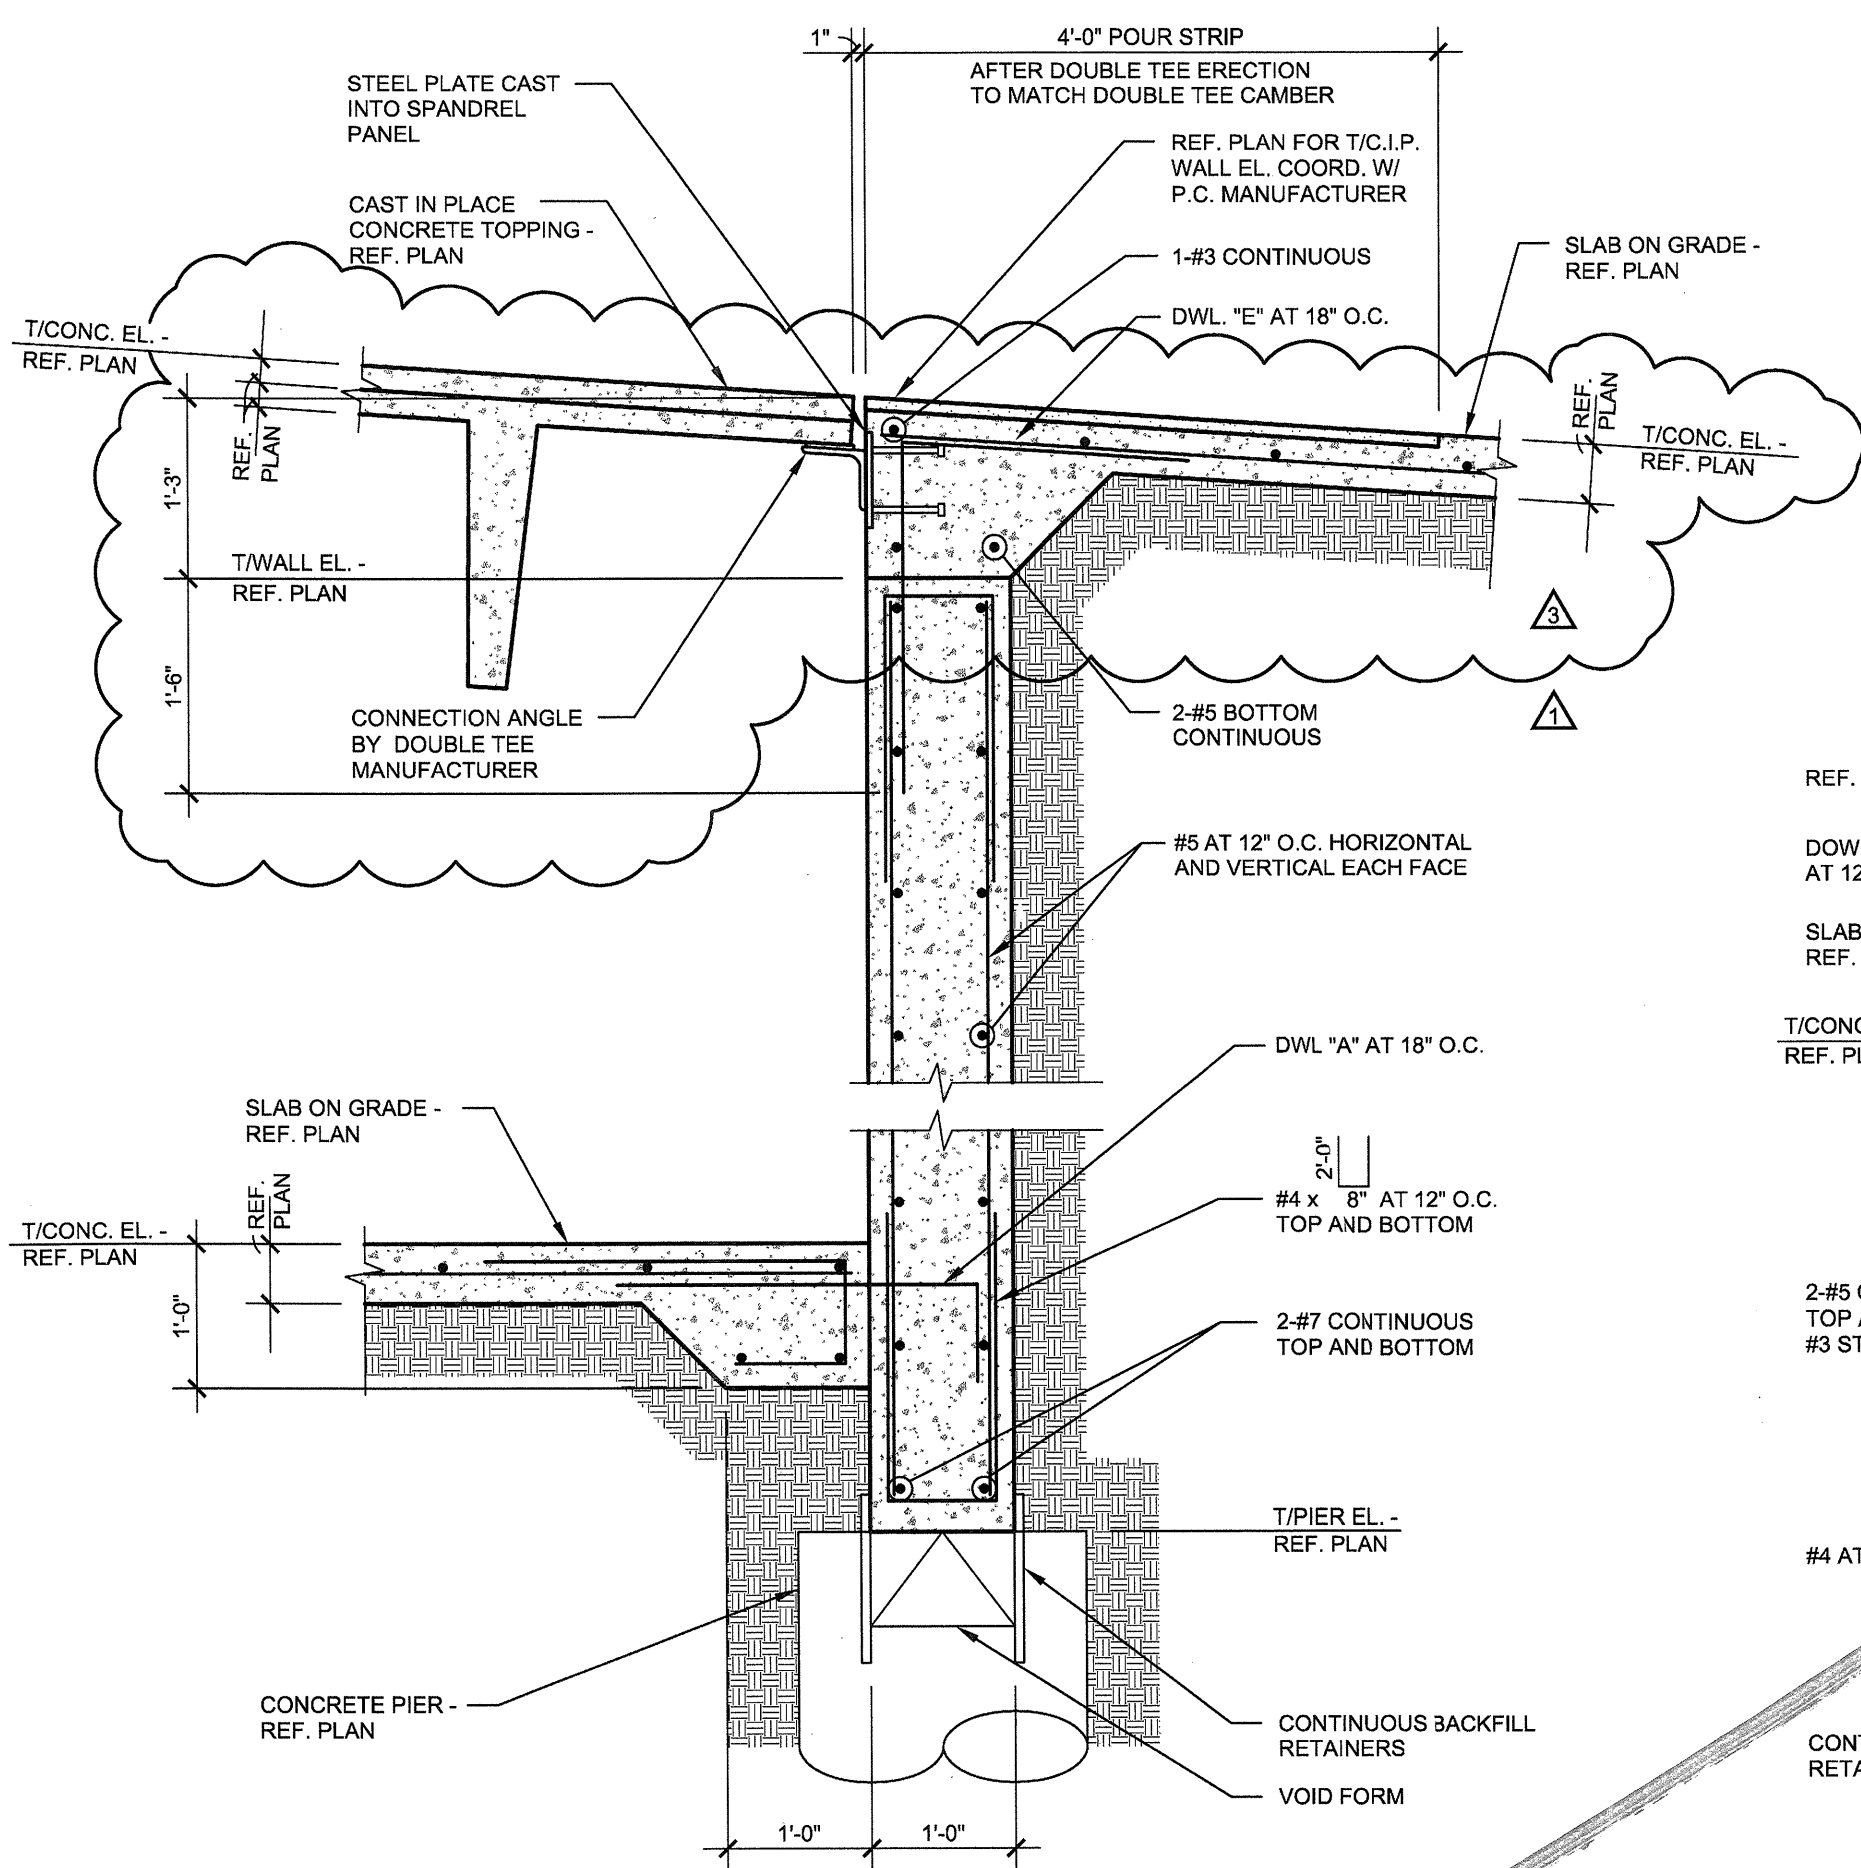


SECTION 4
SCALE: 3/4"=1'-0"

NOTE: VERIFY PIT SIZE AND LOCATION WITH ARCHITECTURAL AND MECHANICAL DRAWINGS


TYPICAL PIT WALL SECTION
NO SCALE

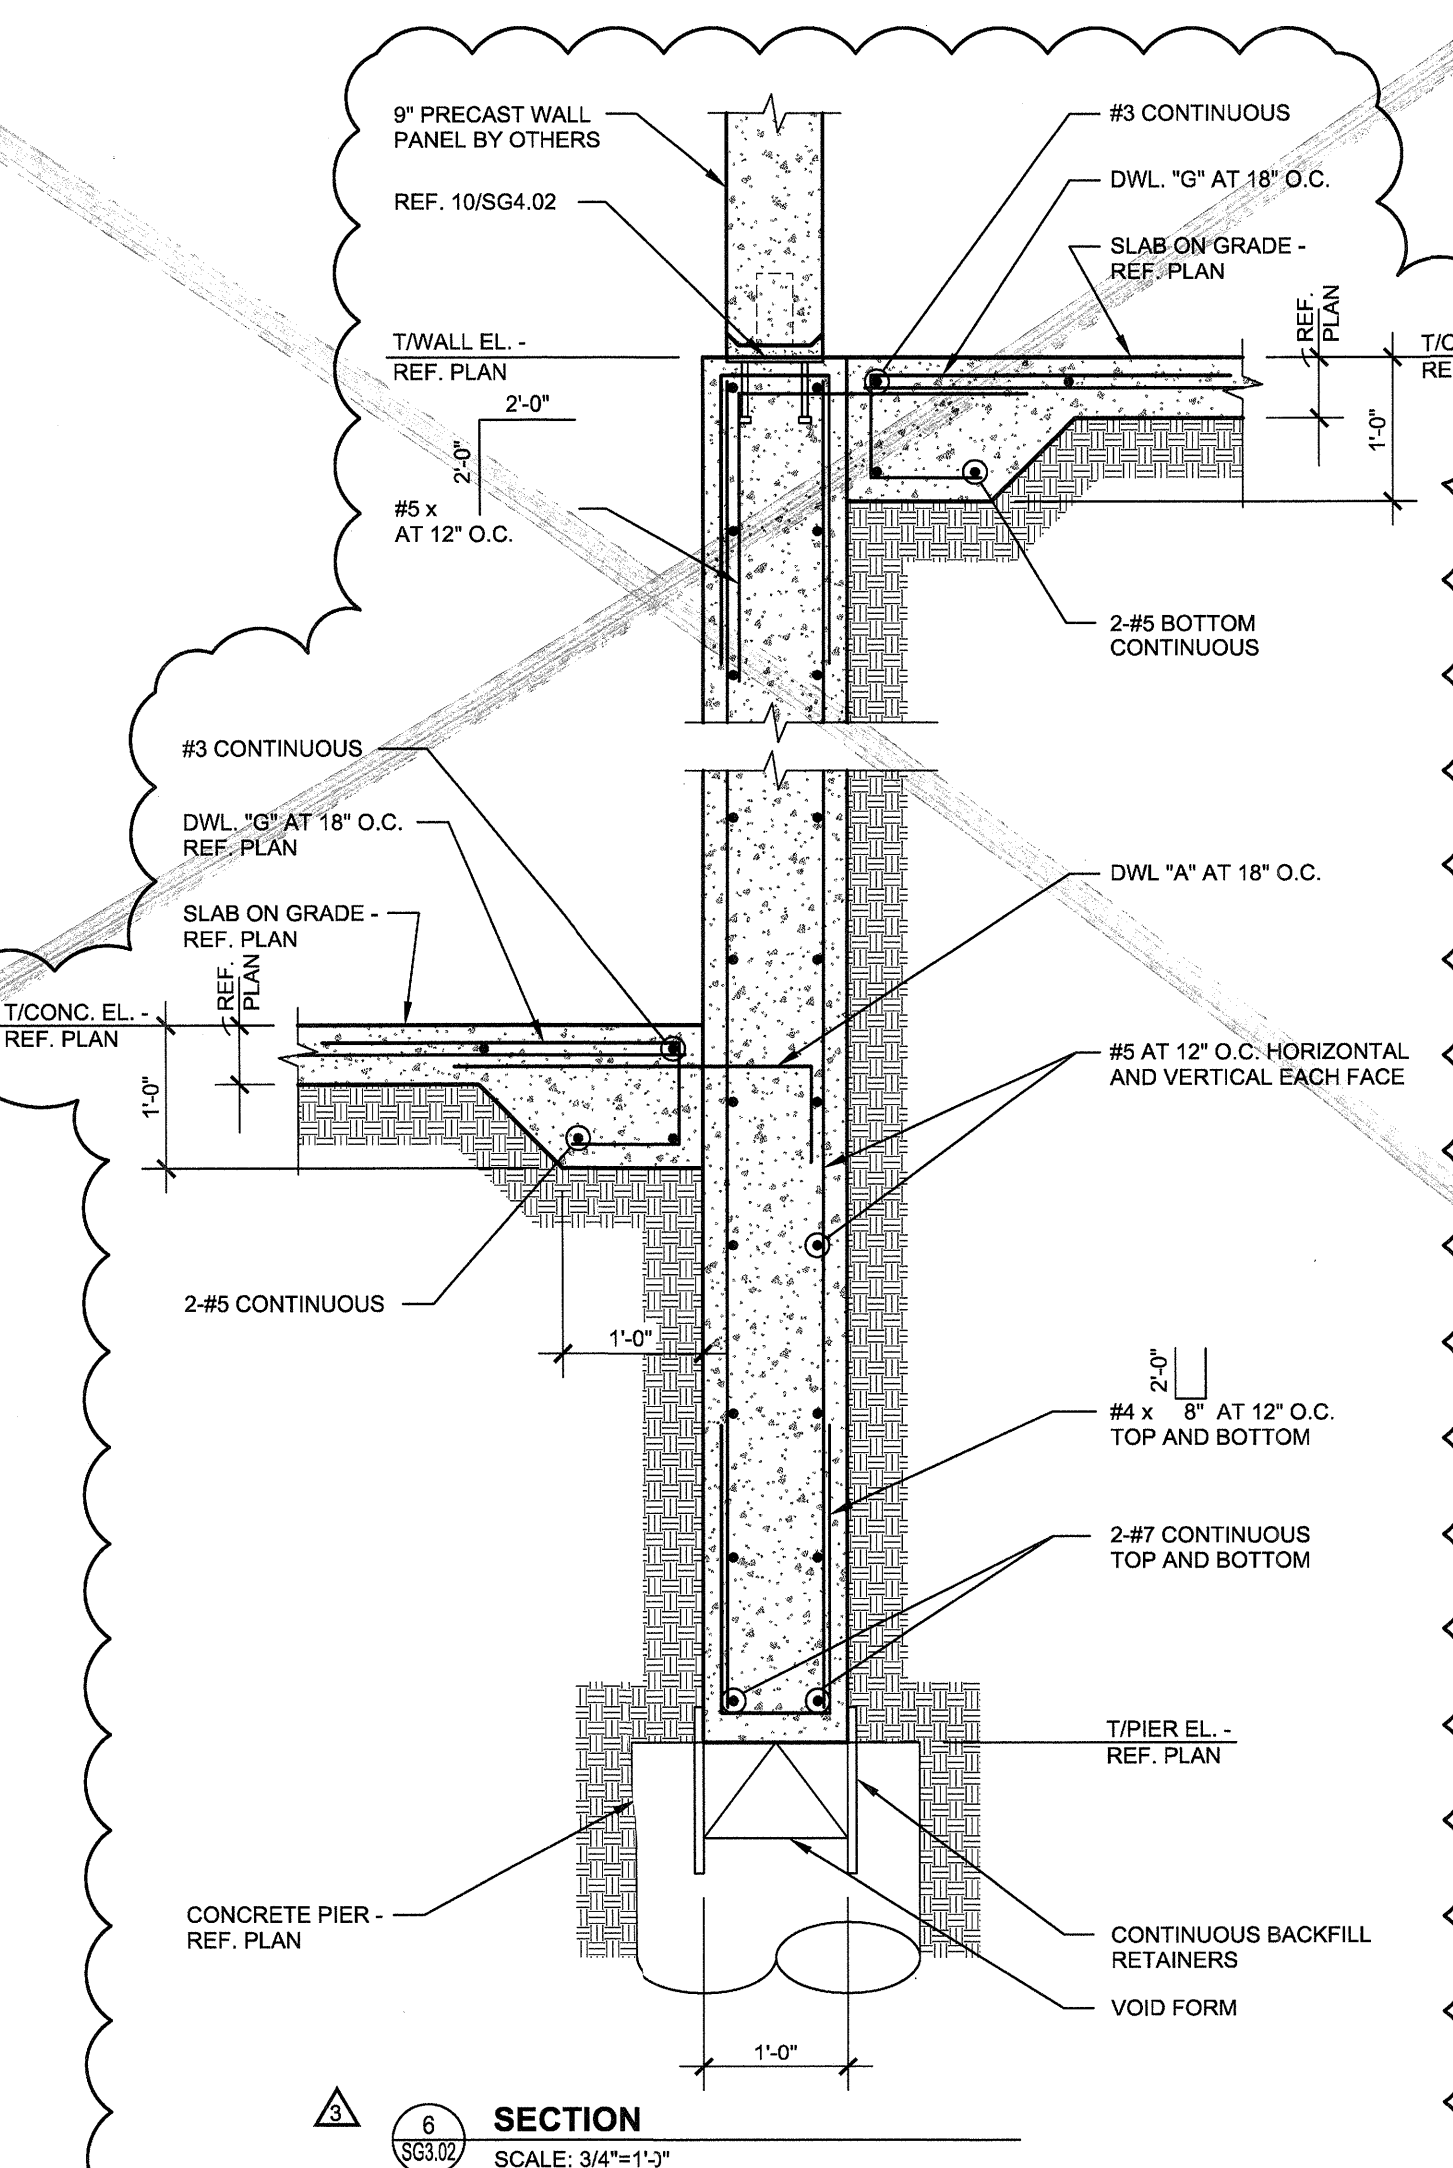

SECTION 6
SCALE: 3/4"=1'-0"

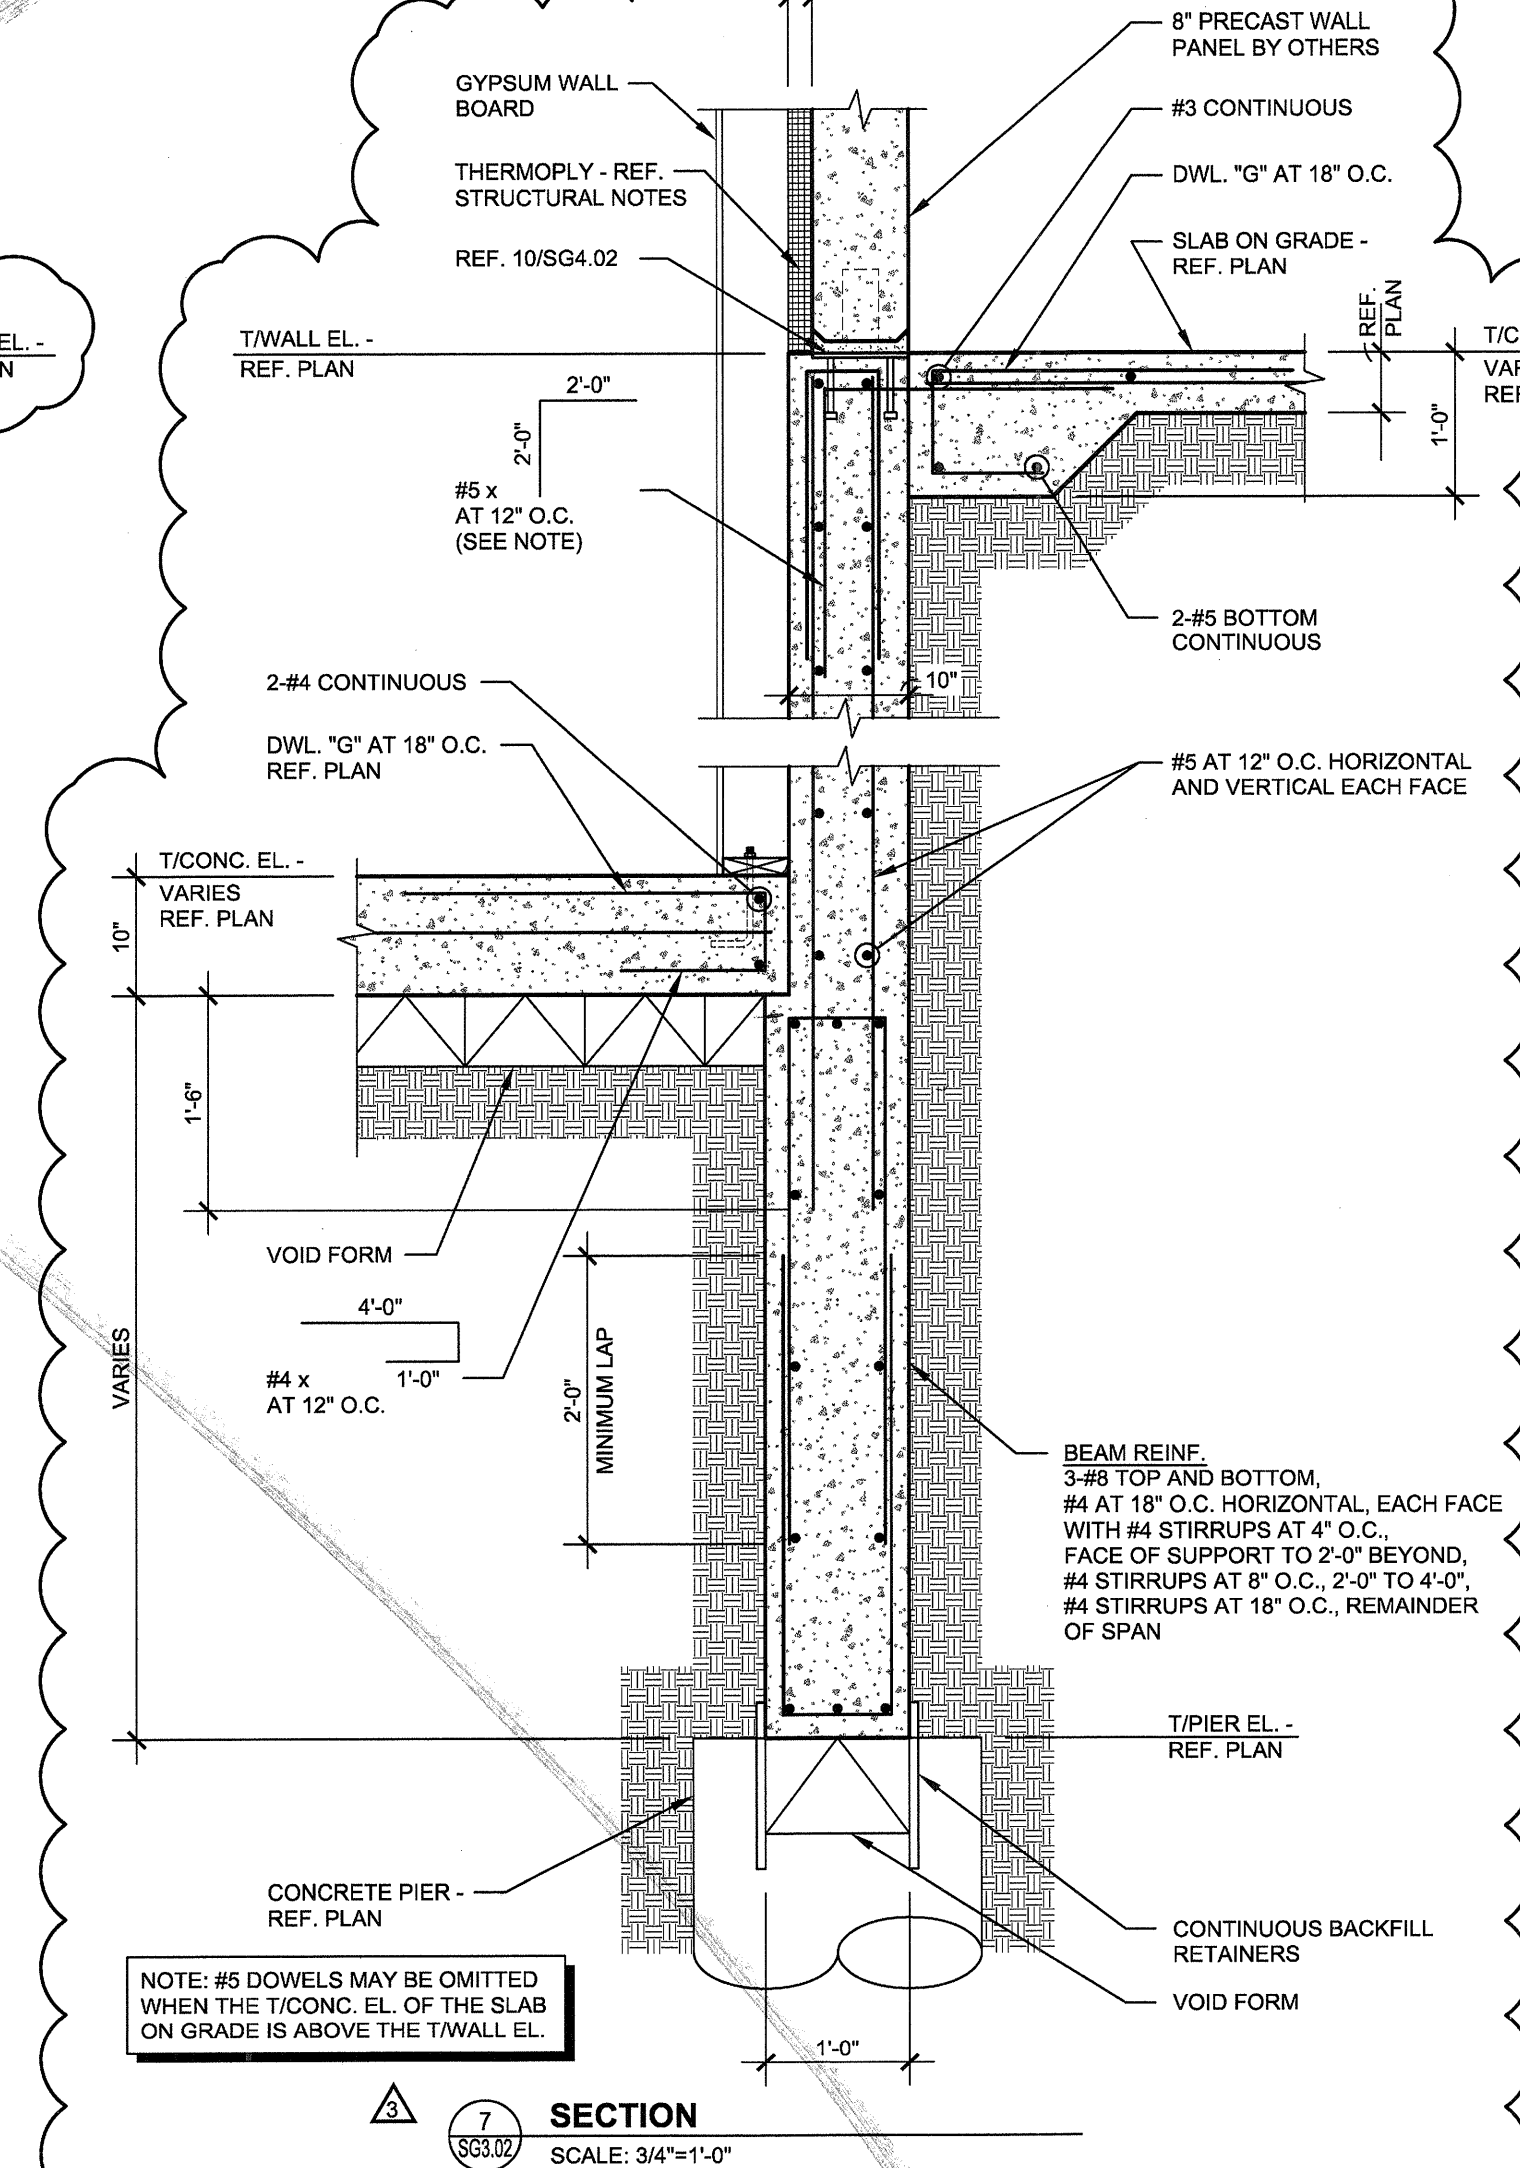

SECTION 7
SCALE: 3/4"=1'-0"

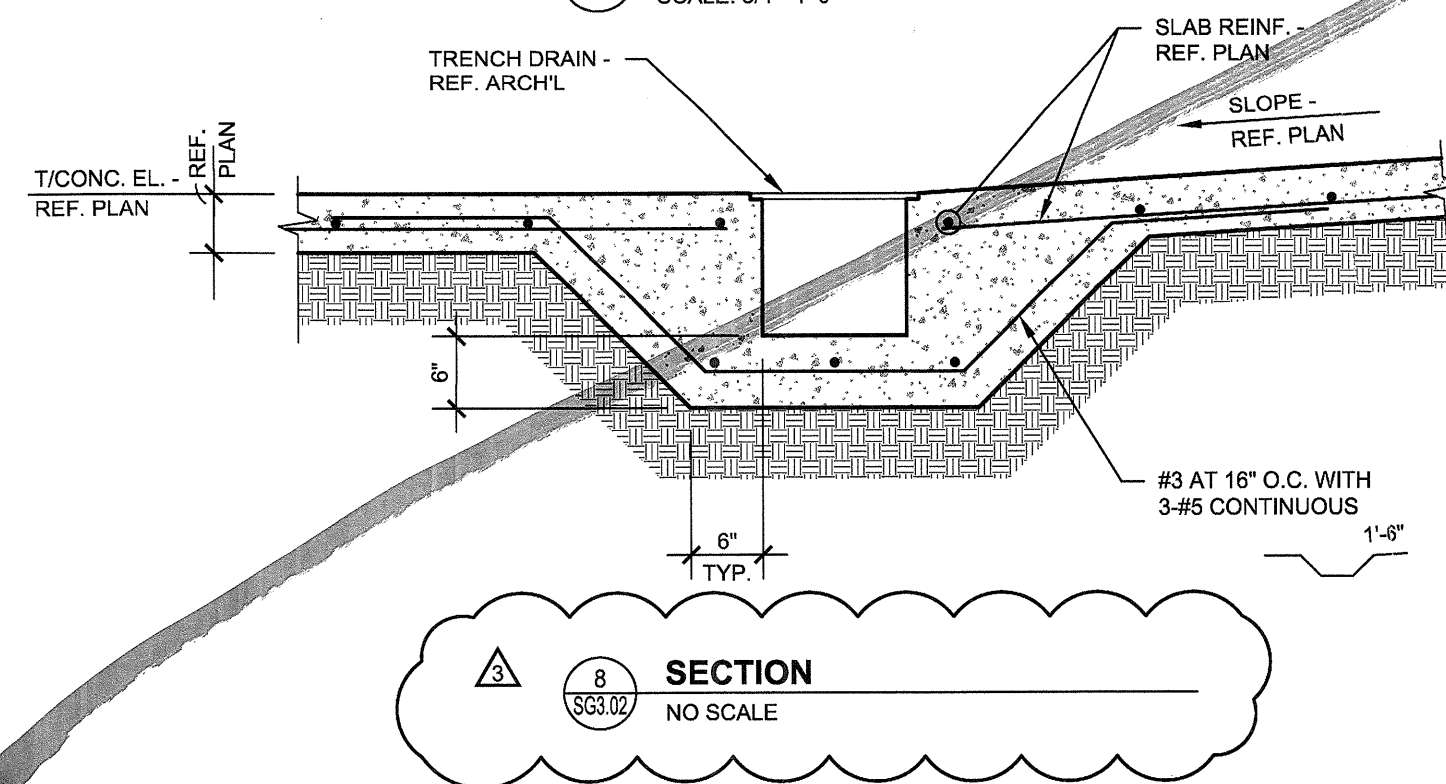

SECTION 8
NO SCALE

REVISIONS	
△ PRECAST SUBMITTAL COORDINATION	10/17/11
△ SLAB ON VOID FOUNDATION	11/18/11
△ PRECAST SUBMITTAL COORDINATION	01/04/12

KELLER SPRINGS LOFTS
LOFT APARTMENTS IN ADDISON, TEXAS

CONSTRUCTION ISSUE
10-17-2011


BGO architects
4144 N. Central Exp., Suite 855
Dallas, TX 75204
214.520.8878
bgoarchitects.com

DATE
08-05-2011


PROJECT
11129

SHEET NUMBER

SG3.02

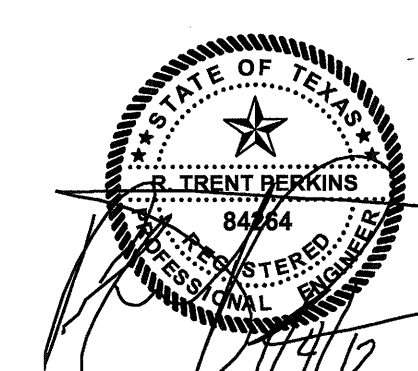

THE SEAL APPEARING ON THIS DOCUMENT WAS AUTHORIZED BY R. TRENT PERKINS, P.E. 84264

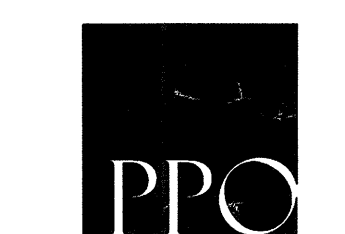

PARKIN - PERKINS - OLSEN
CONSULTING ENGINEERING, INC.
9330 LBJ Freeway Suite 1055
Dallas, Texas 75243
Tel. 214.221.2220 Fax 214.221.2232
Project No. 39155
Registration No. F-1479

THIS DOCUMENT IS THE RENDERING OF A PROFESSIONAL SERVICE, THE ESSENCE OF WHICH IS THE PROVIDING OF ADVICE, JUDGEMENT, OPINION, OR SIMILAR PROFESSIONAL SKILL.