




SECTION 1
SCALE: 3/4"=1'-0"

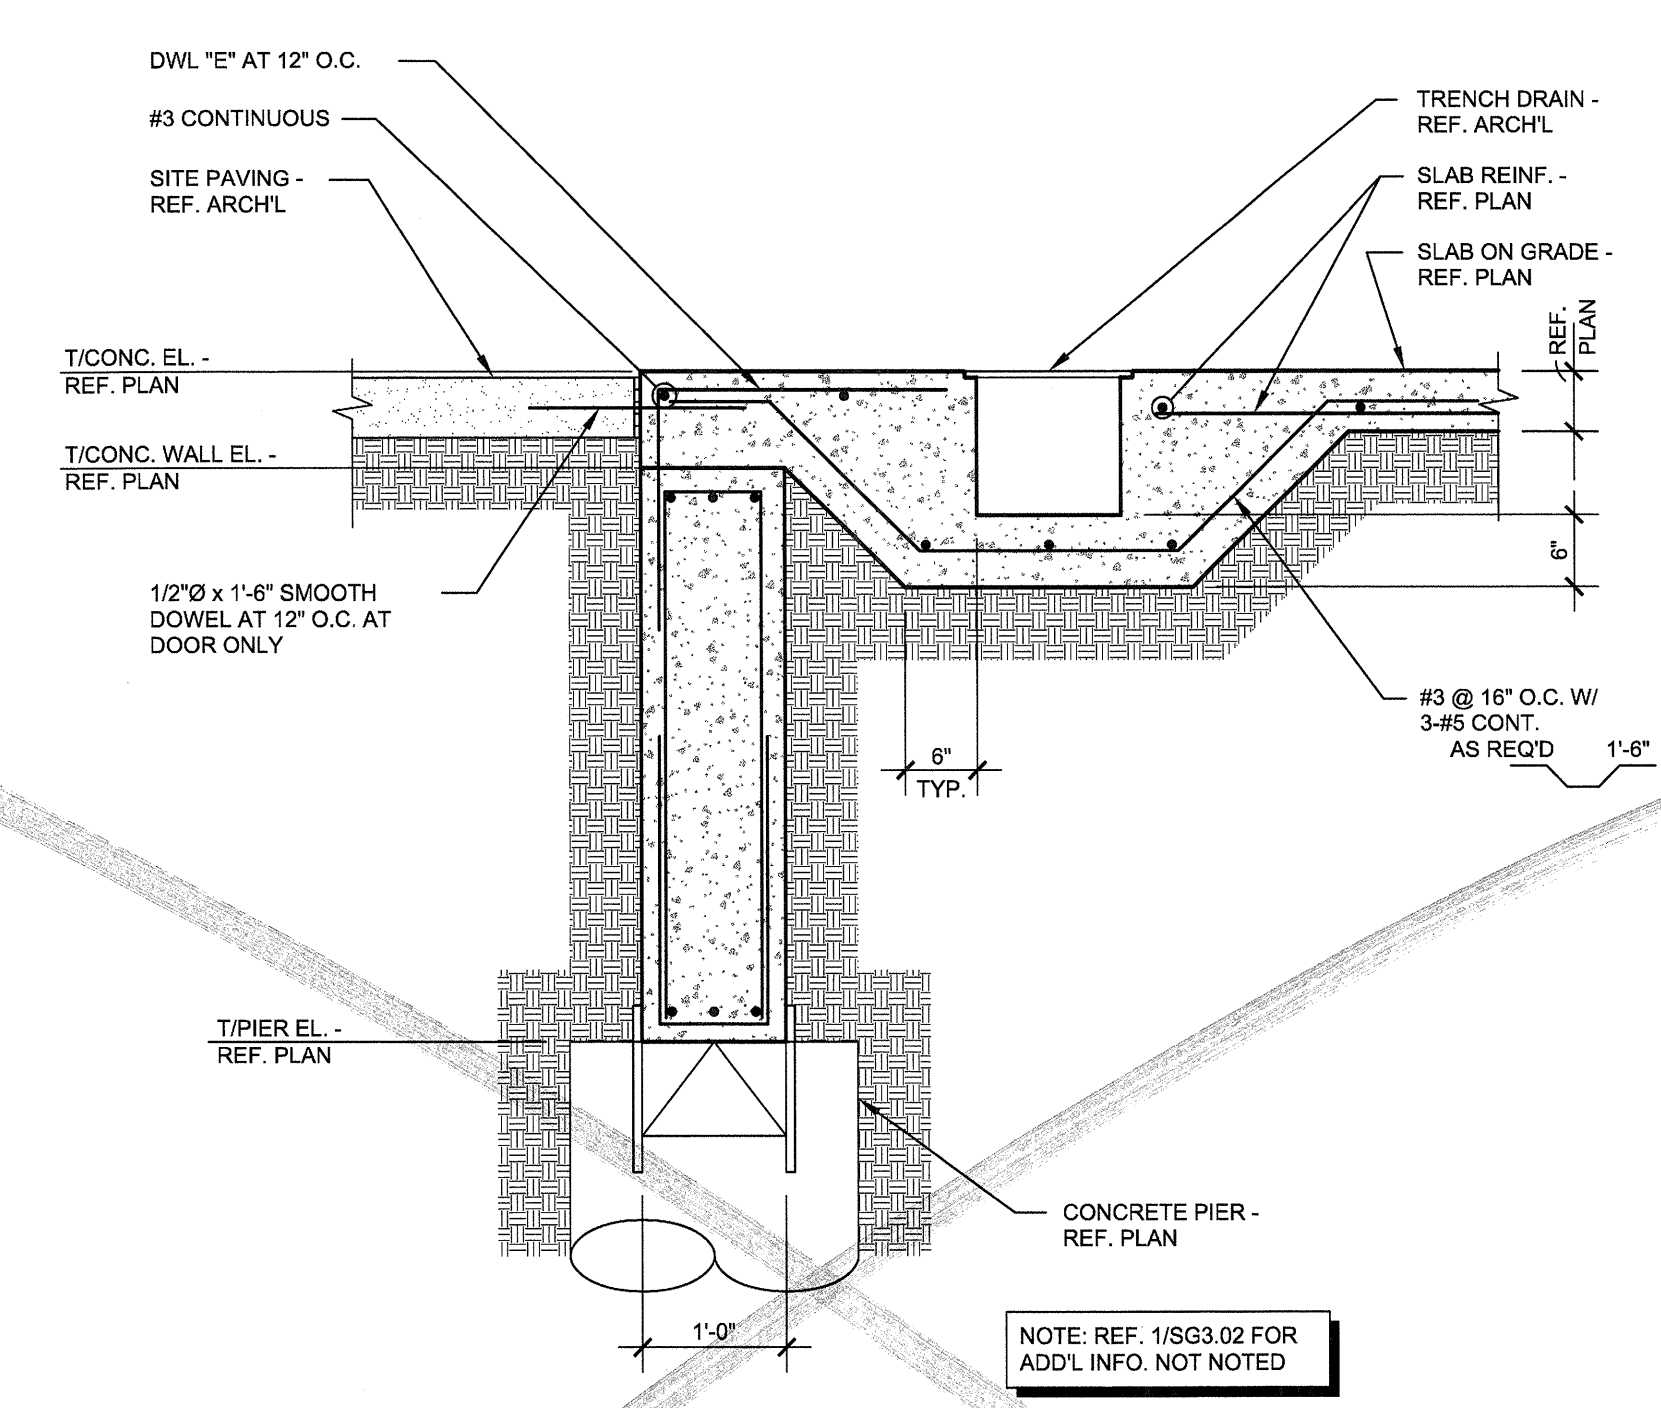


SECTION 2
SCALE: 3/4"=1'-0"

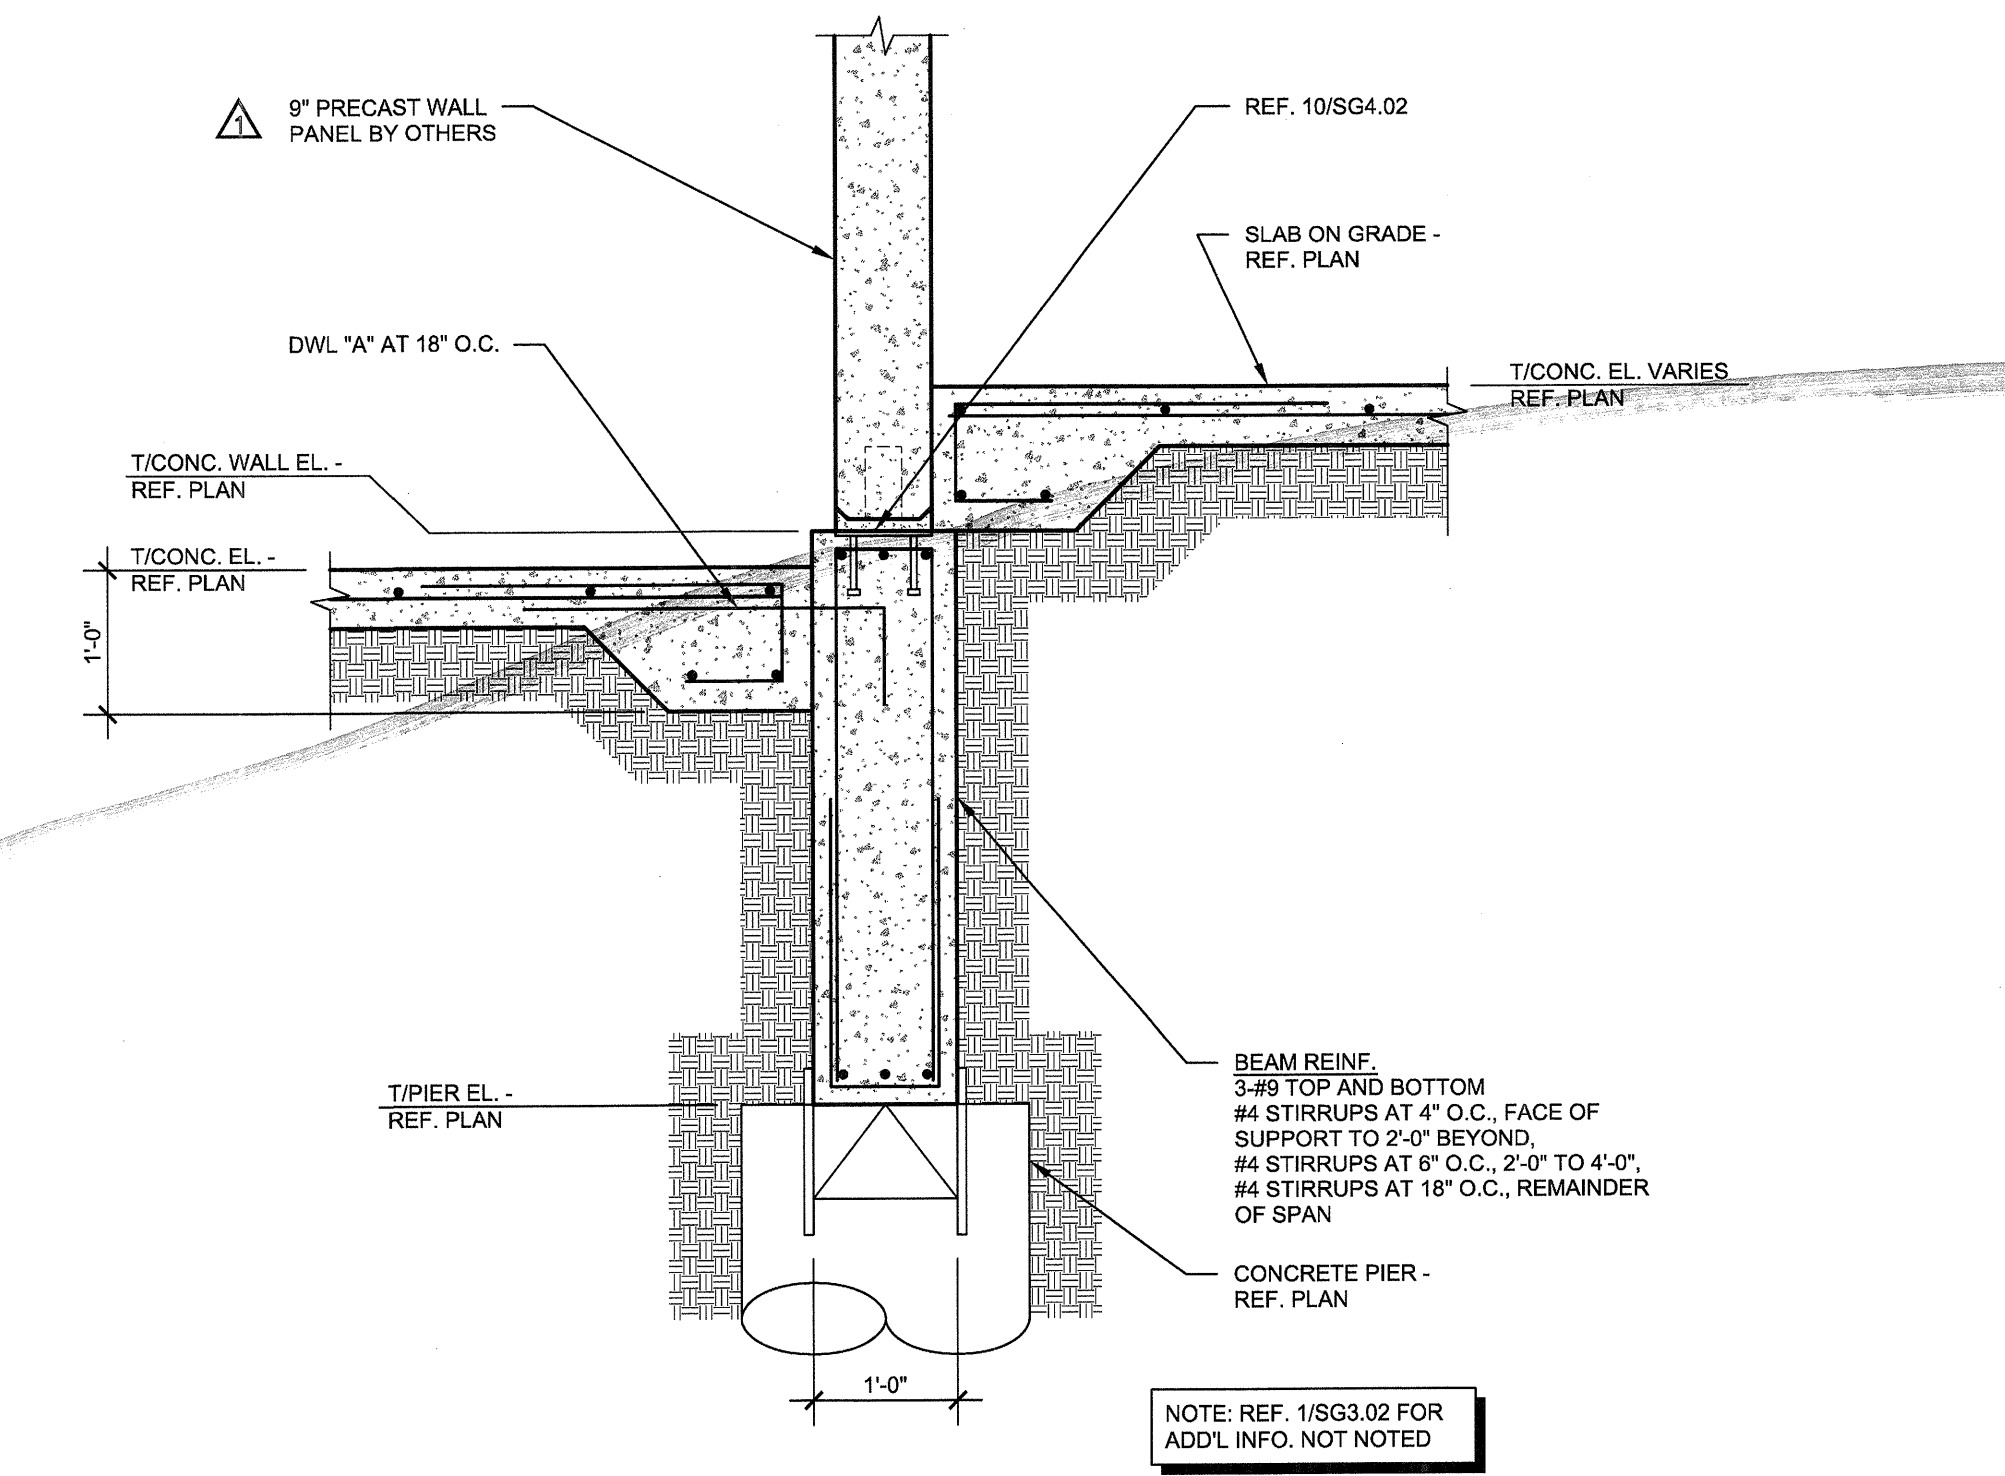


SECTION 3
SCALE: 3/4"=1'-0"

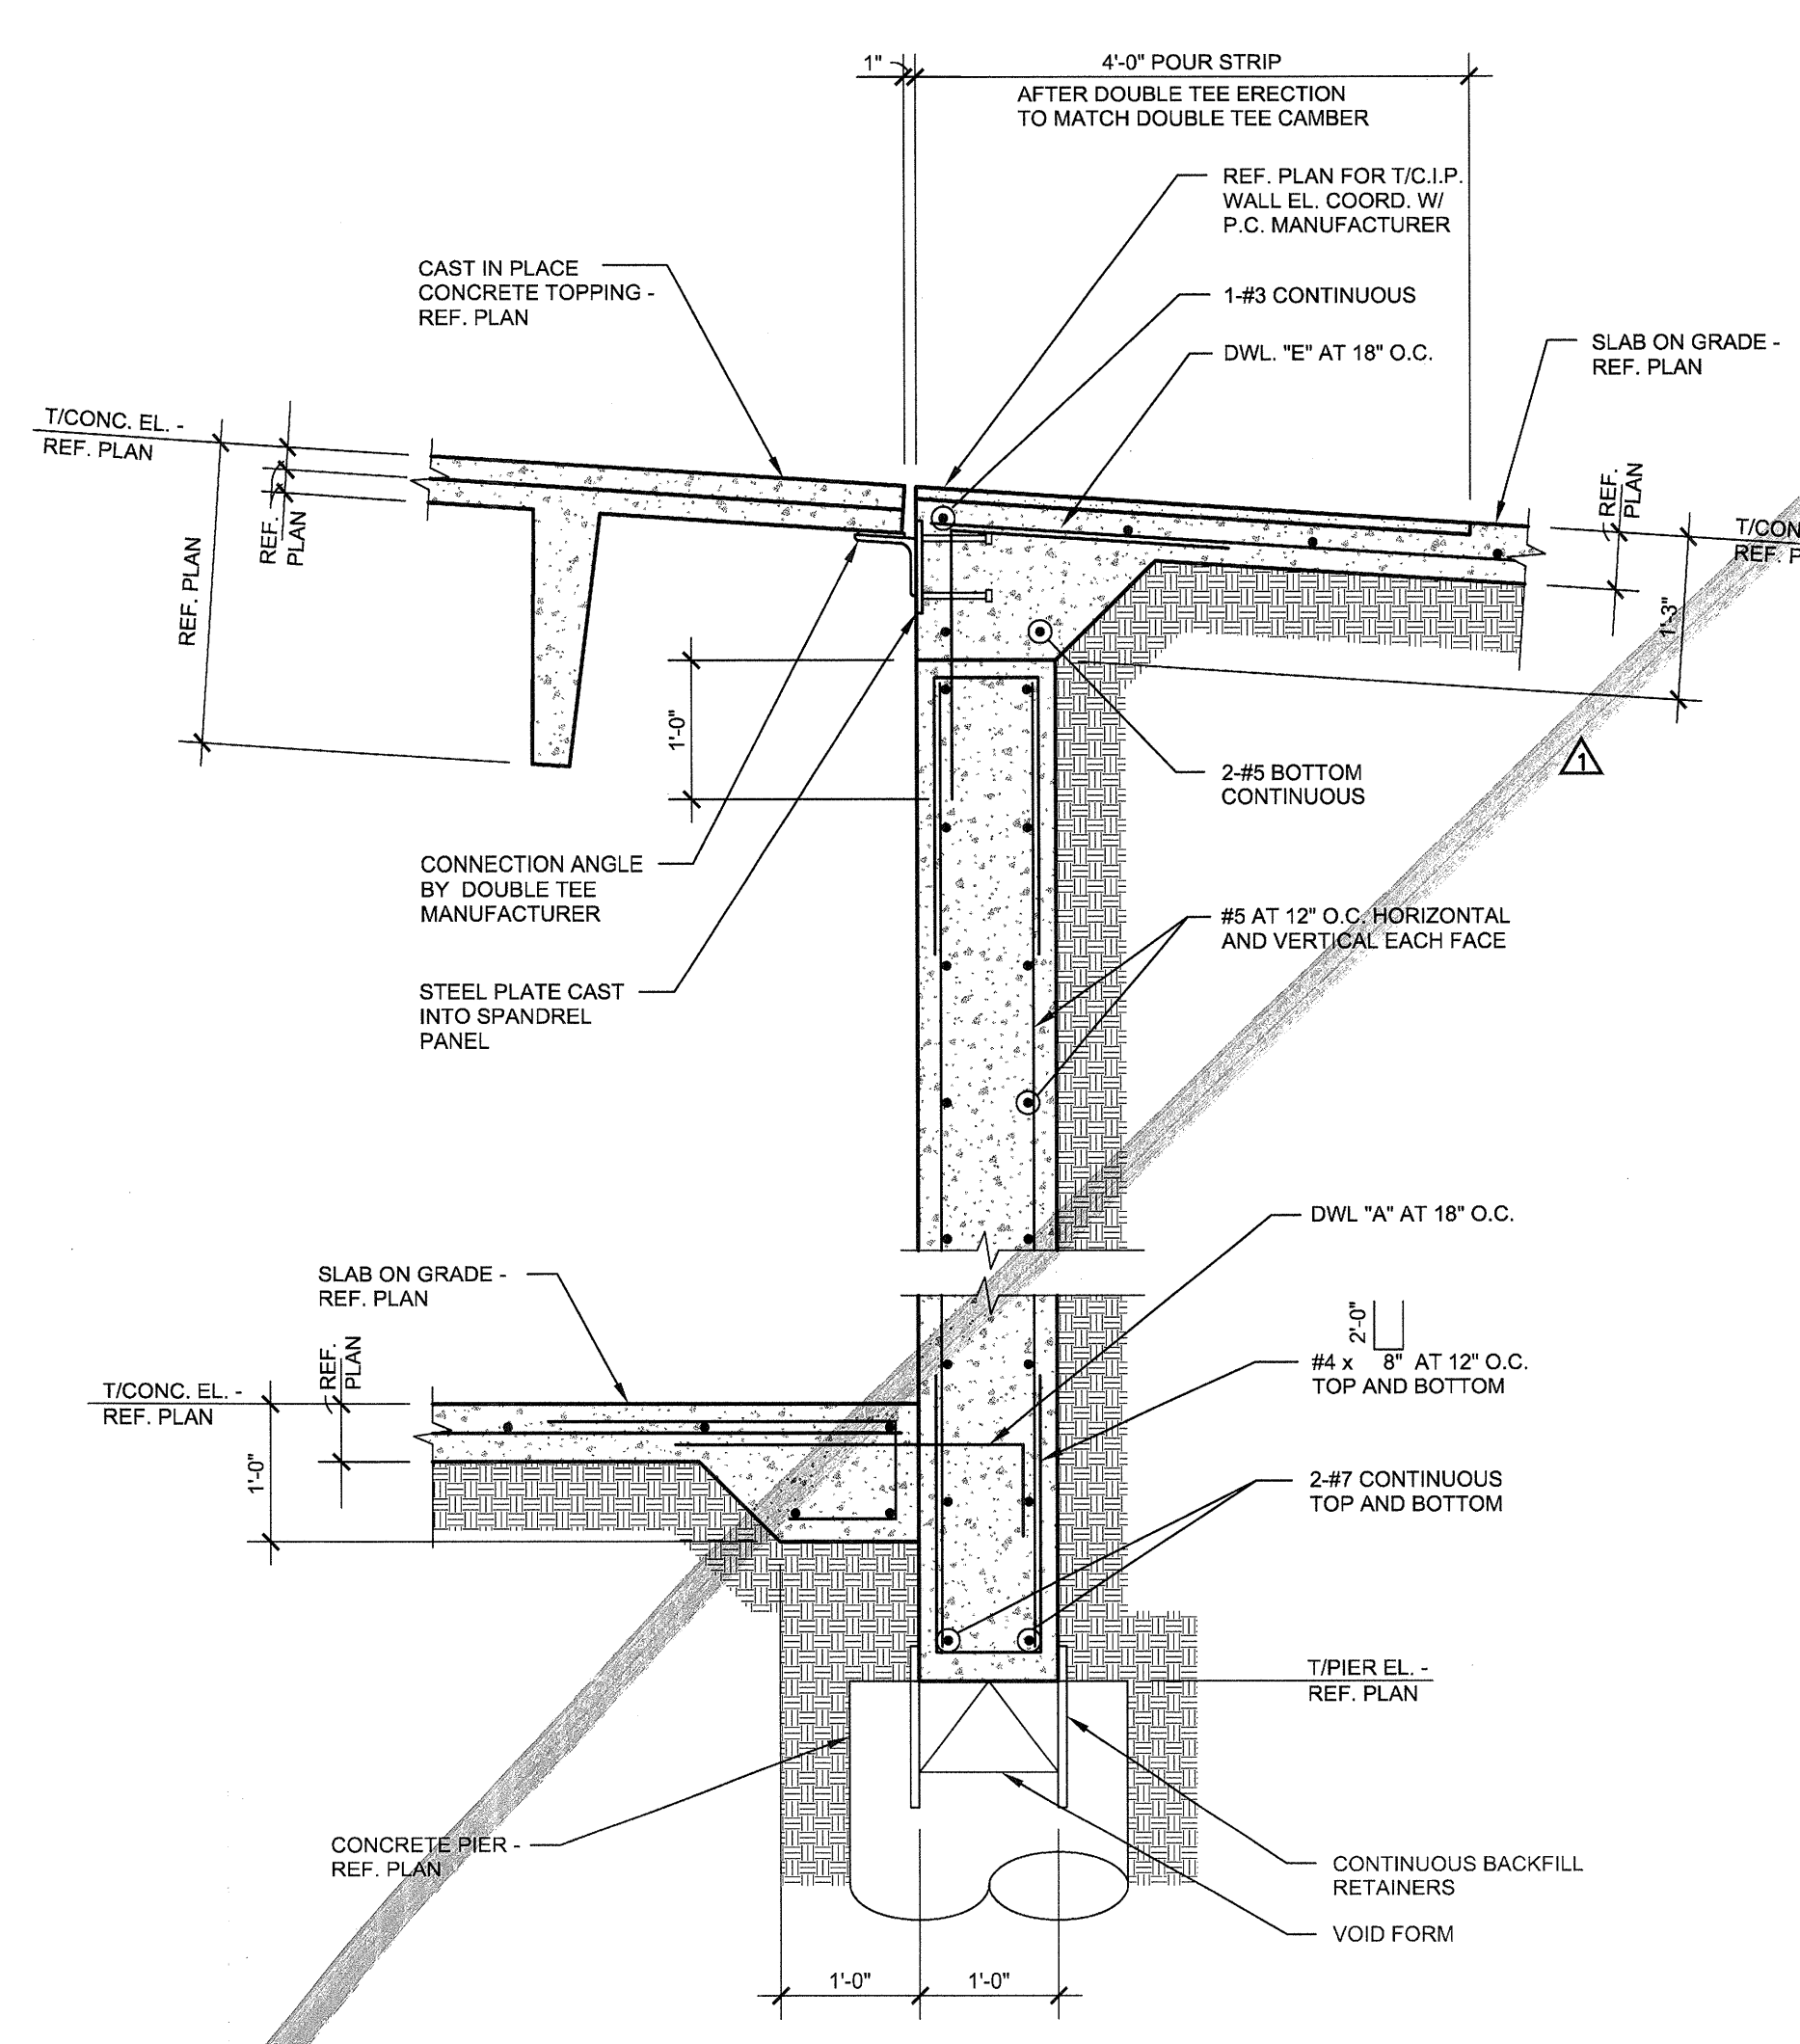


SECTION 4
SCALE: 3/4"=1'-0"

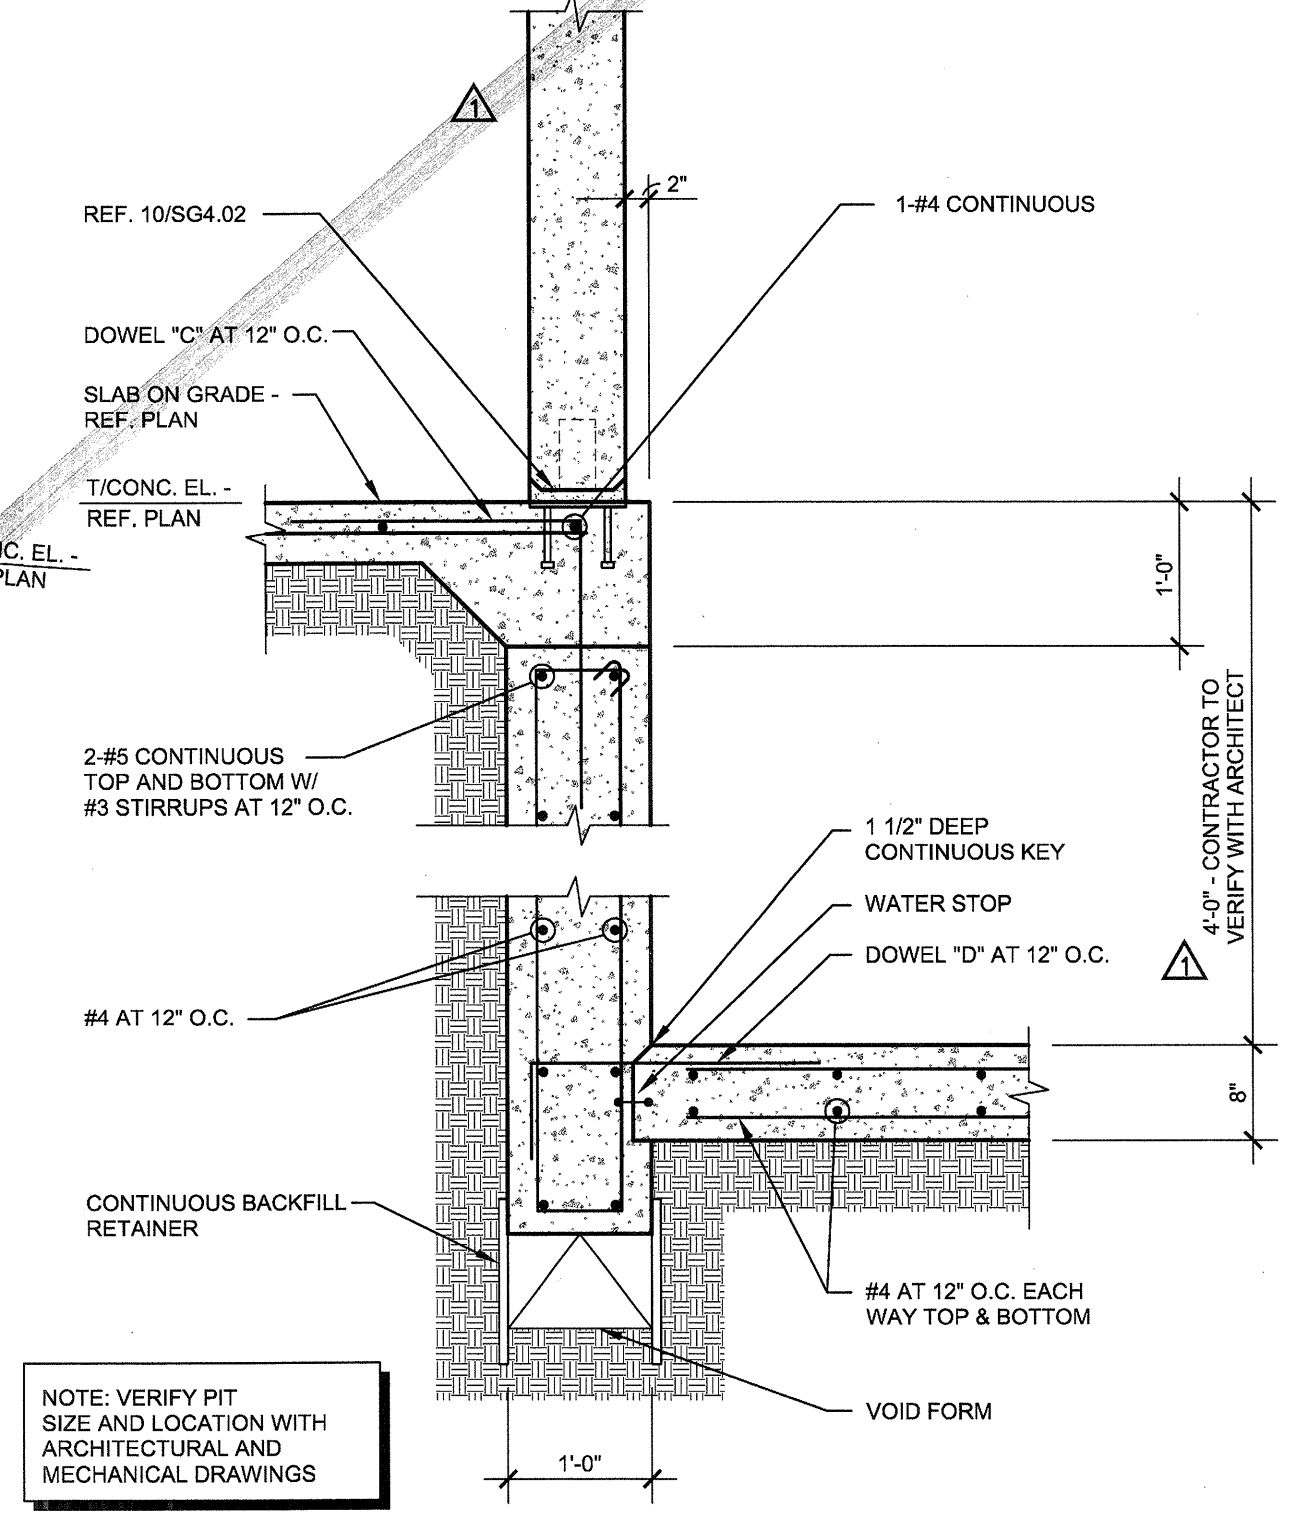

TYPICAL PIT WALL SECTION
NO SCALE

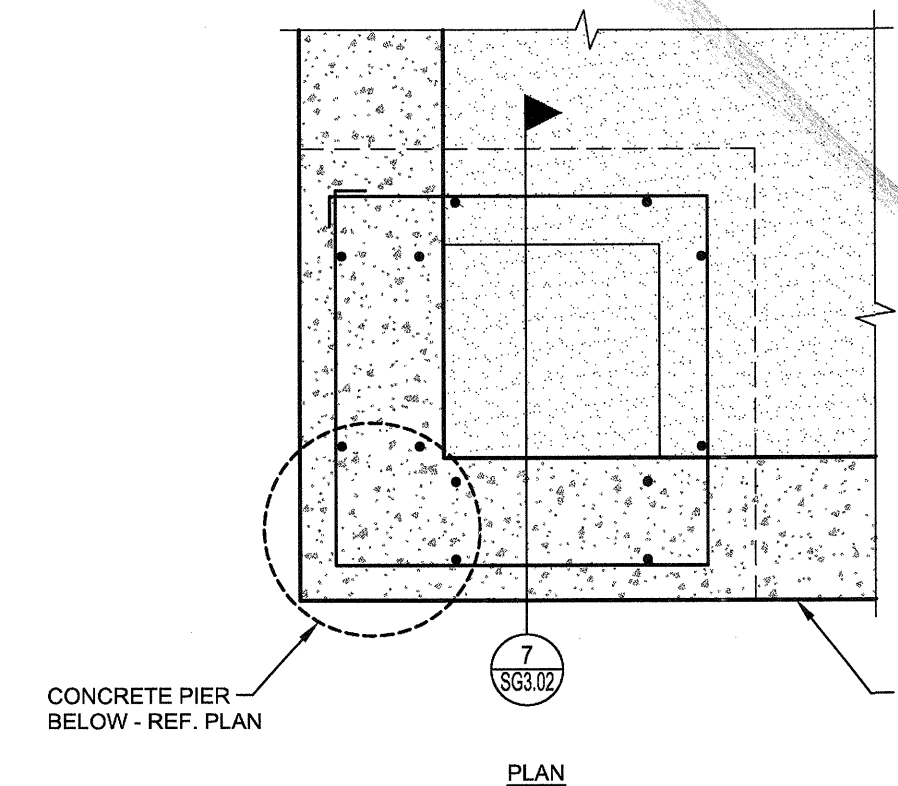

TYPICAL ELEVATOR SUMP PIT DETAIL
NO SCALE

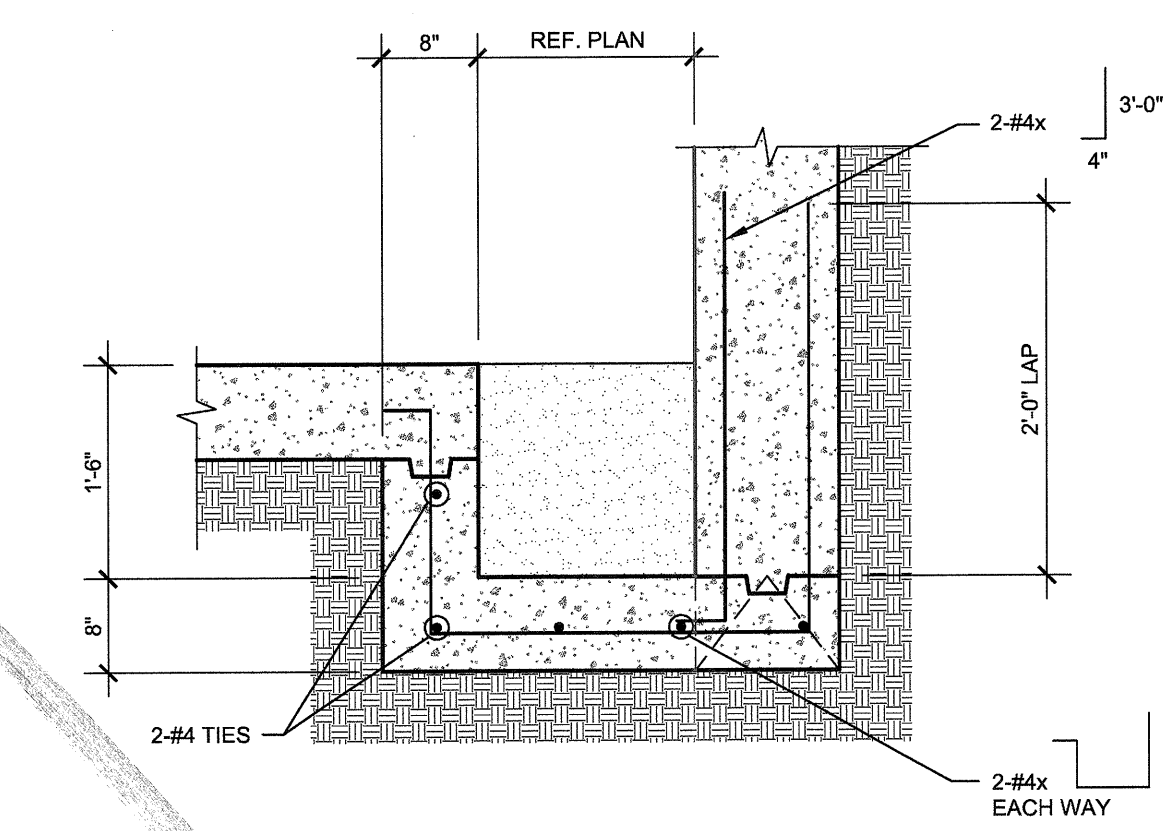

TYPICAL ELEVATOR SUMP PIT DETAIL
NO SCALE

REVISIONS	
△ PRECAST SUBMITTAL COORDINATION	10/17/11
△ SLAB ON VOID FOUNDATION	11/18/11

KELLER SPRINGS LOFTS
LOFT APARTMENTS IN ADDISON, TEXAS

CONSTRUCTION ISSUE
10-17-2011

BGO architects
4144 N. Central Exp., Suite 855
Dallas, TX 75204
214.520.8878
bgoarchitects.com

DATE
08-05-2011

PROJECT
11129

SHEET NUMBER

SG3.02

THE SEAL APPEARING ON THIS DOCUMENT WAS AUTHORIZED BY
R. TRENT PERKINS
84284
PROFESSIONAL ENGINEER
STATE OF TEXAS
11/18/11

PARKIN - PERKINS - OLSEN
CONSULTING ENGINEERING, INC.
9330 LBJ Freeway Suite 1055
Dallas, Texas 75243
Tel 214.221.2220 Fax 214.221.2252
Project No. 39155 Registration No. R-1479