



PARKING GARAGE SEVENTH LEVEL FRAMING PLAN
SCALE: 3/32"=1'-0"

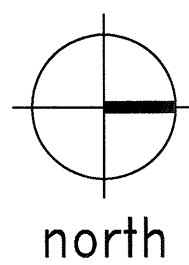

PLAN NOTES:

1. REFER TO SHEETS SG1.01 AND SG1.02 FOR STRUCTURAL NOTES AND SCHEDULES.
2. REFER TO SHEETS SG4.01 - SG4.03 FOR GARAGE DETAILS.
3. T/CONC. = TOP OF CONCRETE ELEVATION. REFER TO CIVIL/SITE PLAN FOR RELATIVE DATUM ELEVATION.
4. REFER TO ARCHITECTURAL AND MECHANICAL DRAWINGS FOR OPENINGS AND PENETRATIONS.
5. ALL PRECAST CONCRETE FRAMING AND COMPONENTS SHALL BE DESIGNED BY THE MANUFACTURER IN ACCORDANCE WITH THE STRUCTURAL NOTES.
6. THE PRECAST CONCRETE MANUFACTURER SHALL COORDINATE THE LOCATION AND SUPPORT OF ALL ELECTRICAL AND MECHANICAL EQUIPMENT WITH THE ARCHITECTURAL AND MECHANICAL DRAWINGS.
7. PRECAST CONCRETE DOUBLE TEES SHALL BE FIELD TOPPED AND 30" DEEP.
8. PRECAST CONCRETE INVERTED TEE BEAMS SHALL BE 31" DEEP WITH AN 14" WIDE STEM AND 7" WIDE CORBELS.
9. CAST IN PLACE CONCRETE TOPPING OVER PRECAST CONCRETE DOUBLE TEES SHALL BE 2 3/4" NORMAL WEIGHT CONCRETE. REINFORCE CONCRETE WITH 6#6 - W4.0x4.0 W.W.F.

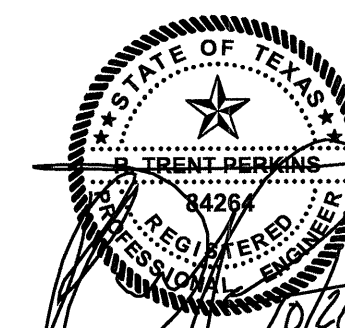

THE SEAL APPEARING ON THIS DOCUMENT WAS AUTHORIZED BY TRENT PERKINS, P.E. 84264

THIS DOCUMENT IS THE RENDERING OF A PROFESSIONAL SERVICE, THE ESSENCE OF WHICH IS THE PROVIDING OF ADVICE, JUDGEMENT, OPINION, OR SIMILAR PROFESSIONAL SKILL.



PARKIN - PERKINS - OLSEN
CONSULTING ENGINEERING, INC.
9330 LBJ Freeway Suite 1055
Dallas, Texas 75243
Tel 214.221.2220 Fax 214.221.2252
Project No. 39155
Registration No. F-1479

REVISIONS

NO.	DATE	DESCRIPTION

KELLER SPRINGS LOFTS
LOFT APARTMENTS IN ADDISON, TEXAS

CONSTRUCTION ISSUE
10-17-2011

BGO architects
4144 N. Central Exp., Suite 855
Dallas, TX 75204
214.520.8878
bgoarchitects.com

DATE
08-05-2011

PROJECT
11129

SHEET NUMBER

SG2.04