



1 SECTION  
S3.04 NO SCALE

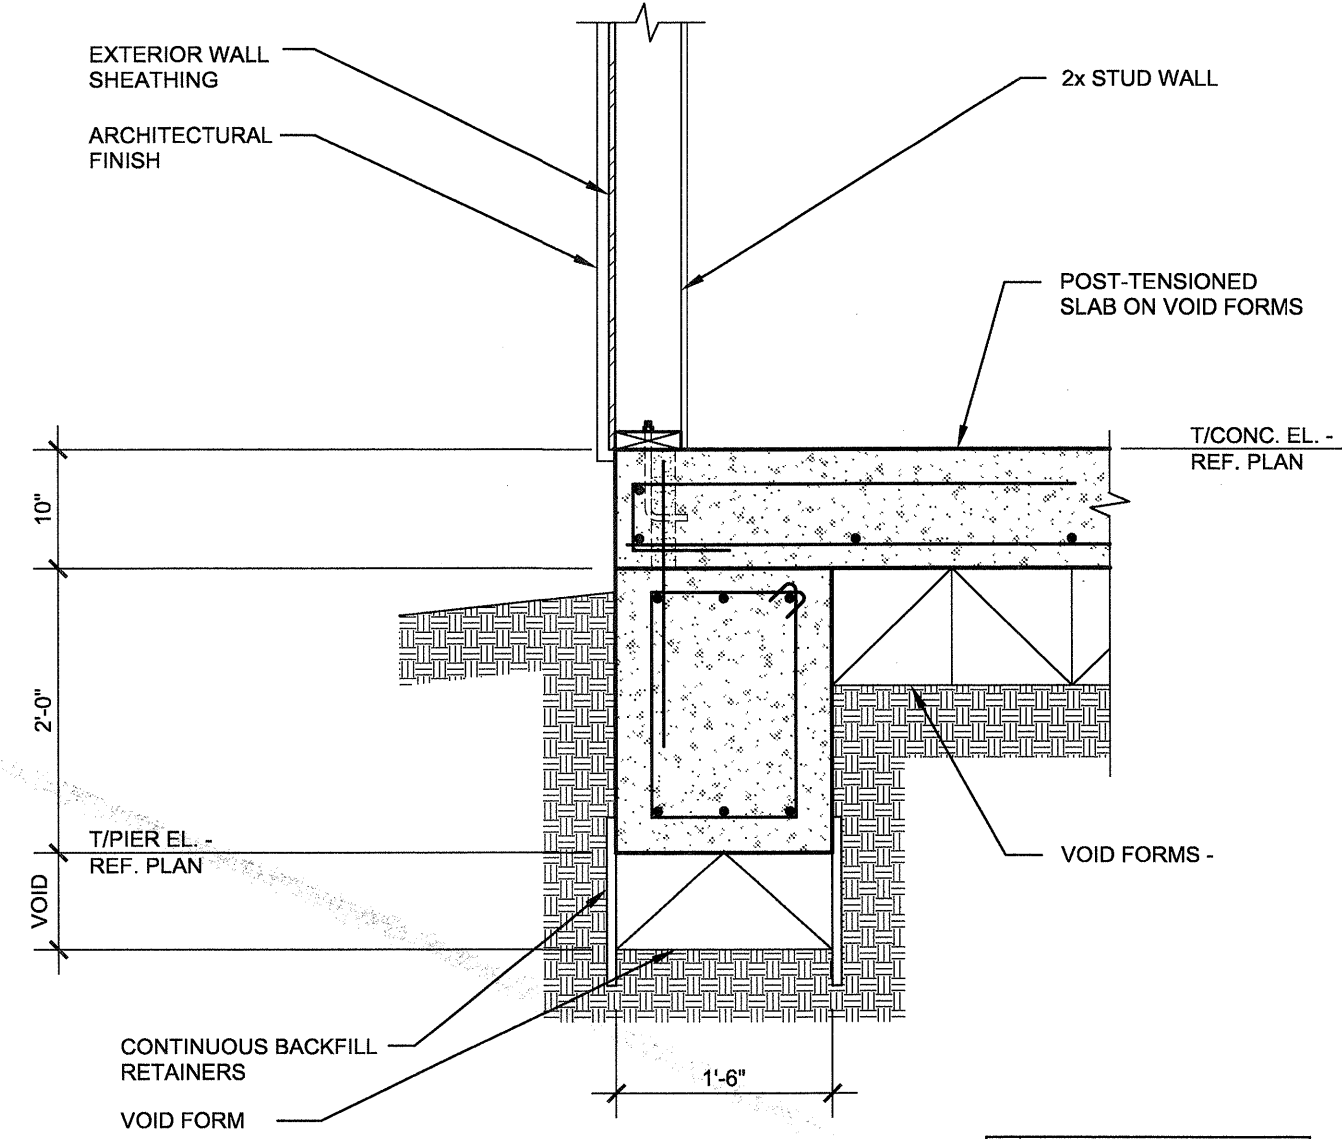


2 SECTION  
S3.04 NO SCALE

NOTE: REF. 1/S3.04 FOR ADD'L INFO. NOT NOTED

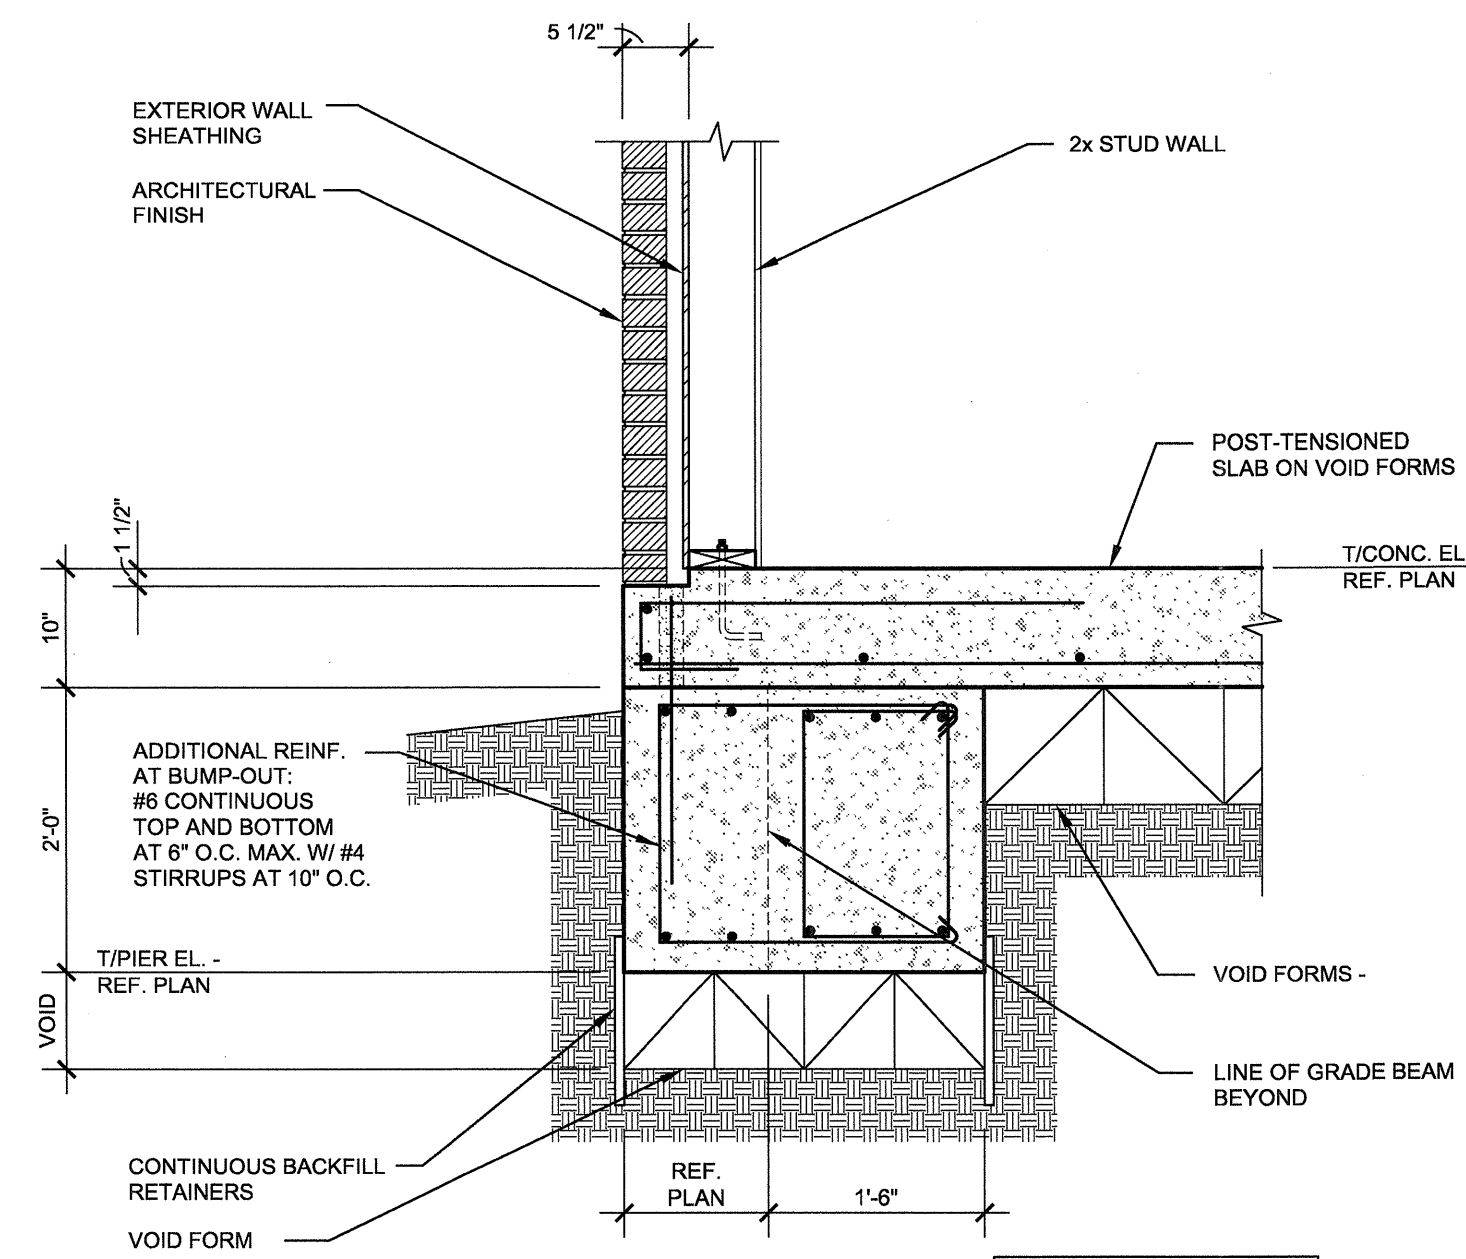


3 SECTION  
S3.04 NO SCALE

NOTE: REF. 1/S3.04 FOR ADD'L INFO. NOT NOTED

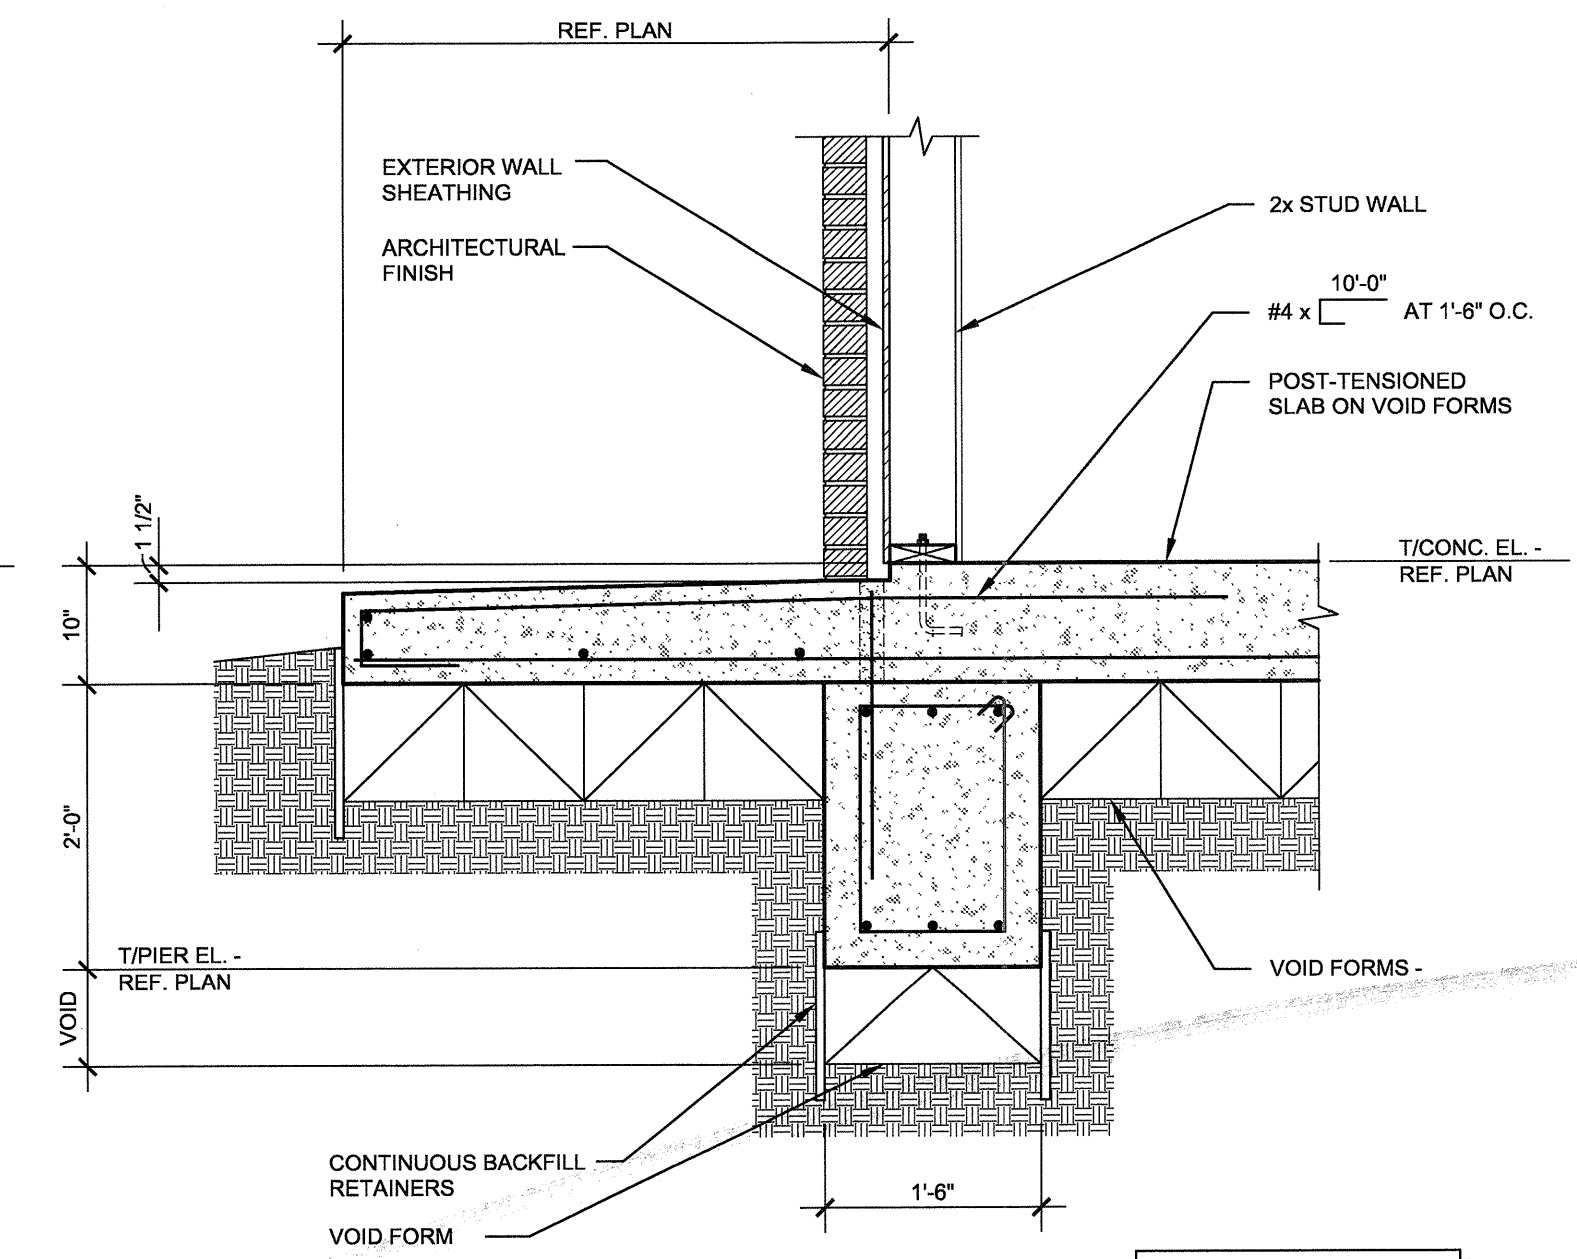


4 SECTION  
S3.04 NO SCALE

NOTE: REF. 1/S3.04 FOR ADD'L INFO. NOT NOTED

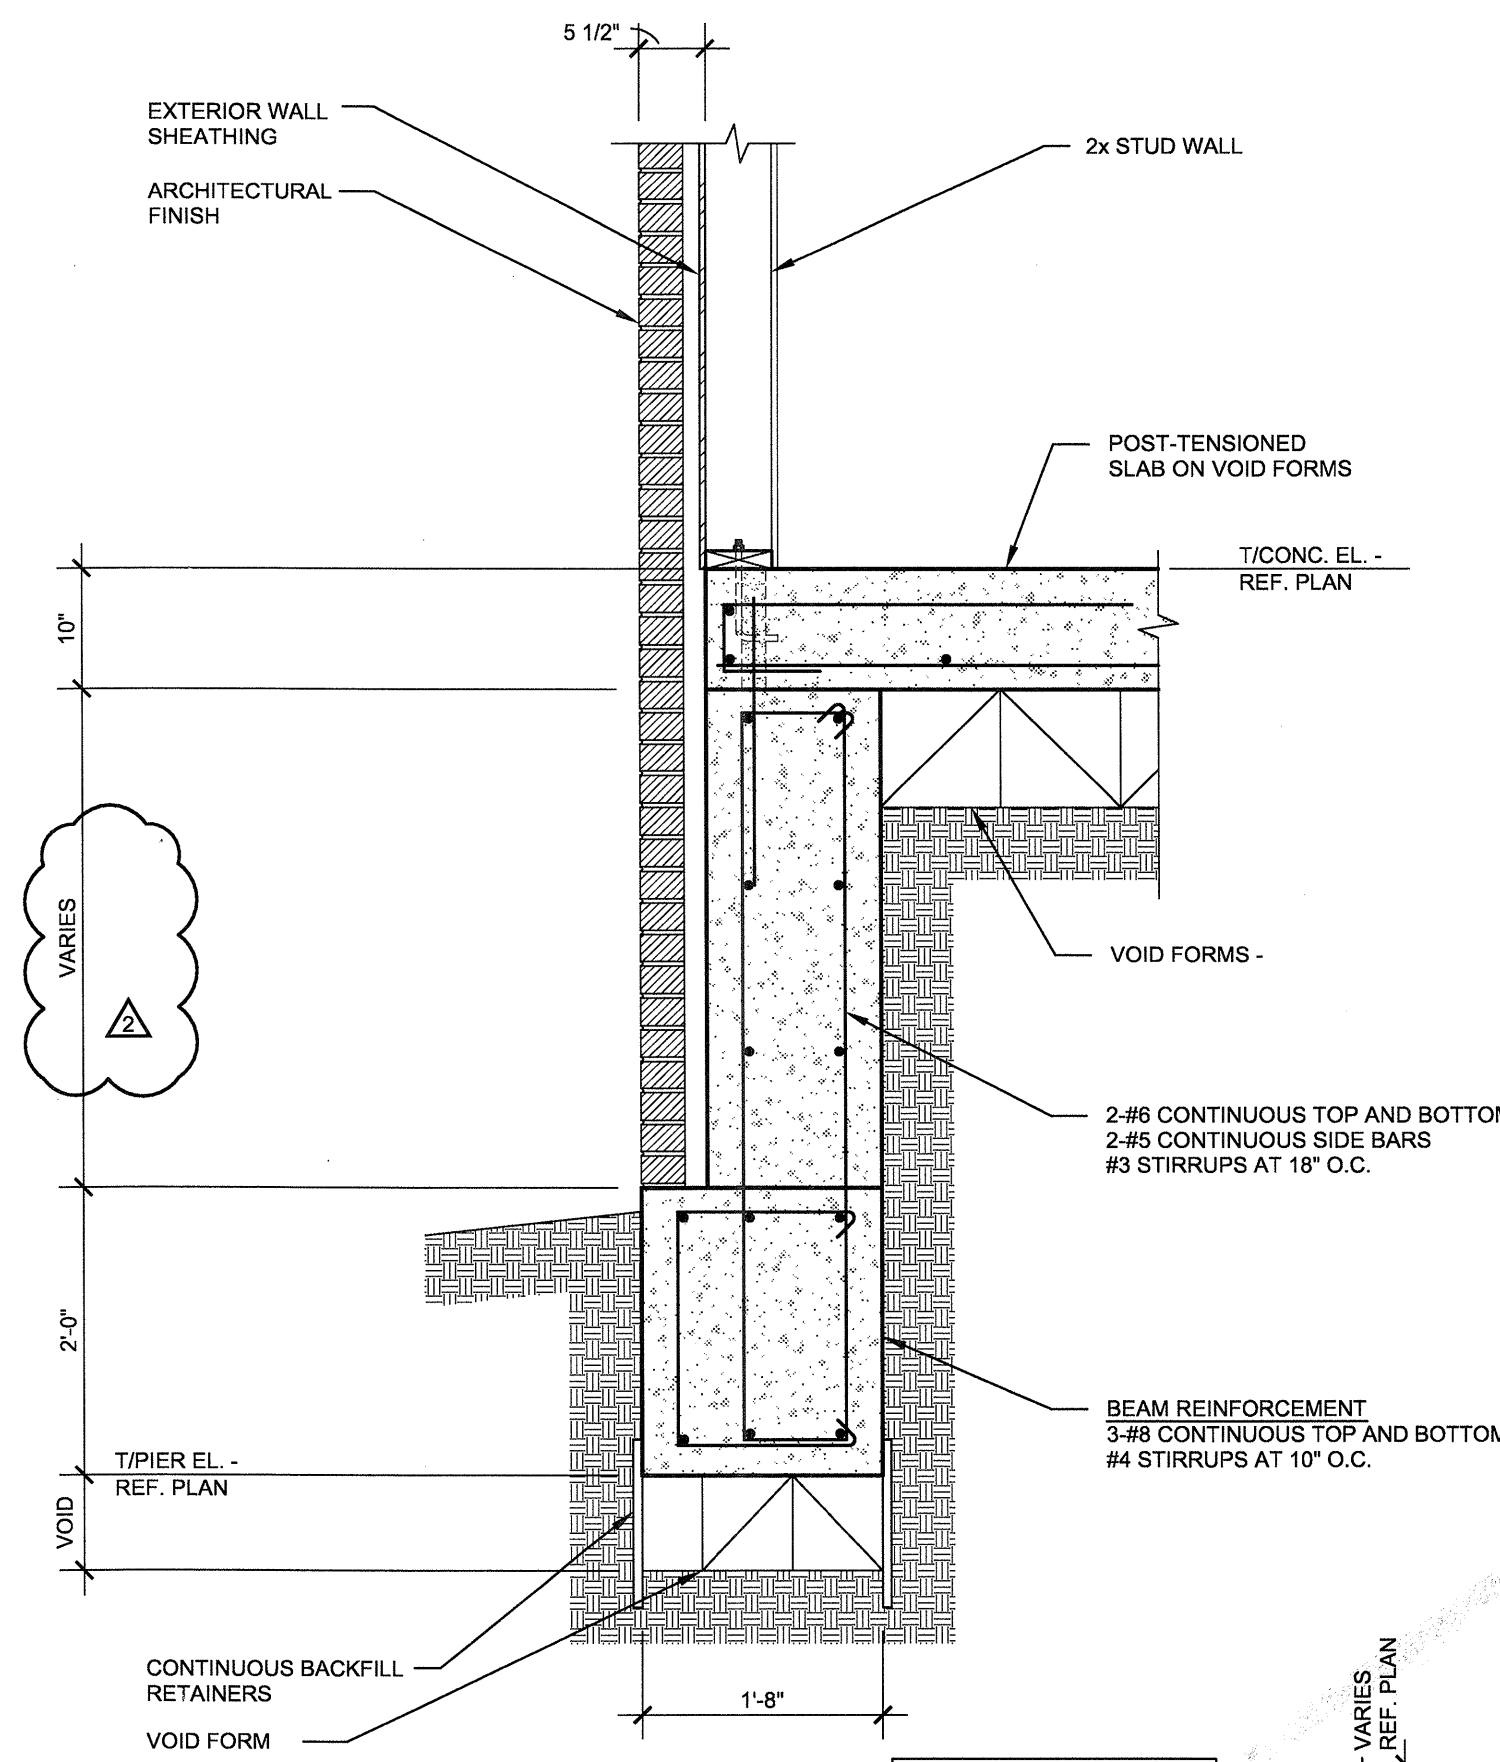


5 SECTION  
S3.04 NO SCALE

NOTE: REF. 1/S3.04 FOR ADD'L INFO. NOT NOTED

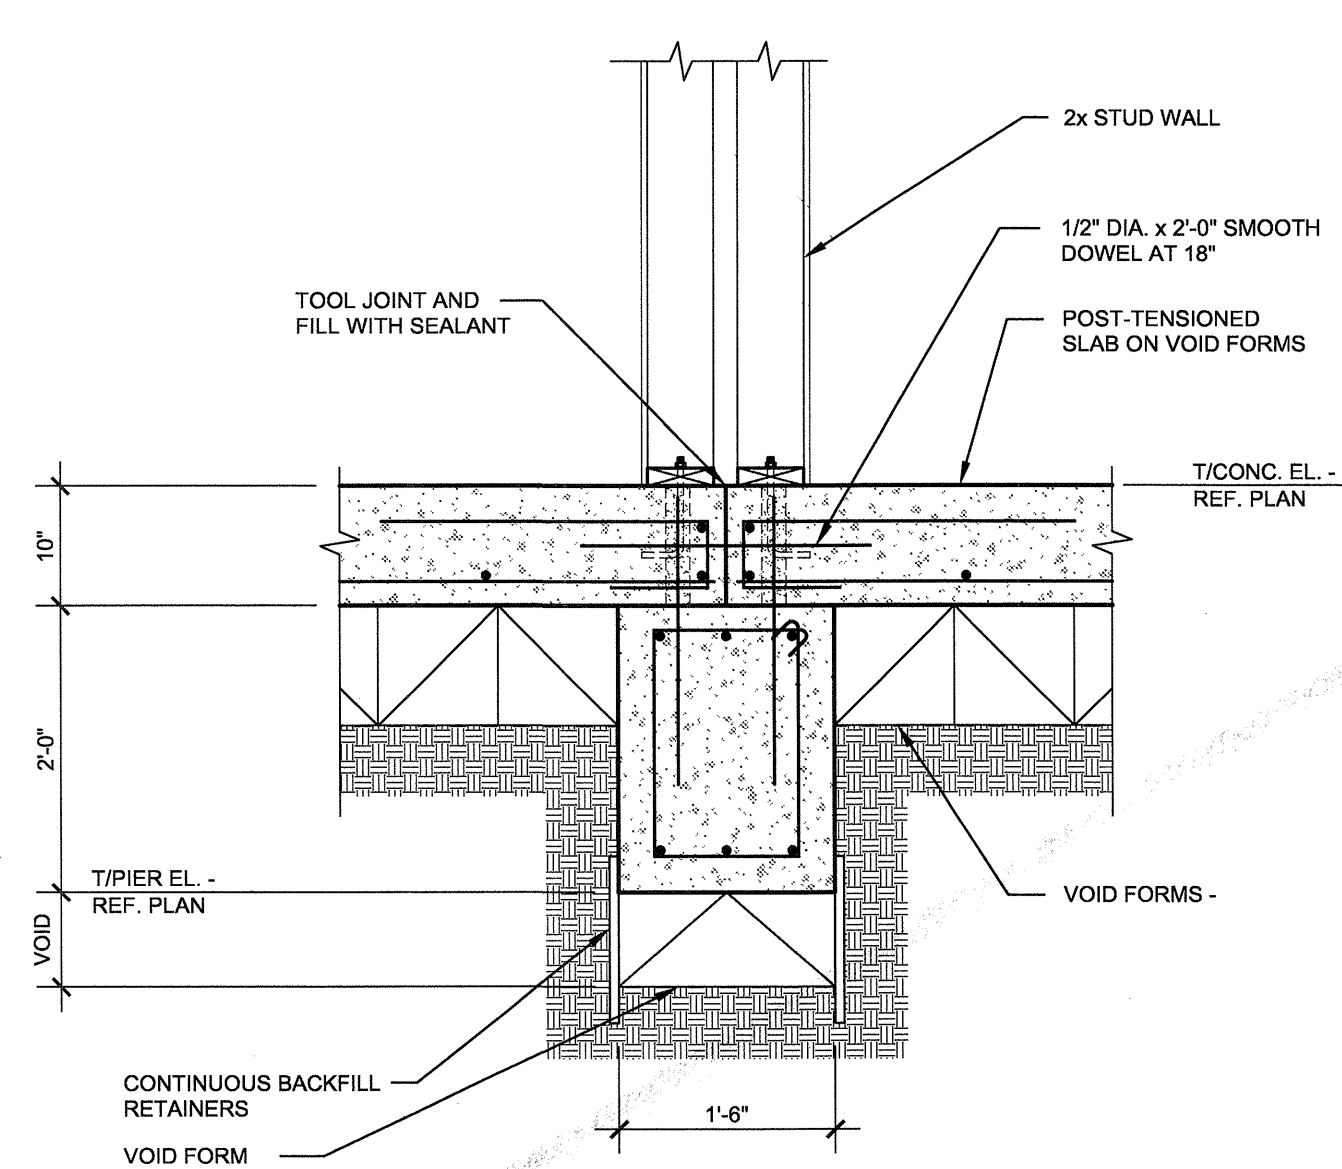


6 SECTION  
S3.04 NO SCALE

NOTE: REF. 1/S3.04 FOR ADD'L INFO. NOT NOTED

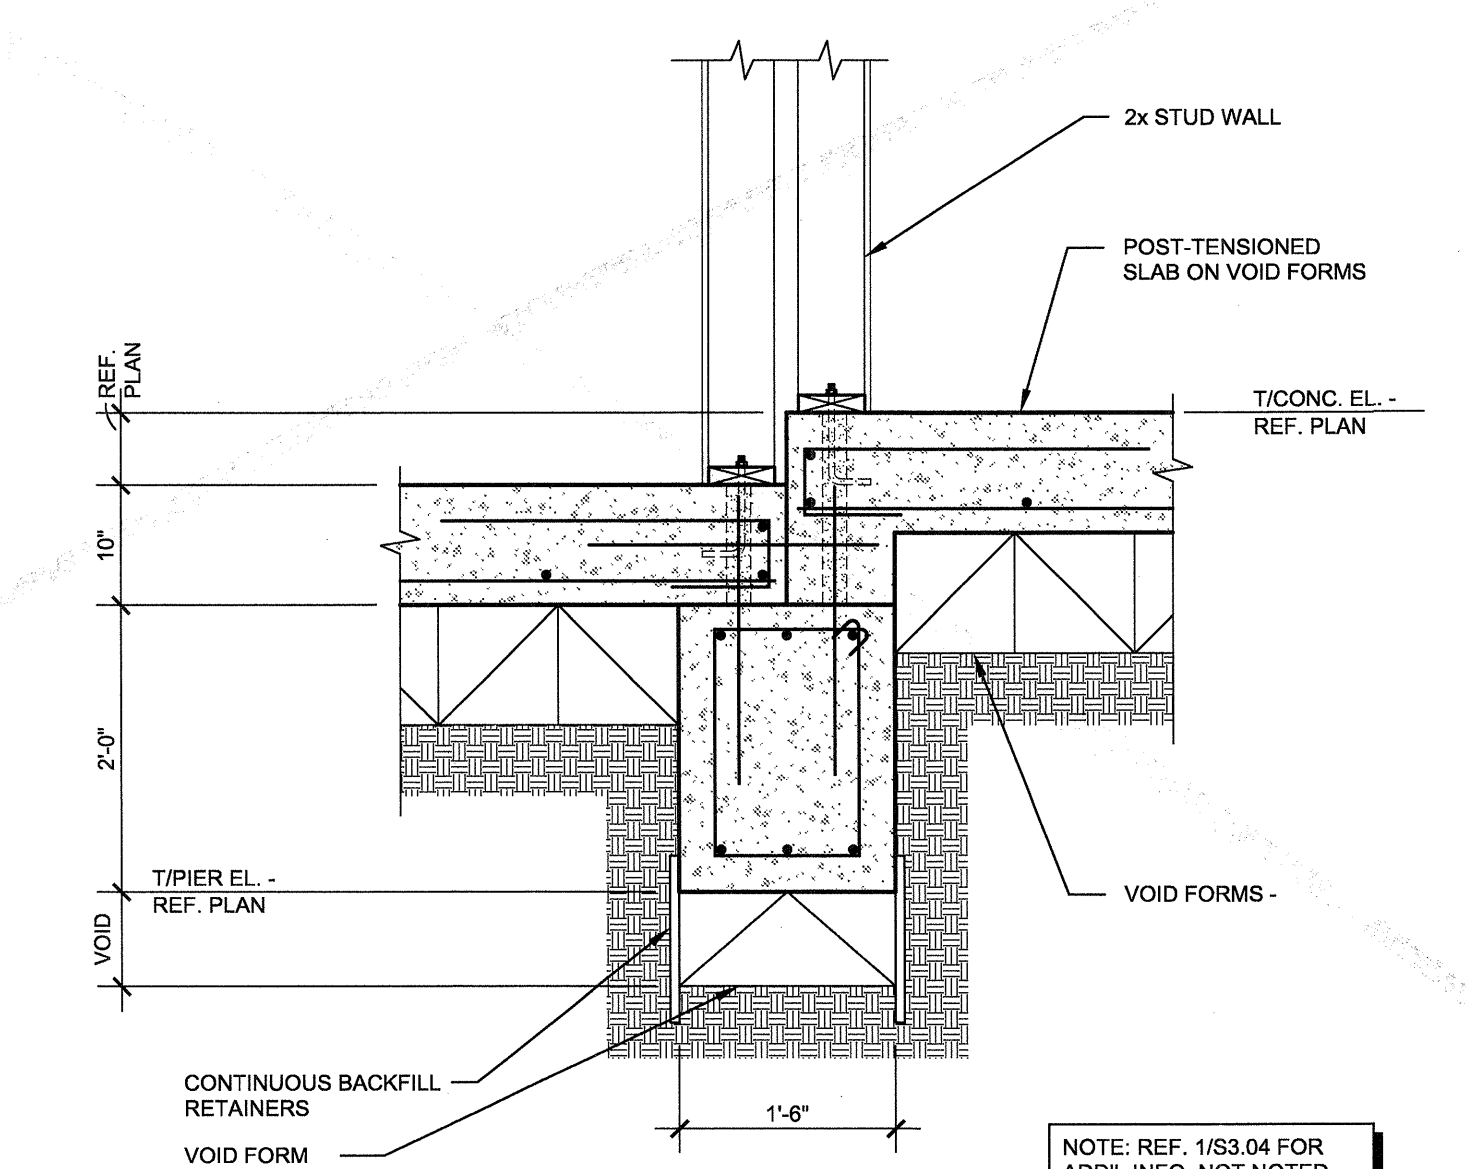


7 SECTION  
S3.04 NO SCALE


NOTE: REF. 1/S3.04 FOR ADD'L INFO. NOT NOTED

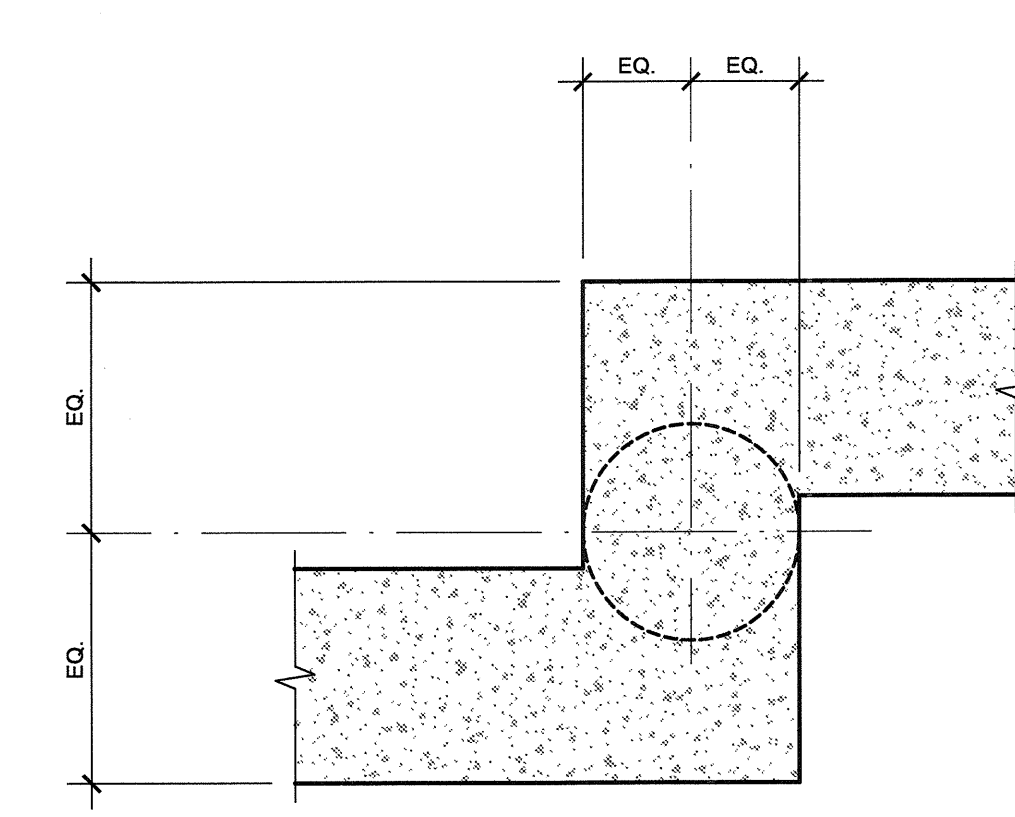


8 PLAN DETAIL  
S3.04 NO SCALE

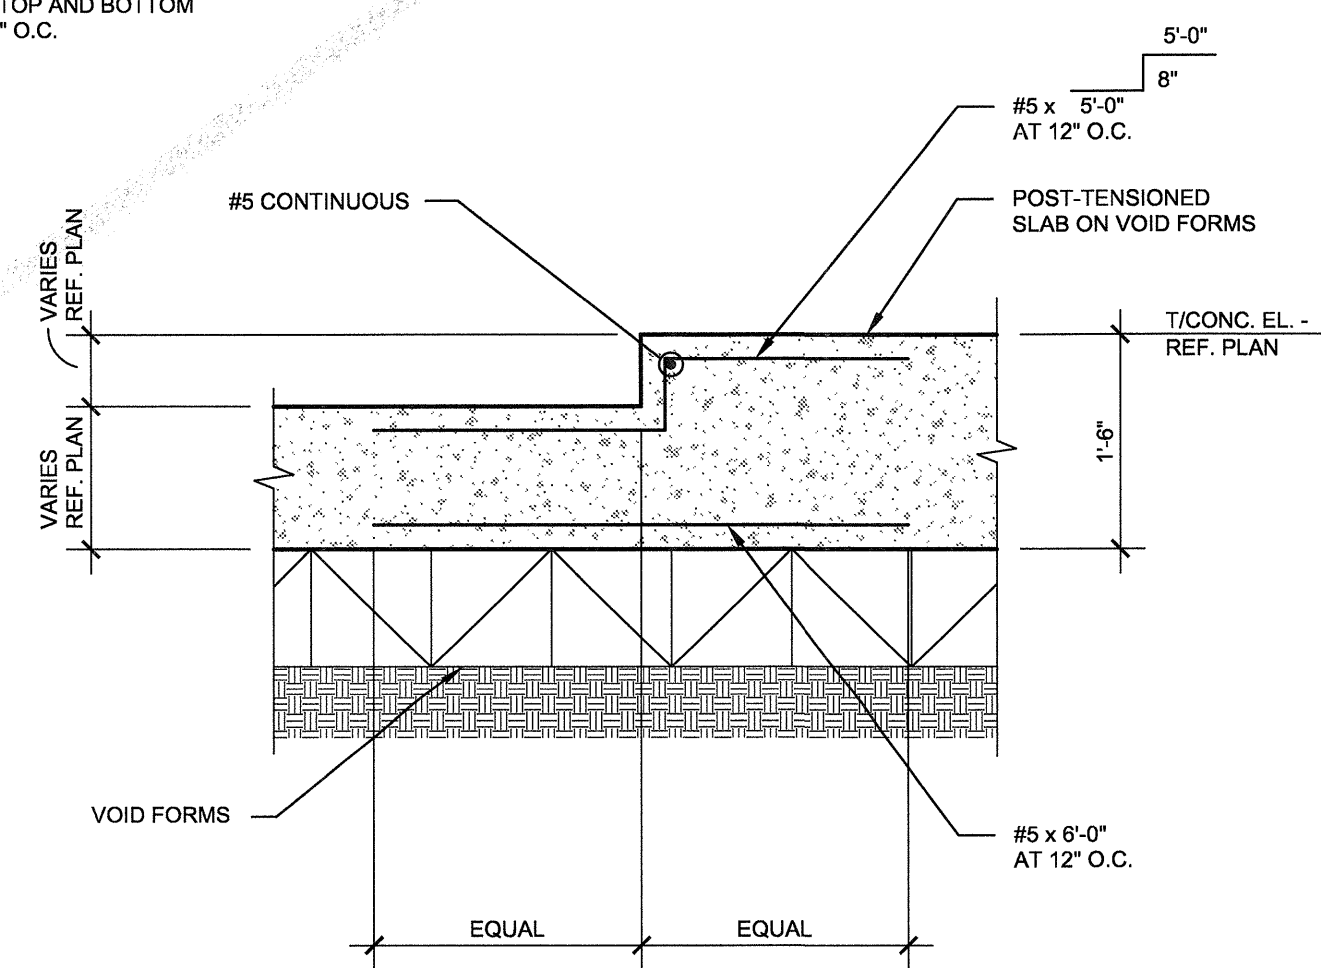

9 SECTION  
S3.04 NO SCALE

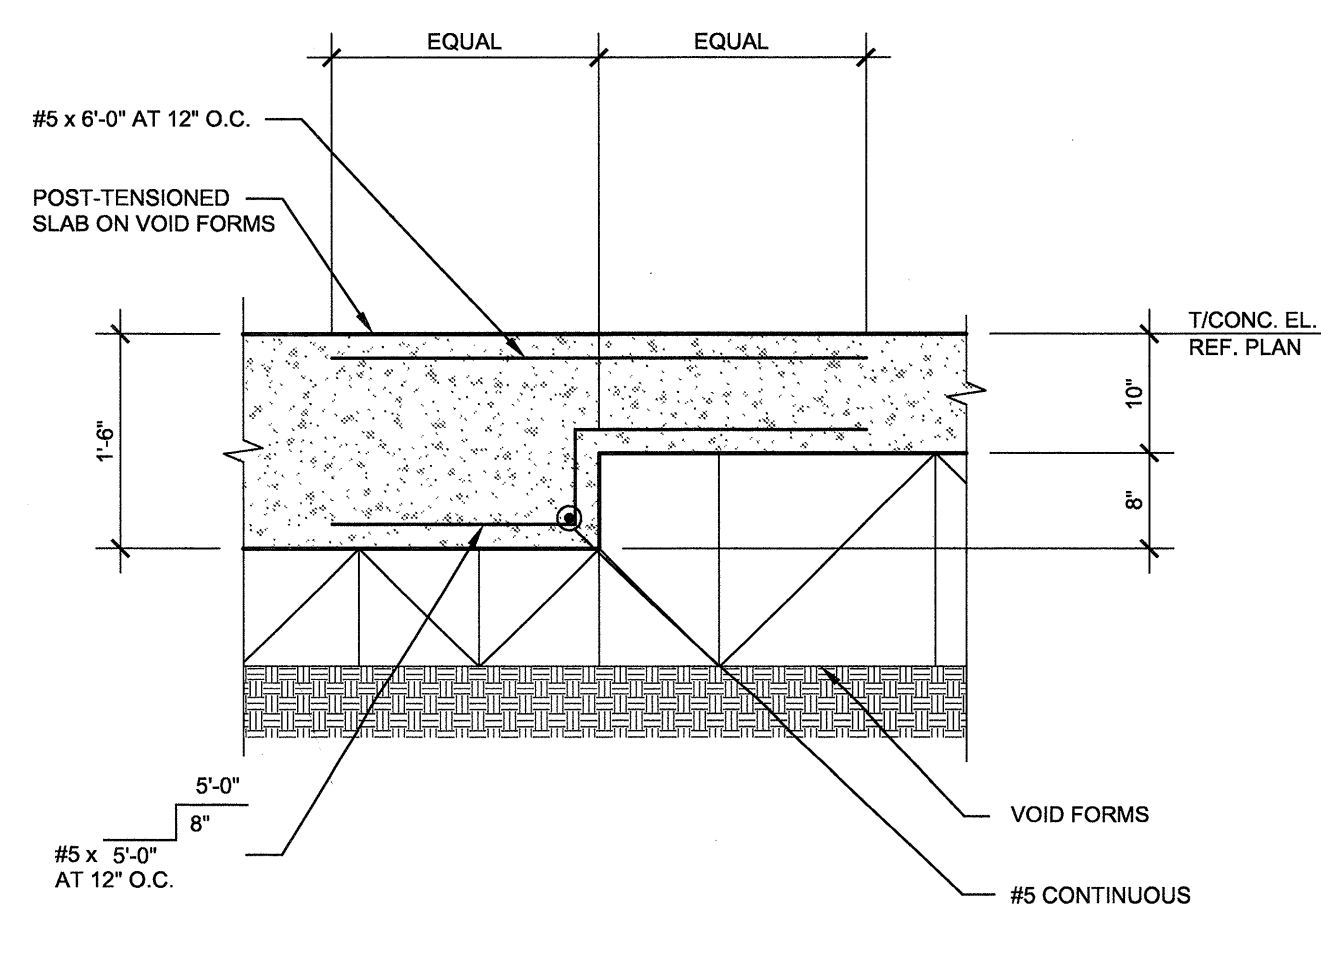


10 SECTION  
S3.04 NO SCALE

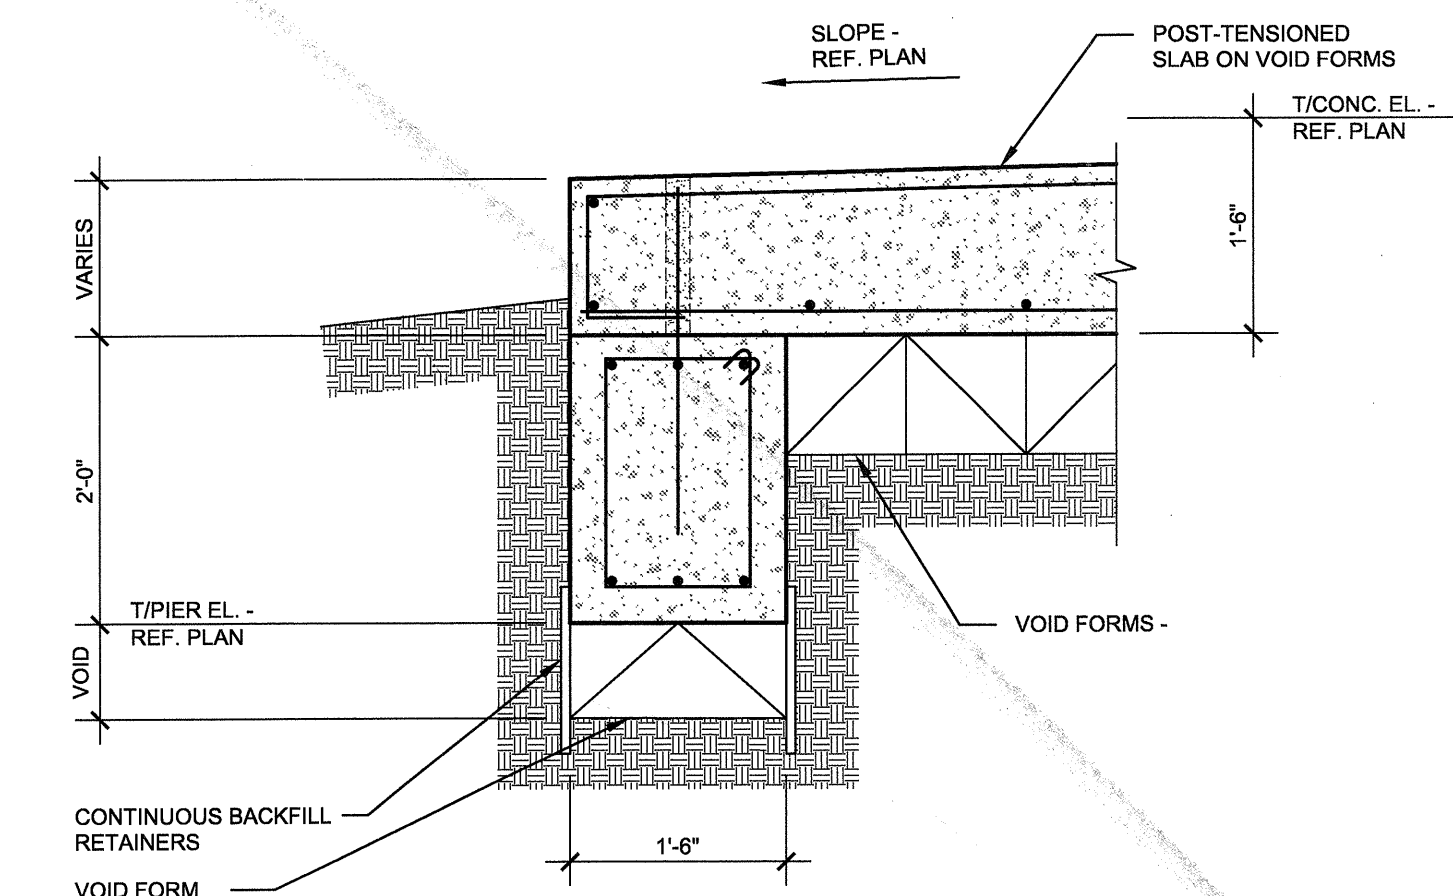


11 SECTION  
S3.04 NO SCALE

NOTE: REF. 1/S3.04 FOR ADD'L INFO. NOT NOTED

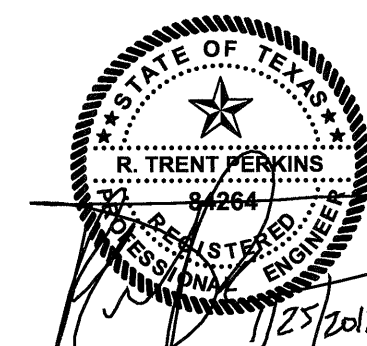

THE SEAL APPEARING ON THIS DOCUMENT WAS AUTHORIZED BY R. TRENT PERKINS, P.E. 84264

THIS DOCUMENT IS THE RENDERING OF A PROFESSIONAL SERVICE, THE ESSENCE OF WHICH IS THE PROVIDING OF ADVICE, JUDGEMENT, OPINION, OR SIMILAR PROFESSIONAL SKILL.

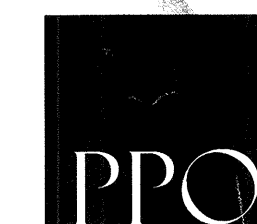

PARKIN - PERKINS - OLSEN  
CONSULTING ENGINEERING, INC.  
9330 LBJ Freeway Suite 1055  
Dallas, Texas 75243  
Tel 214.221.2220 Fax 214.221.2252  
Project No. 39155  
Registration No. F-1479

REVISIONS	
△	SLAB ON VOID FOUNDATION 11/18/2011
△	COORDINATION 01/25/12
△ ?	

**KELLER SPRINGS LOFTS**  
LOFT APARTMENTS IN ADDISON, TEXAS

CONSTRUCTION ISSUE  
10-17-2011



4144 N. Central Expy., Suite 855  
Dallas, TX 75204  
214.520.8878  
bgoarchitects.com

DATE  
08-05-2011

PROJECT  
11129

SHEET NUMBER

**S3.04**