




**STAIR LANDING FLOOR FRAMING PLAN**  
SCALE: 1/8"=1'-0"  
RFI 83

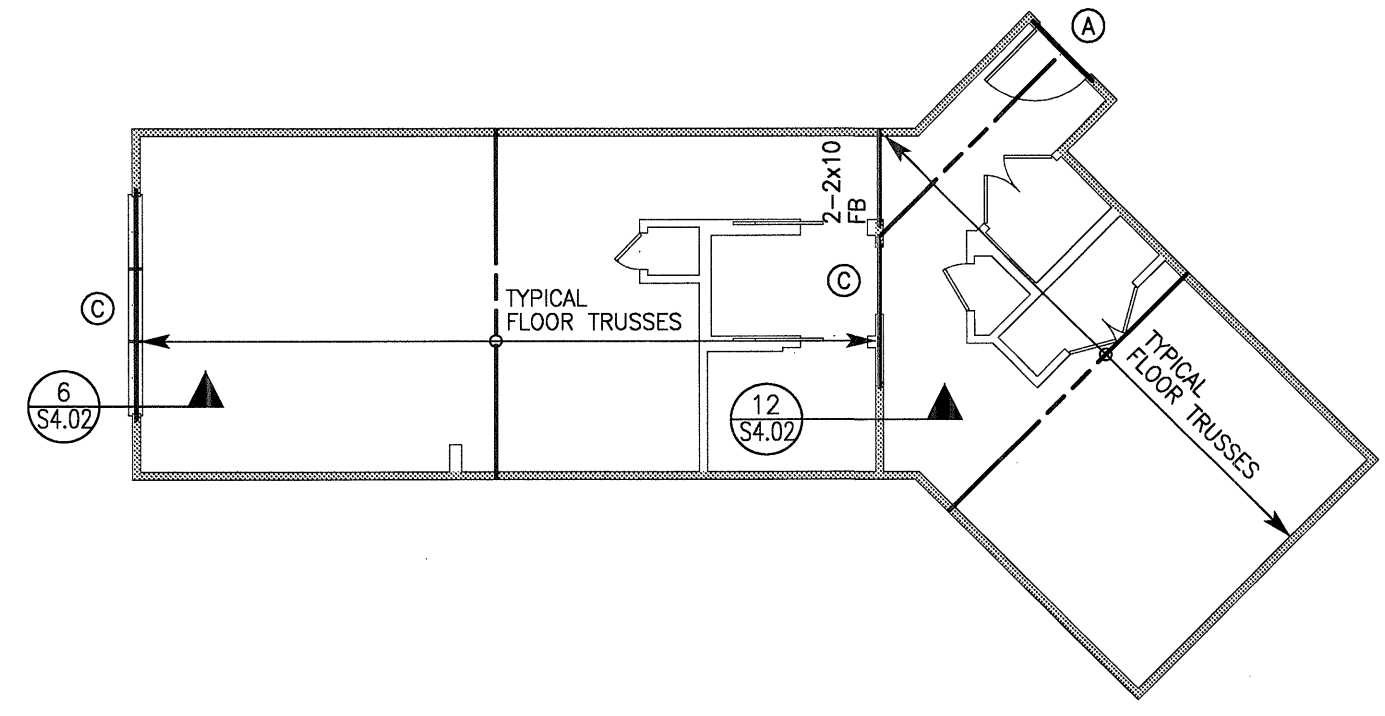


**UNIT E1 FLOOR FRAMING PLAN**  
SCALE: 1/8"=1'-0"

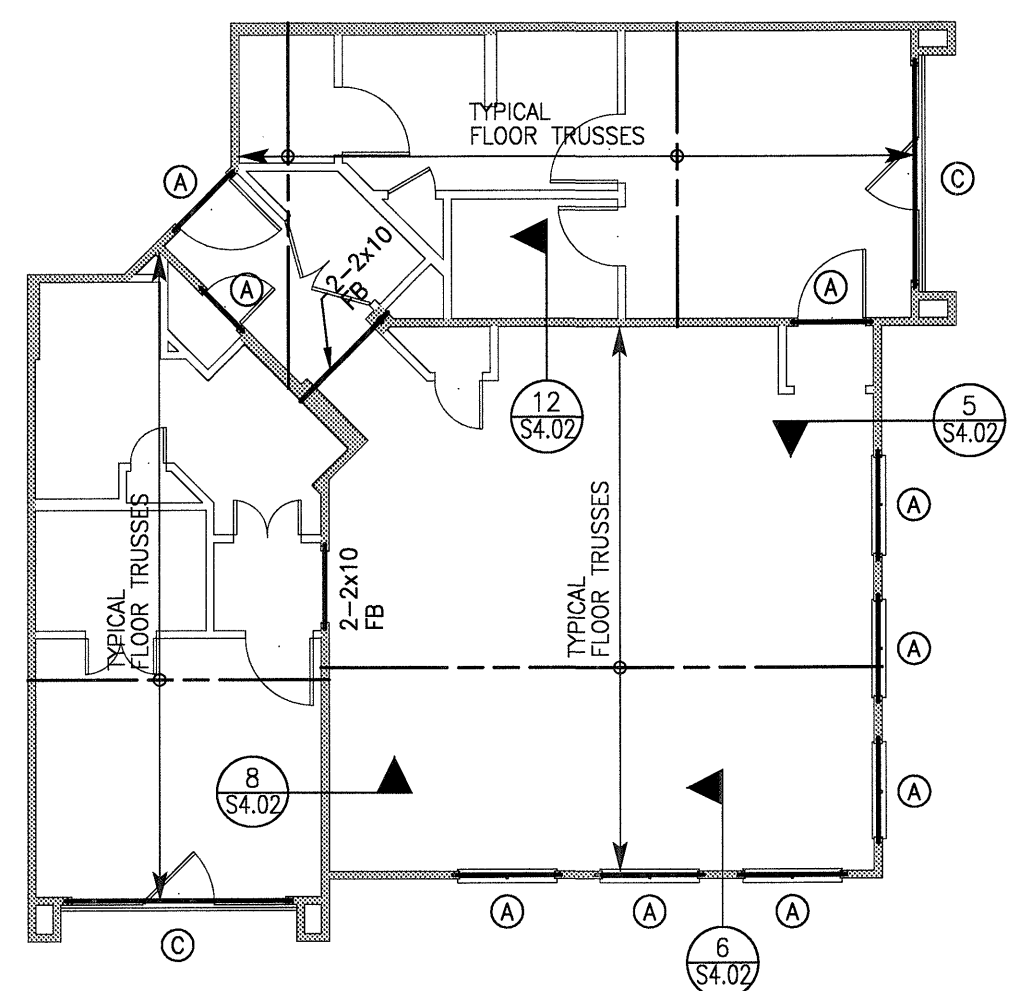


**UNIT B3 ALTERNATE C FLOOR FRAMING PLAN**  
SCALE: 1/8"=1'-0"

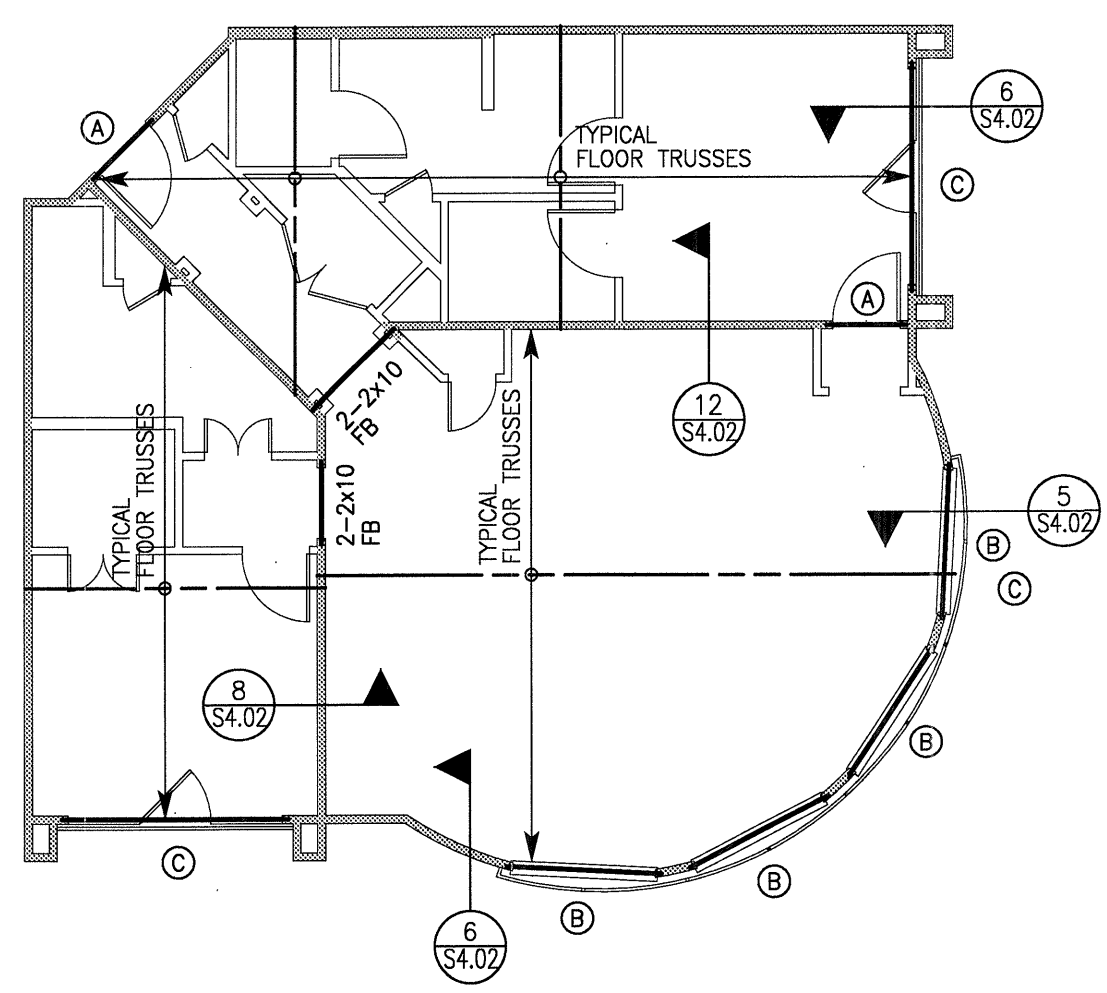

**UNIT B3 ALTERNATE B PARTIAL FLOOR FRAMING PLAN**  
SCALE: 1/8"=1'-0"

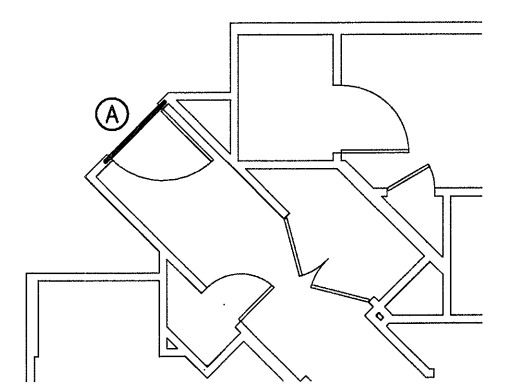

**UNIT B3 ALTERNATE A PARTIAL FLOOR FRAMING PLAN**  
SCALE: 1/8"=1'-0"

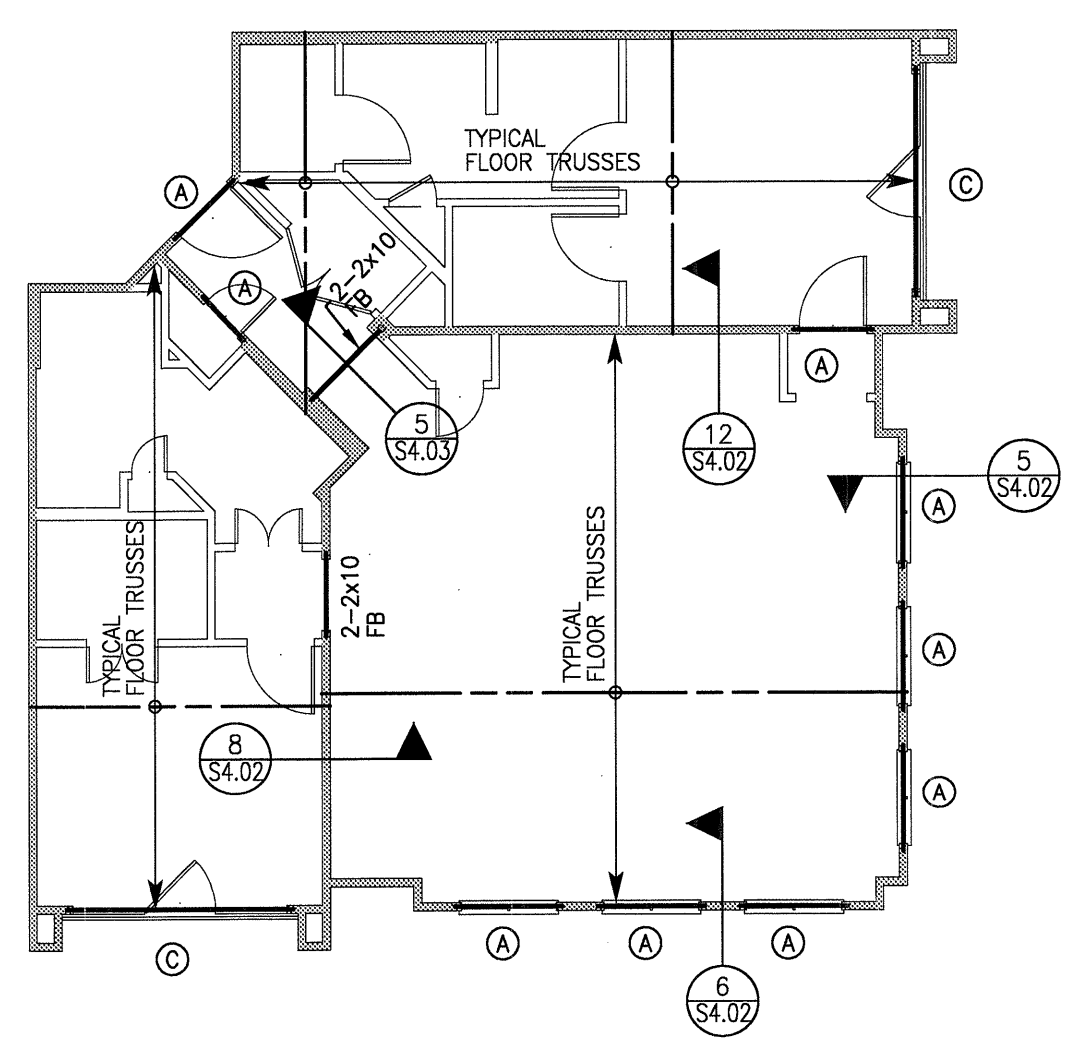

**UNIT B3 FLOOR FRAMING PLAN**  
SCALE: 1/8"=1'-0"

**NOTE:**  
FRAMING PLAN(S) ARE ONLY FOR TRUSS SUPPORT-STRUCTURE AND GENERAL LAYOUT OF FRAMING. TRUSS MANUFACTURER IS RESPONSIBLE FOR ACTUAL TRUSS LAYOUT AND PROFILES AND SHALL SUBMIT SHOP DRAWINGS OF ALL TRUSS LAYOUT AND PROFILES PER THE SPECIFICATIONS.


| HEADER SCHEDULE |                    |                        |                             |
|-----------------|--------------------|------------------------|-----------------------------|
| MARK            | SIZE               | STUD/COLUMN AT LEVEL 1 | STUD/COLUMN AT LEVELS 2,3,4 |
| A               | 2-2x8              | 3-2x STUDS             | 2-2x STUDS                  |
| B               | 2-2x10             | 3-2x STUDS             | 2-2x STUDS                  |
| C               | 2-2x12             | 3-2x STUDS             | 2-2x STUDS                  |
| D               | 3-2x8              | 4-2x STUDS             | 3-2x STUDS                  |
| E               | 3-2x10             | 4-2x STUDS             | 3-2x STUDS                  |
| F               | 3-2x12             | 4-2x STUDS             | 3-2x STUDS                  |
| G               | 3 1/2"x9 1/4" PSL  | 4-2x STUDS             | 3-2x STUDS                  |
| H               | 3 1/2"x11 1/4" PSL | 5-2x STUDS             | 4-2x STUDS                  |
| J               | 3 1/2"x14" PSL     | 5-2x STUDS             | 4-2x STUDS                  |
| K               | 3 1/2"x16" PSL     | 6-2x STUDS             | 5-2x STUDS                  |

**NOTES:**  
1. INDICATES NUMBER OF FULL HEIGHT STUDS REQUIRED AT EACH END OF HEADER.  
2. REF. TYPICAL WALL OPENING ELEVATIONS FOR NUMBER OF REQUIRED TRIM STUDS.

**7 SCHEDULE**  
NO SCALE

**PLAN NOTES:**

- REFER TO SHEETS S1.01 THRU S1.03 FOR STRUCTURAL NOTES AND SCHEDULES.
- REFER TO SHEETS S4.01 THRU S4.04 FOR TYPICAL FRAMING DETAILS.
- 1/SHEATHING = TOP OF FLOOR SHEATHING ELEVATION. REFER TO ARCHITECTURAL DRAWINGS FOR 1/SHEATHING ELEVATIONS. ALL LEVELS TO BE CONSTRUCTED WITH 9'-1" PLATE HEIGHTS, UNLESS NOTED OTHERWISE.
- COORDINATE FLOOR DEPRESSIONS, DROPS AND DIMENSIONS WITH ARCHITECTURAL DRAWINGS.
- ALL HORIZONTAL FRAMING LUMBER SHALL BE KILN-DRIED #2 SOUTHERN PINE, UNLESS NOTED OTHERWISE. ALL OTHER LUMBER SPECIES AND GRADES MUST BE APPROVED IN WRITING BY THE ENGINEER.
- TYPICAL FLOOR TRUSSES SHALL BE 18" DEEP AT 24" O.C., UNLESS NOTED OTHERWISE. PROVIDE TRUSS BRIDGING IN ACCORDANCE WITH THE MANUFACTURER'S RECOMMENDATIONS.
- BALCONY TRUSSES SHALL BE 15" DEEP AT 24" O.C., UNLESS NOTED OTHERWISE. PROVIDE TRUSS BRIDGING IN ACCORDANCE WITH THE MANUFACTURER'S RECOMMENDATIONS.
- SLOPED BALCONY TRUSSES SHALL BE AT 24" O.C. WITH A MINIMUM DEPTH OF 15" AT THE EXTERIOR AND SHALL HAVE A SLOPED TOP CHORD, UNLESS NOTED OTHERWISE. REFER TO SECTIONS AND DETAILS FOR ADDITIONAL INFORMATION. PROVIDE TRUSS BRIDGING IN ACCORDANCE WITH THE MANUFACTURER'S RECOMMENDATIONS.
- ALL WOOD BEAMS ARE LOAD BEARING HEADERS, UNLESS NOTED OTHERWISE. (DB = DROP BEAM, FB = FLASH BEAM). REFER TO SCHEDULES FOR SUPPORT REQUIREMENTS AT HEADERS AND BEAMS.
- ALL WALLS SHOWN ARE BELOW THIS LEVEL, UNLESS NOTED OTHERWISE.
- INDICATES ASSUMED INTERIOR LOAD BEARING WALLS BELOW THIS LEVEL. ALL EXTERIOR WALLS SHALL BE LOAD BEARING.
- INDICATES ASSUMED INTERIOR LOAD BEARING WALLS ABOVE THIS LEVEL.
- INDICATES LIGHT WEIGHT CONCRETE TOPPING AT BALCONIES AND CORRIDORS. CONCRETE TOPPING SHALL BE REINFORCED WITH NYLON OR GLASS FIBER REINFORCEMENT (OR APPROVED SUBSTITUTE) IN ACCORDANCE WITH THE MANUFACTURER'S RECOMMENDATIONS.
- POST/STUD COLUMNS SHALL BE CONTINUOUS TO FOUNDATION. CONNECT WOOD BEAMS AND COLUMNS WITH SIMPSON TYPE "ACE" POST CAPS OR APPROVED SUBSTITUTE.

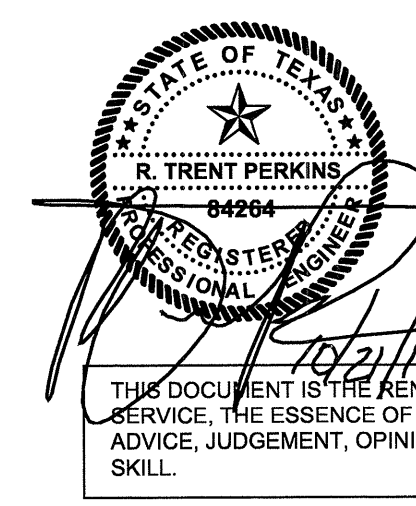

THE SEAL APPEARING ON THIS DOCUMENT WAS AUTHORIZED BY R. TRENT PERKINS, P.E. 84284

**PPO**  
PARKIN - PERKINS - OLSEN  
CONSULTING ENGINEERING, INC.  
9330 LBJ Freeway Suite 1055  
Dallas, Texas 75243  
Tel 214.221.2220 Fax 214.221.2252  
Project No. 39155  
Registration No. F-1479

REVISIONS

|  |  |
|--|--|
|  |  |
|  |  |
**KELLER SPRINGS LOFTS**  
LOFT APARTMENTS IN ADDISON, TEXAS

CONSTRUCTION ISSUE  
10-17-2011

**BGO** architects  
4144 N. Central Expy., Suite 855  
Dallas, TX 75204  
214.520.8878  
bgoarchitects.com

DATE  
08-05-2011

PROJECT  
11129

SHEET NUMBER

**S2.07**