

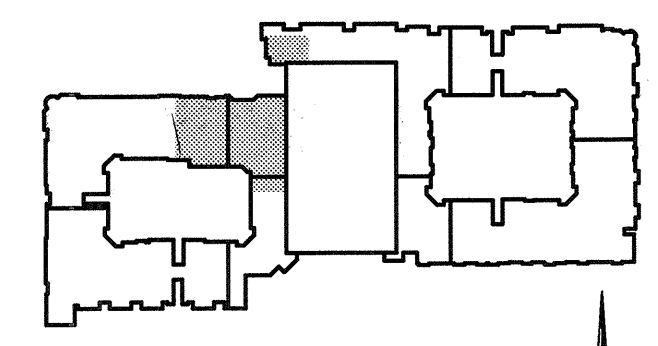


1  
S2.11S  
PARTIAL  
STEEL COLUMN PLAN  
SCALE: 1/8"=1'-0"

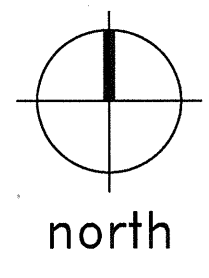

KEY PLAN

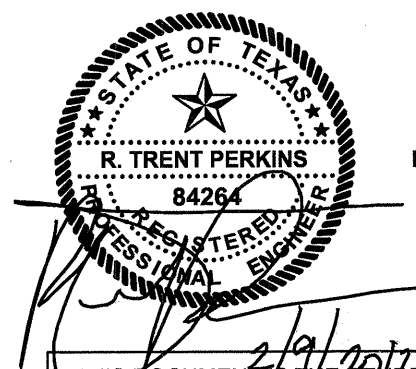

THE SEAL APPEARING  
ON THIS DOCUMENT  
WAS AUTHORIZED BY  
R. TRENT PERKINS, P.E. 84264

THIS DOCUMENT IS THE RENDERING OF A PROFESSIONAL  
SERVICE, THE ESSENCE OF WHICH IS THE PROVIDING OF  
ADVICE, JUDGEMENT, OPINION, OR SIMILAR PROFESSIONAL  
SKILL.



PARKIN - PERKINS - OLSEN  
CONSULTING ENGINEERING, INC.  
9330 LBJ Freeway Suite 1055  
Dallas, Texas 75243  
Tel 214.221.2220 Fax 214.221.2252  
Project No. 39155 Registration No. F-1479

REVISIONS	
△ SLAB ON VOID FOUNDATION	11/18/2011
△ COORDINATION	02/09/2012

**KELLER SPRINGS LOFTS**  
LOFT APARTMENTS IN ADDISON, TEXAS

CONSTRUCTION ISSUE  
10-17-2011

**BGO**  
architects  
4144 N. Central Expy.,  
Suite 855  
Dallas, TX 75204  
214.520.8878  
bgoarchitects.com

DATE  
08-05-2011

PROJECT  
11129

SHEET NUMBER  
△  
**S2.11S**