EMBREY BUILDERS, LLC. 1020 N. E. Loop 410, Suite 700 San Antonio, TX 78209 Ph: (210) 824-6044 Fax: (210) 824-7656

RFI

To: Trent Perkins Parkin Perkins Olsen 9330 LBJ Freeway, Suite 1055 Dallas, TX 75243 Ph: (214)221-2220 Fax: (214)221-2252

Date: 5/17/2012 Job: EB-02 Keller Springs Lofts Phone: 877-777-5115

cc: Erik Earnshaw (Beeler Guest Owens Architects)

Subject: Reinforcement Between Garage and Elevator #2

Drawing: S2.14 Cost Impact: None

Spec Section: Schedule Impact: None

Date Required: 5/18/2012 Request: There isn't a cut through the area between the garage and elevator pit #2. There will be an 8" wide slab between the garage and the elevator pit wall that supports the elevator shaft wall. Does that area need some other type of support than just a couple of #4 bars?

Requested by: David Miller Embrey Builders LLC

*Refer to PPO Response to RFI 122 on May 25, 2012. *If you have questions or require additional information regarding this matter, please do not hesitate to contact us.

05/25/2012 Parkin-Perkins-Olsen

Page 1 of 1

EMBREY BUILDERS, LLC. 1020 N. E. Loop 410, Suite 700 San Antonio, TX 78209 Ph: (210) 824-6044 Fax: (210) 824-7656

Brande Parkey

RFI

RFI #: 122 To: Trent Perkins Date: 5/21/2012 Parkin Perkins Olsen Job: EB-02 Keller Springs Lofts 9330 LBJ Freeway, Suite 1055 Dallas, TX 75243 Phone: 877-777-5115 Ph: (214)221-2220 Fax: (214)221-2252

Subject: Elevator Pit #2 Dowels

Drawing: S2.14 & 11/S3.03 Spec Section: Schedule Impact: None Cost Impact: None

Embrey Builders LLC

Date Required: 5/24/2012 Request: Please provide a detail sketch showing the proper number and placement of dowels to tie the elevator back wall into the beam wall of the garage. S2.14 shows using 11/S3.03 at the NW & SW corner of the pit adjacent to the garage. Please provide a sketch for clarification purposes on the elevator wall butting into the garage. Requested by: David Miller

**While on site on Thursday, May 24, it was observed that the concrete subcontractor had drilled and epoxy grouted #4 dowels at approximately 18" o.c. horizontally and vertically in the garage foundation wall to tie into the elevator pit wall. He was preparing to install 2-#4 dowels at 12" o.c. vertical in the garage foundation wall to tie into the intersecting elevator pit walls. Refer to the attached photo. The proposed solution is acceptable to PPO. **It was also discussed while on site that the 8" wide elevator pit wall adjacent to the garage foundation wall shall be reinforced with #4 bars at 12" on center, each way, and centered in the **If you have questions or require additional information regarding this matter, please do not hesitate to contact us.

Brande Parkey Answered by 05/25/2012 Parkin-Perkins-Olsen

Company

Embrey Builders, LLC

Ph : (210) 824-6044 Fax: (210) 824-7656

Parkin Perkins Olsen

Dallas, TX 75243

Subject: Pour 21 Construction Joint

9330 LBJ Freeway, Suite 1055

Ph: (214)221-2220 Fax: (214)221-2252

cc: Erik Earnshaw (Beeler Guest Owens Architects)

Embrey Builders LLC

the drawing. Please confirm that we are OK to proceed with this.

1020 N. E. Loop 410, Suite 700 San Antonio, TX 78209

To: Trent Perkins

Drawing: S2.14

Cost Impact: None

Requested by: David Miller

The proposed construction joint is acceptable to PPO. Please use the attached detail at the construction joint. Please verify with the Architect that a construction joint is acceptable in this location. May 31, 2012 R. Trent Perkins, P.E. Parkin-Perkins-Olsen Consulting Engineering, Inc.

RFI

Spec Section:

We would like to place a construction joint per the attached drawing. This joint will go along the south end of the ramp as shown on

Schedule Impact: None

RFI #: 130

Date: 5/29/2012

Phone: 877-777-5115

Job: EB-02 Keller Springs Lofts

Ryan Faulds BGO architecture June 01, 2012 Answered by Date

Page 1 of 1

Date Required: 6/6/2012

This is an acceptable location.

RFI 130 3/4"x3 1/2" CONTINUOUS REINFORCING -SHEAR KEY REF. PLAN #5 x 4'-0" AT 12" O.C. STRUCTURAL -SLAB ON VOIDS T/CONC. EL. -

STRUCTURAL SLAB **CONSTRUCTION JOINT DETAIL**

PARKIN - PERKINS - OLSEN | Project: Keller Springs Lofts CONSULTING ENGINEERING, INC. Addison, Texas 9330 LBJ Freeway Dallas, Texas

Project No.: 39155.1 | Date: 05/30/2012 | Drawing No.:

Embrey Builders, LLC

1020 N. E. Loop 410, Suite 700 San Antonio, TX 78209 Ph: (210) 824-6044 Fax: (210) 824-7656

RFI

To: Trent Perkins Parkin Perkins Olsen 9330 LBJ Freeway, Suite 1055 Dallas, TX 75243 Ph: (214)221-2220 Fax: (214)221-2252

RFI #: 159 Date: 6/20/2012 Job: EB-02 Keller Springs Lofts Phone: 877-777-5115

CC:

Subject: Rebar Specs on Pour 21 Slab

Drawing: S2.14 Cost Impact: None

Spec Section: Schedule Impact: None

Date Required: 6/22/2012 S2.14 calls for #5 bars at 12" O.C. each way top and bottom on the Pour 21 slab. We plan to chair the lower mat at 3.5" from the bottom and about 7.5" for the top mat. Please confirm that this is acceptable.

Requested by: David Miller Embrey Builders LLC

Provide chairs to provide 1 1/2" of clear cover between the outer layer of reinforcement and the edge of concrete as noted in Structural Concrete Note #4 on sheet S1.01.

R. Trent Perkins, PE Parkin-Perkins-Olsen Consulting Engineering, Inc.

Answered by

Company

Embrey Builders, LLC 1020 N. E. Loop 410, Suite 700 San Antonio, TX 78209 Ph: (210) 824-6044 Fax: (210) 824-7656

RFI

To: Trent Perkins Parkin Perkins Olsen 9330 LBJ Freeway, Suite 1055 Dallas, TX 75243 Ph: (214)221-2220 Fax: (214)221-2252

RFI #: 220 Date: 3/4/2013 Job: EB-02 Keller Springs Lofts Phone: 877-777-5115

CC: Walter Kilroy (BGO)

Subject: East Elevator Extension

Drawing: S2.1, 3.1D Cost Impact: None

Spec Section: Schedule impact: None

Date Required: 3/7/2013 S2.1 shows the north horizontal line of the new grade beam at the north side of the mechanical shaft as being 26'- 6 1/4" off exterior wall. Sheet 3.1D shows the dimension from the exterior wall to ramp is 26'- 3". Does this mean we have to cut into the ramp about 3" for the beam placement?

Requested by: Bryan Pickler Embrey Partners, Ltd.

June 20, 2012

Page 1 of 1

No. Align new grade beam with edge of ramp.

Answered by: Trent Perkins

Parkin Perkins Olsen

Answered date: March 05, 2013

Page 1 of 1

Embrey Builders, LLC 1020 N. E. Loop 410, Suite 700 San Antonio, TX 78209 Ph: (210) 824-6044 Fax: (210) 824-7656

RFI

To: Trent Perkins Parkin Perkins Olsen 9330 LBJ Freeway, Suite 1055 Dallas, TX 75243 Ph: (214)221-2220 Fax: (214)221-2252

Date: 6/27/2012 Job: EB-02 Keller Springs Lofts Phone: 877-777-5115

Subject: Blockout Details Needed for Pour #13

Drawing: PT3.14, S2.14 Cost Impact: None

Schedule Impact: None


Spec Section:

Date Required: 7/5/2012 Because Pour 11 has already taken place, we need a block-out detail to be able to do Pour #13. Please see the attached drawing that indicates the location of the cables involved and provide a detail showing the information needed. Requested by: David Miller

Embrey Builders LLC

Please obtain the requested blockout detailing from Ready Cable.

R. Trent Perkins, P.E. Parkin-Perkins-Olsen Consulting Engineering, Inc.

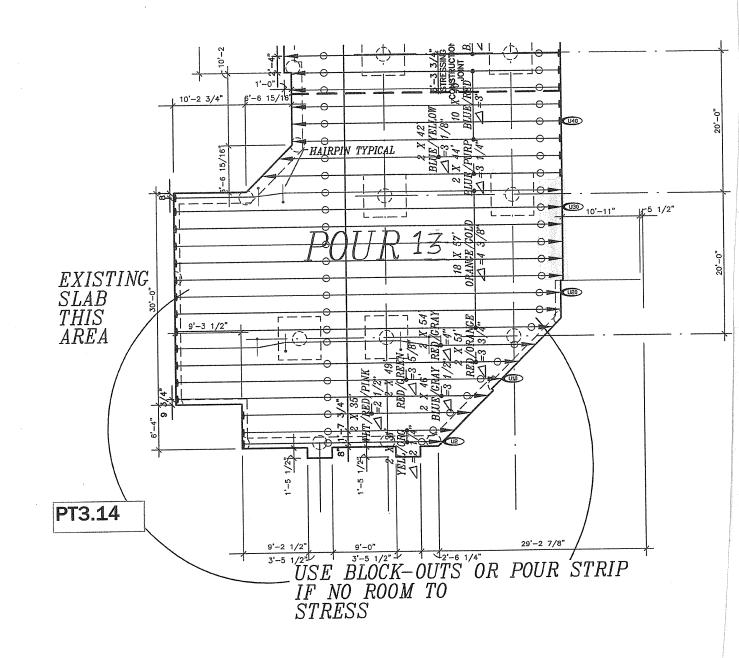

June 28, 2012

Page 1 of 1

Page 1 of 1