

AND SHALL HAVE A SLOPED TOP CHORD, UNLESS NOTED OTHERWISE. REFER TO

11. SLOPED BALCONY TRUSSES SHALL BE AT 24" O.C. WITH A MINIMUM DEPTH OF 15" AT THE

REFER TO SECTIONS AND DETAILS FOR ADDITIONAL INFORMATION. PROVIDE TRUSS BRIDGING

13. EXTERIOR WALL SHEATHING SHALL BE 15/32" APA RATED SHEATHING, UNLESS NOTED OTHERWISE.

16. INDICATES CONCRETE TOPPING ON WOOD SHEATHING. REFERENCE STRUCTURAL NOTES

17. POST/STUD COLUMNS SHALL BE CONTINUOUS TO FOUNDATION. CONNECT WOOD BEAMS AND COLUMNS WITH SIMPSON TYPE "ACE" POST CAPS OR APPROVED SUBSTITUTE.

19. TRUSS MANUFACTURER TO COORDINATE MECHANICAL, ELECTRICAL AND PLUMBING PENETRATIONS

SECTIONS AND DETAILS FOR ADDITIONAL INFORMATION. PROVIDE TRUSS BRIDGING

EXTERIOR AND SHALL HAVE A SLOPED TOP CHORD, UNLESS NOTED OTHERWISE.

(DB = DROP BEAM, FB = FLUSH BEAM). REFER TO SCHEDULES FOR SUPPORT

IN ACCORDANCE WITH THE MANUFACTURER'S RECOMMENDATIONS.

IN ACCORDANCE WITH THE MANUFACTURER'S RECOMMENDATIONS.

REQUIREMENTS AT HEADERS AND BEAMS.

FOR ADDITIONAL INFORMATION.

DRAWINGS REF. 9/S4.04.

ALL EXTERIOR WALLS SHALL BE LOAD BEARING.

12. ALL WOOD BEAMS ARE LOAD BEARING HEADERS, UNLESS NOTED OTHERWISE.

14. INDICATES ASSUMED INTERIOR LOAD BEARING WALLS BELOW THIS LEVEL.

15. ********** INDICATES ASSUMED INTERIOR LOAD BEARING WALLS ABOVE THIS LEVEL.

18. COORDINATE FLOOR OPENINGS WITH ARCHITECTURAL, MECHANICAL AND ELECTRICAL

20. ALL UNIT DESIGNATIONS SHOWN ARE BELOW THIS LEVEL, UNLESS NOTED OTHERWISE.

THRU TRUSSES AND TRUSS GIRDERS WITH MEP DRAWINGS.

SHEARWALL NOTES

- 1. ALL SHEARWALLS INDICATED ON PLAN ARE LOCATED AT FLOOR BELOW.
- 2. ALL SHEARWALLS ARE INDICATED ON PLAN TYPICAL, UNLESS NOTED OTHERWISE. REFERENCE SHEARWALL SCHEDULE 5/S1.03.
- 3. REFERENCE 3/S4.02 AND 4/S4.02 FOR TYPICAL SHEARWALL ELEVATIONS.


____ ---

= SHEARWALL REFERENCE SHEARWALL NOTES THIS SHEET, AND SHEARWALL SCHEDULE 5/S1.03.

HEADER SCHEDULE			
MARK	SIZE	STUD/COLUMN AT LEVEL 1	STUD/COLUMN AT LEVELS 2,3,4
A	2-2x8	3-2x STUDS	2-2x STUDS
B	2-2x10	3-2x STUDS	2-2x STUDS
. ©	2-2x12	3-2x STUDS	2-2x STUDS
(D)	3-2x8	4-2x STUDS	3-2x STUDS
Ē	3-2x10	4-2x STUDS	3-2x STUDS
F	3-2x12	4-2x STUDS	3-2x STUDS
©	3 1/2"x9 1/4" PSL	4-2x STUDS	3-2x STUDS
\oplus	3 1/2"x11 1/4" PSL	5-2x STUDS	4-2x STUDS
<u> </u>	3 1/2"x14" PSL	5-2x STUDS	4-2x STUDS
ĸ	3 1/2"x16" PSL	6-2x STUDS	5-2x STUDS

- NOTES:
- 1. INDICATES NUMBER OF FULL HEIGHT STUDS REQUIRED AT EACH END OF HEADER.
- 2. REF. TYPICAL WALL OPENING ELEVATIONS FOR NUMBER OF REQUIRED TRIM STUDS.

SCHEDULE NO SCALE

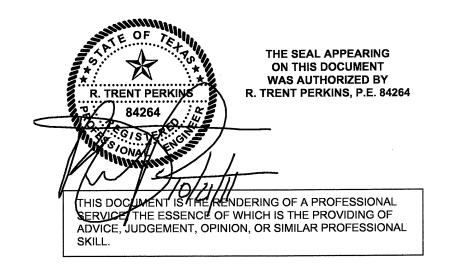



Project No.

Registration No.

PARKIN - PERKINS - OLSEN CONSULTING ENGINEERING, INC Suite 1055 Dallas, Texas *75243* Tel 214.221.2220 Fax 214.221.2252

39155

F-1479

REVISIONS COORDINATION 10-17-2011

 α



4144 N. Central Expy., Suite 855 Dallas, TX 75204 214.520.8878

bgoarchitects.com

DATE

08-05-2011

PROJECT

SHEET NUMBER