



1 TYPICAL POST-TENSION DETAILS  
NO SCALE

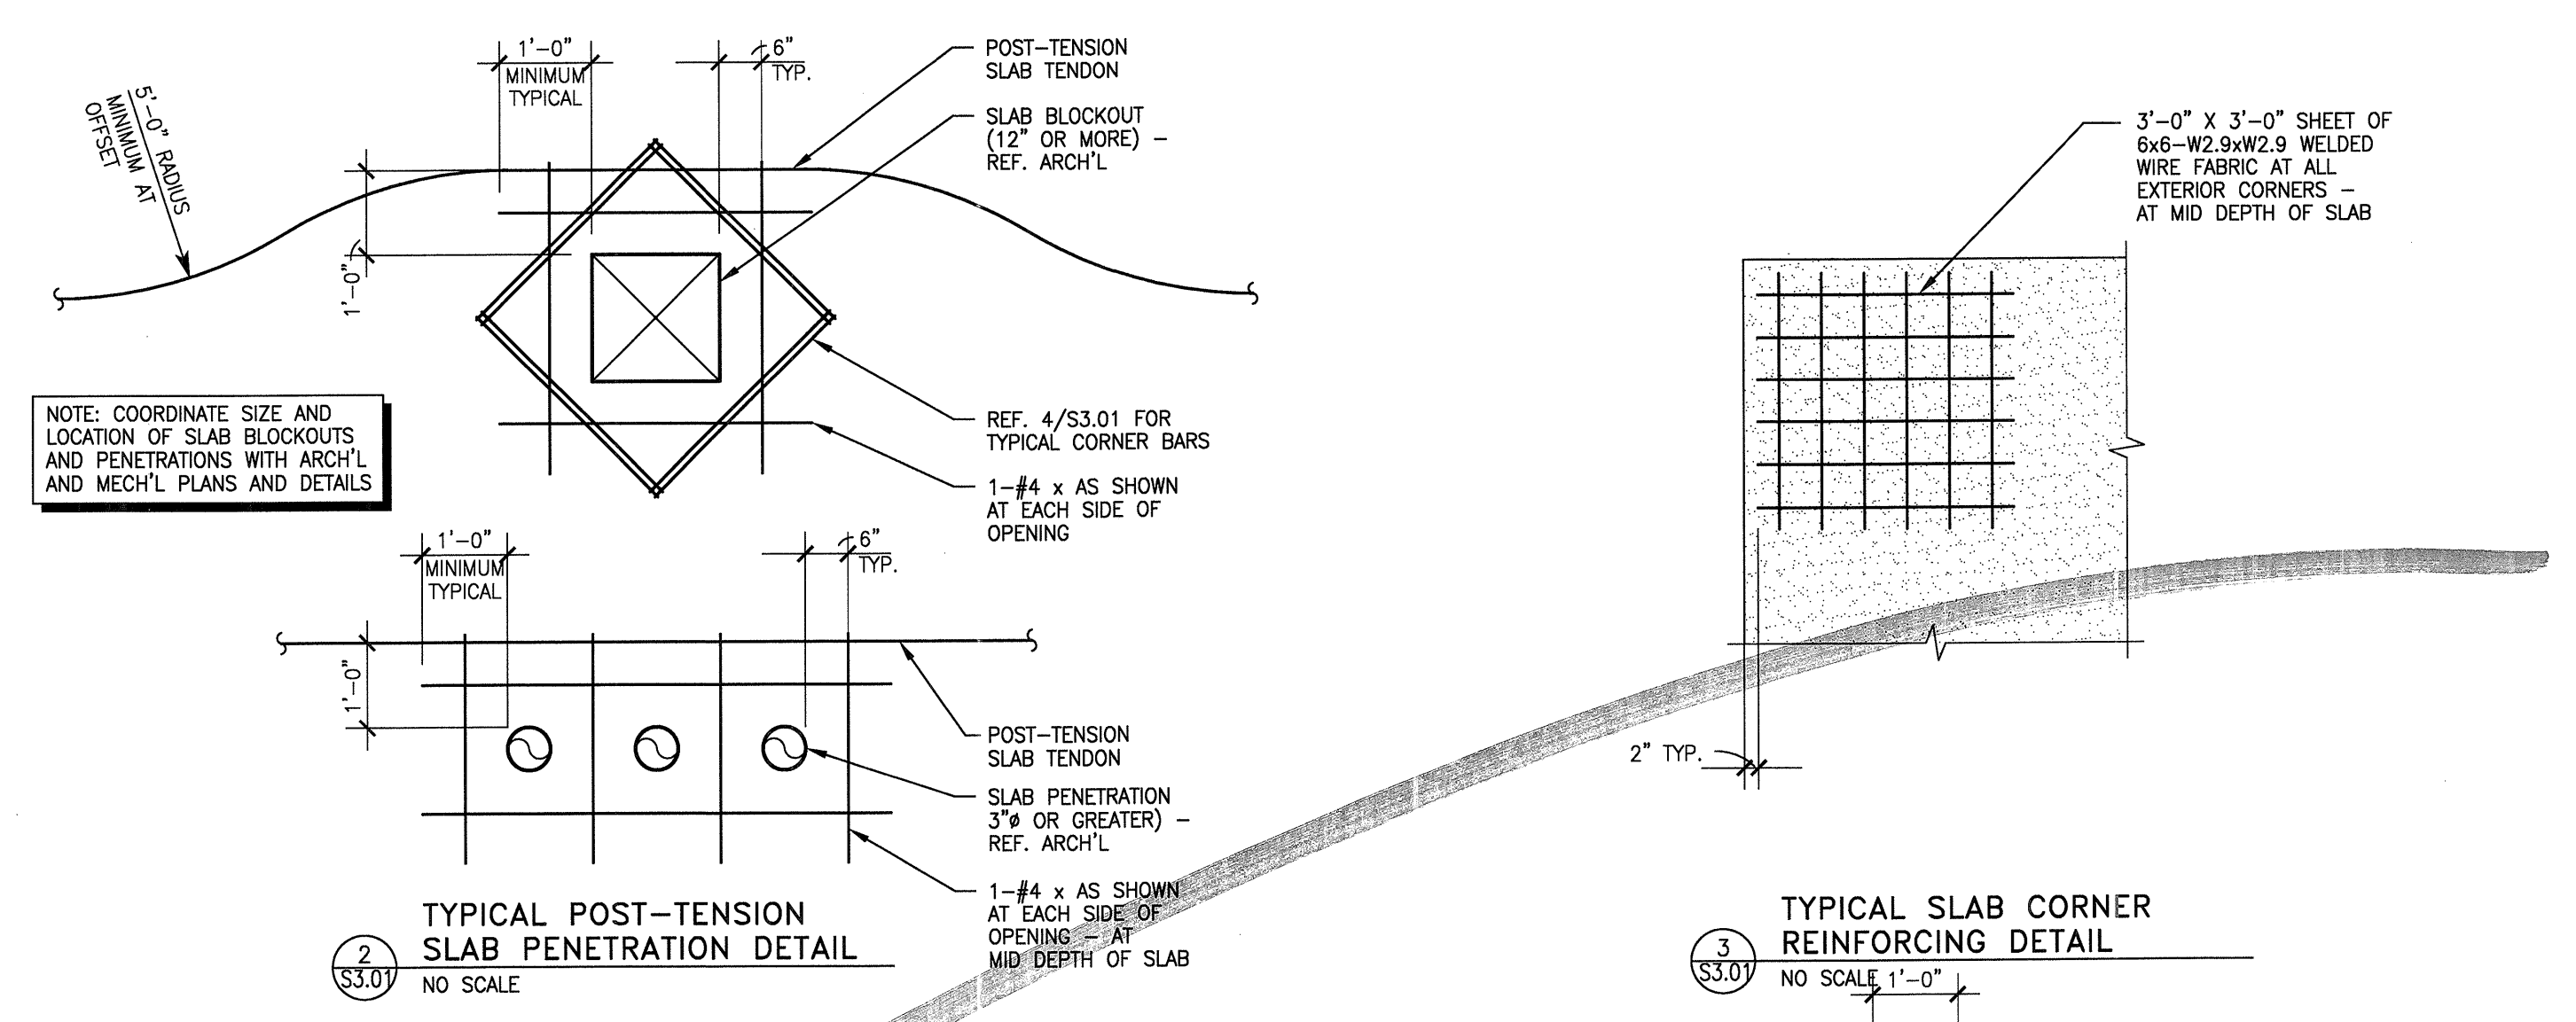


2 TYPICAL POST-TENSION  
SLAB PENETRATION DETAIL  
NO SCALE


3 TYPICAL SLAB CORNER  
REINFORCING DETAIL  
NO SCALE 1'-0"

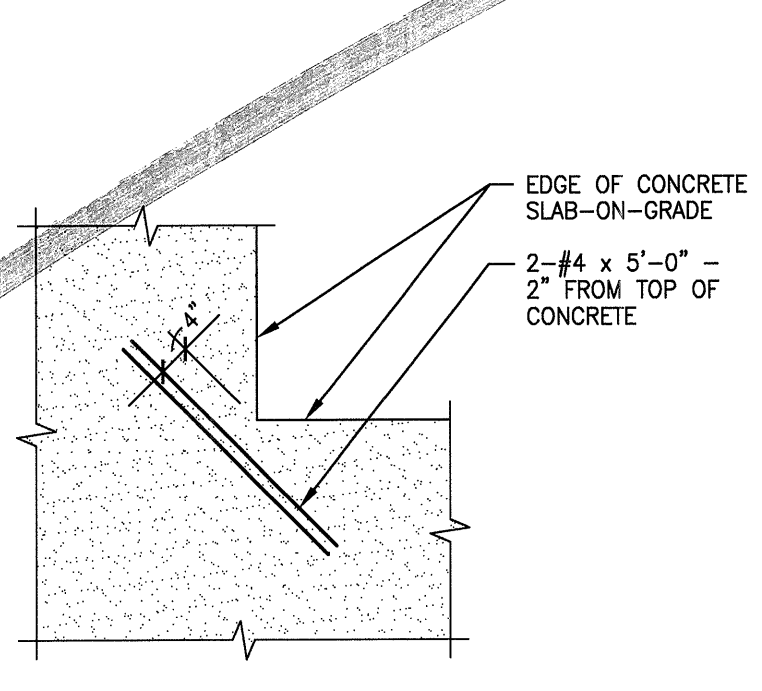


4 TYPICAL RE-ENTRANT SLAB  
CORNER REINFORCING DETAIL  
NO SCALE

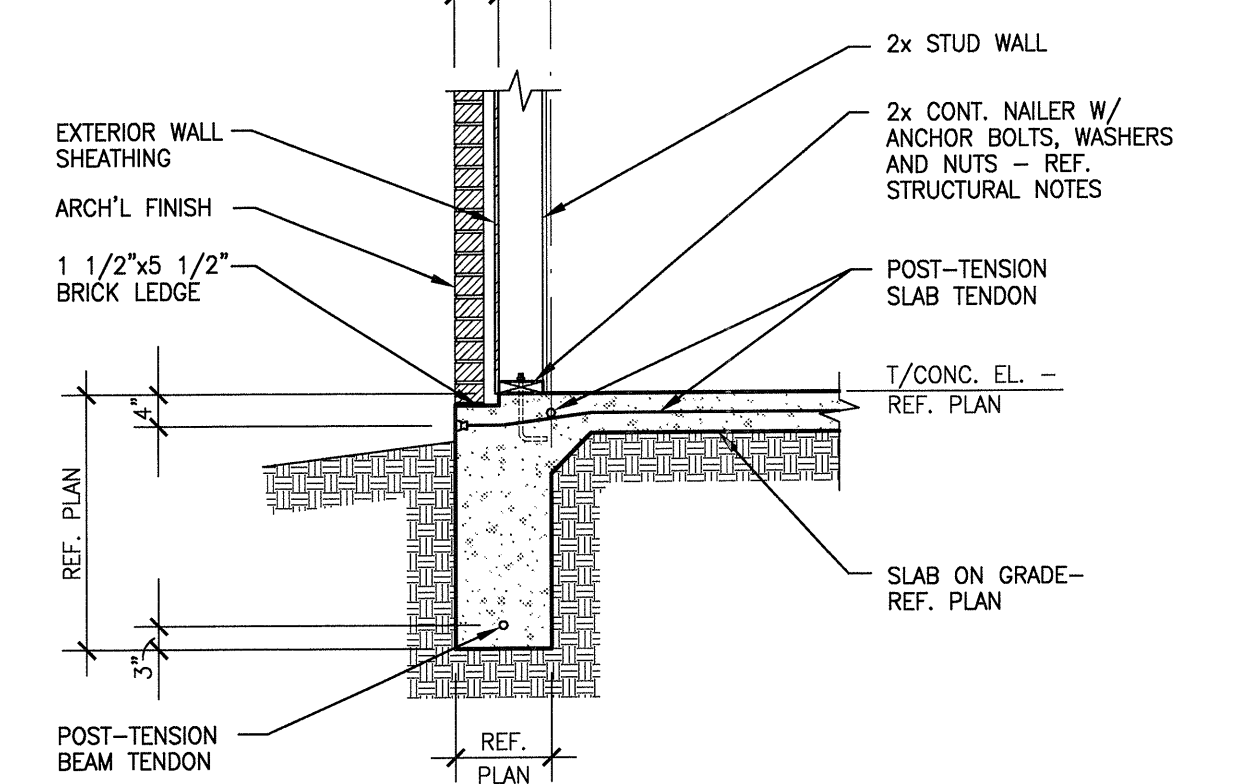


5 SECTION  
SCALE: 1/2"=1'-0"

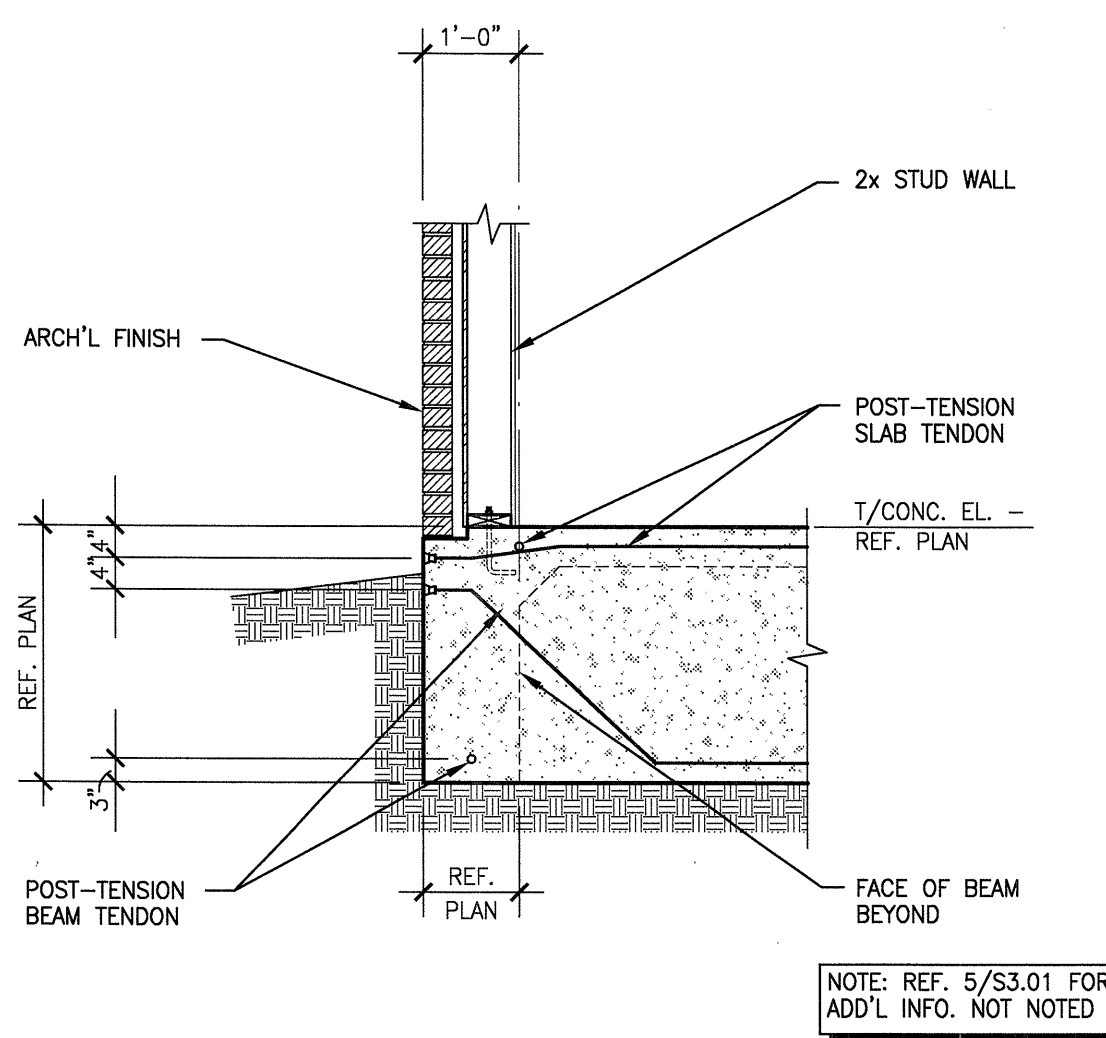


6 SECTION  
SCALE: 1/2"=1'-0"

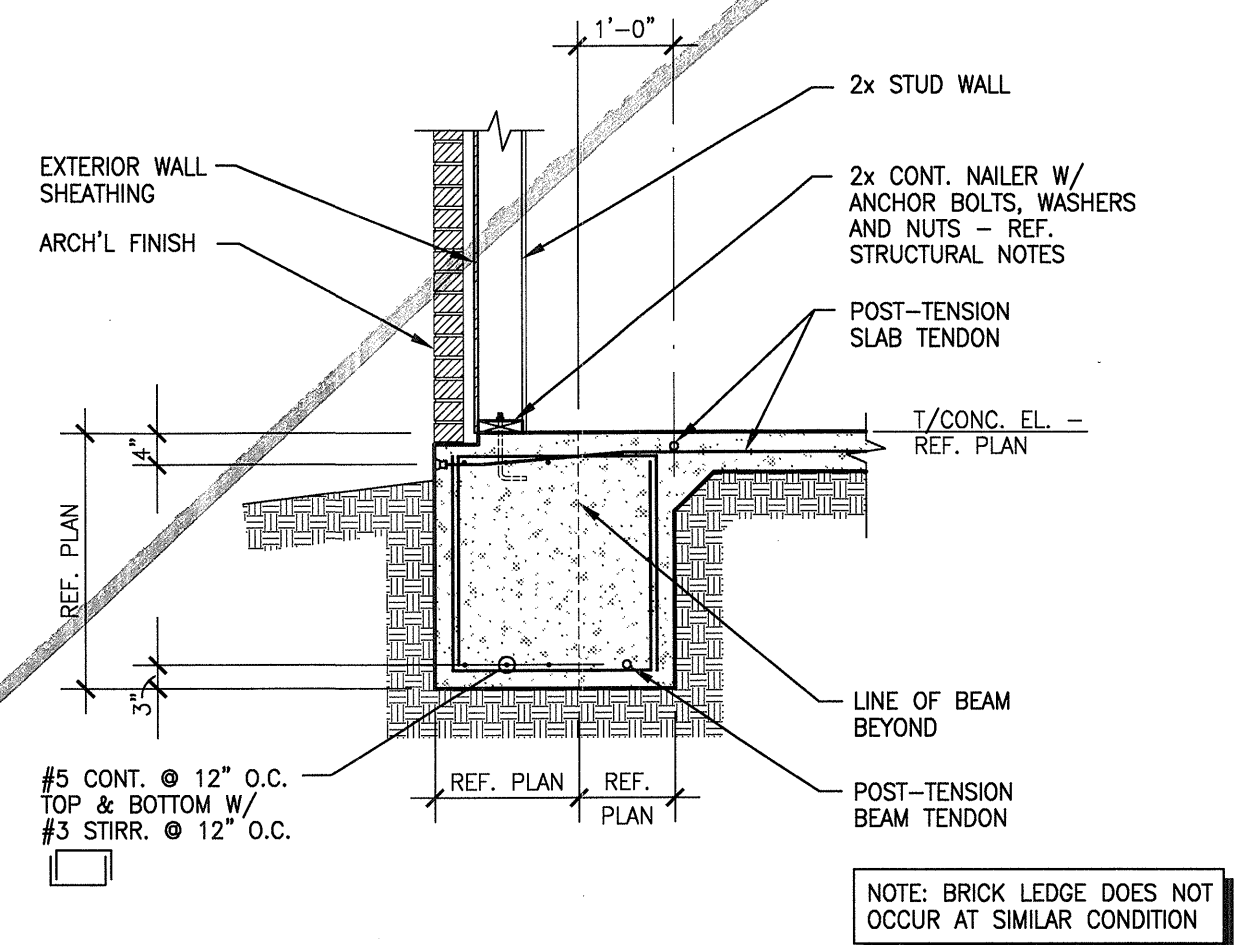


7 SECTION  
SCALE: 1/2"=1'-0"

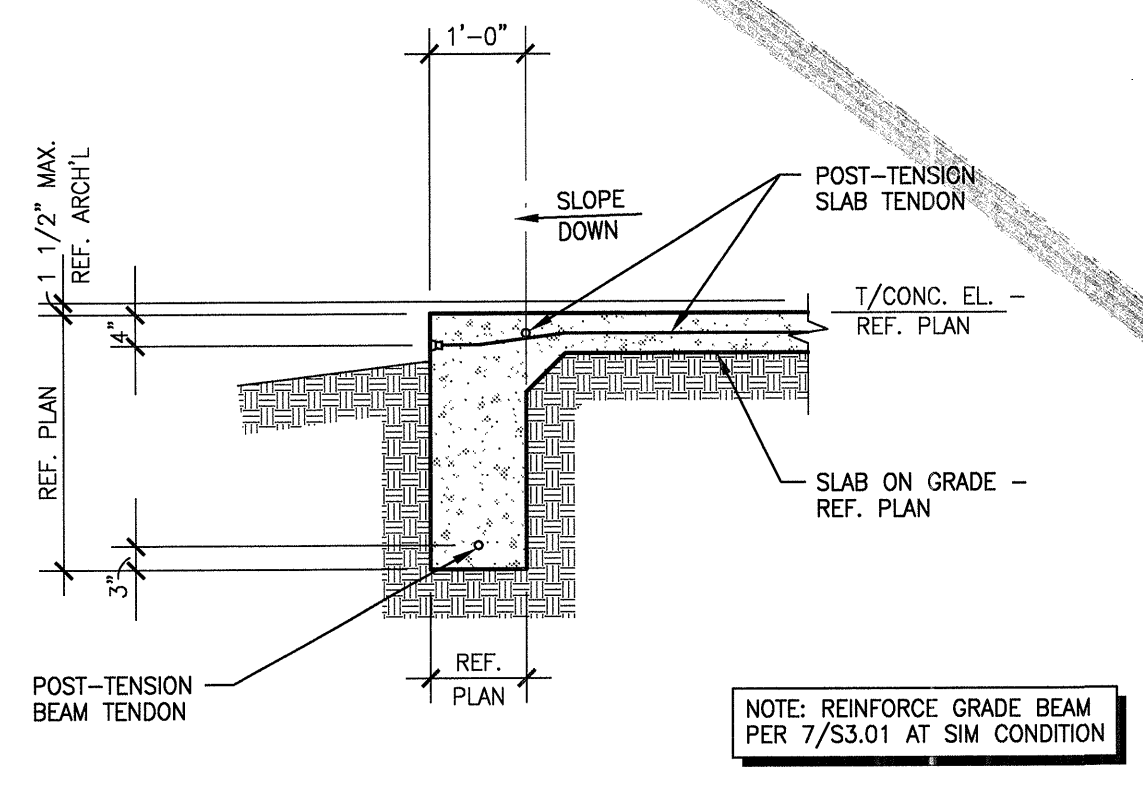


8 SECTION  
SCALE: 1/2"=1'-0"

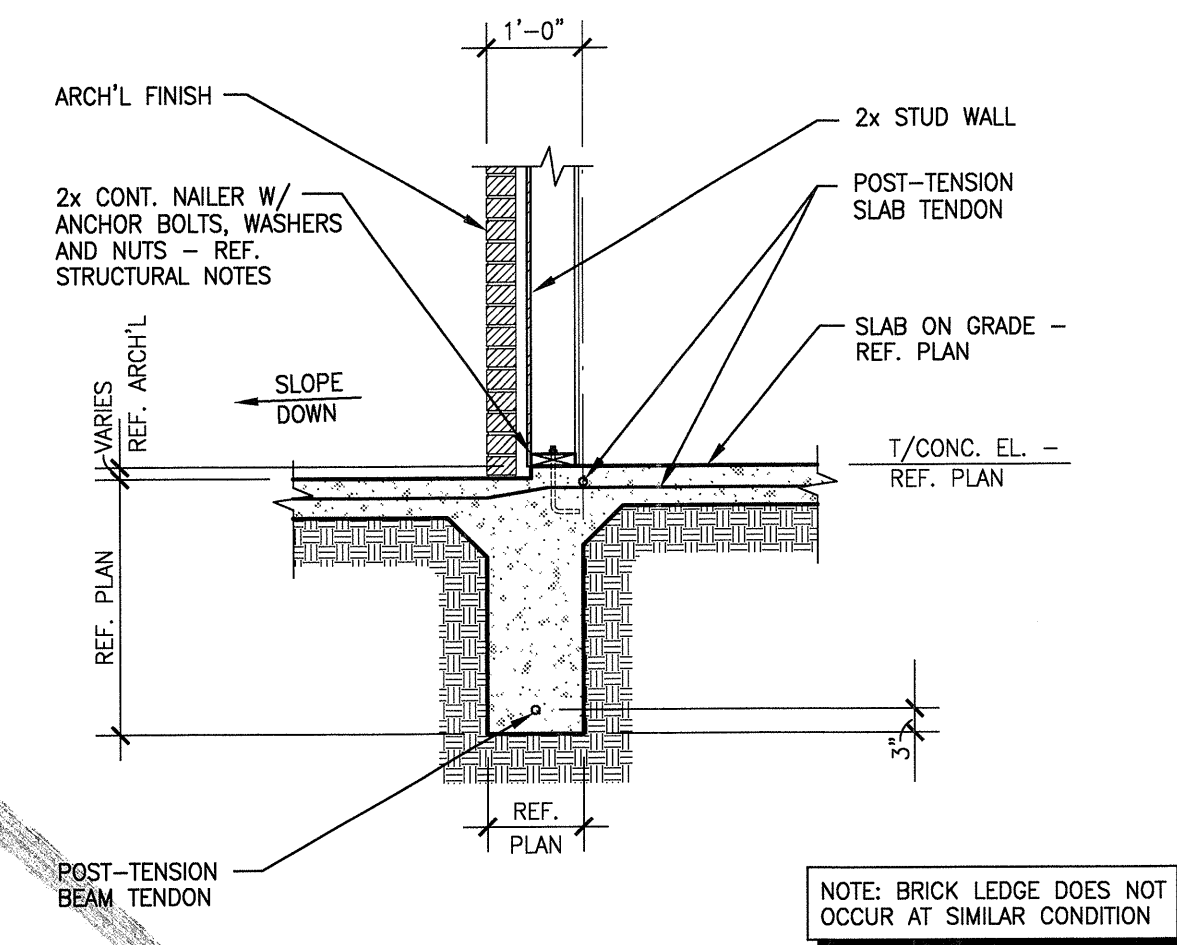


9 SECTION  
SCALE: 1/2"=1'-0"

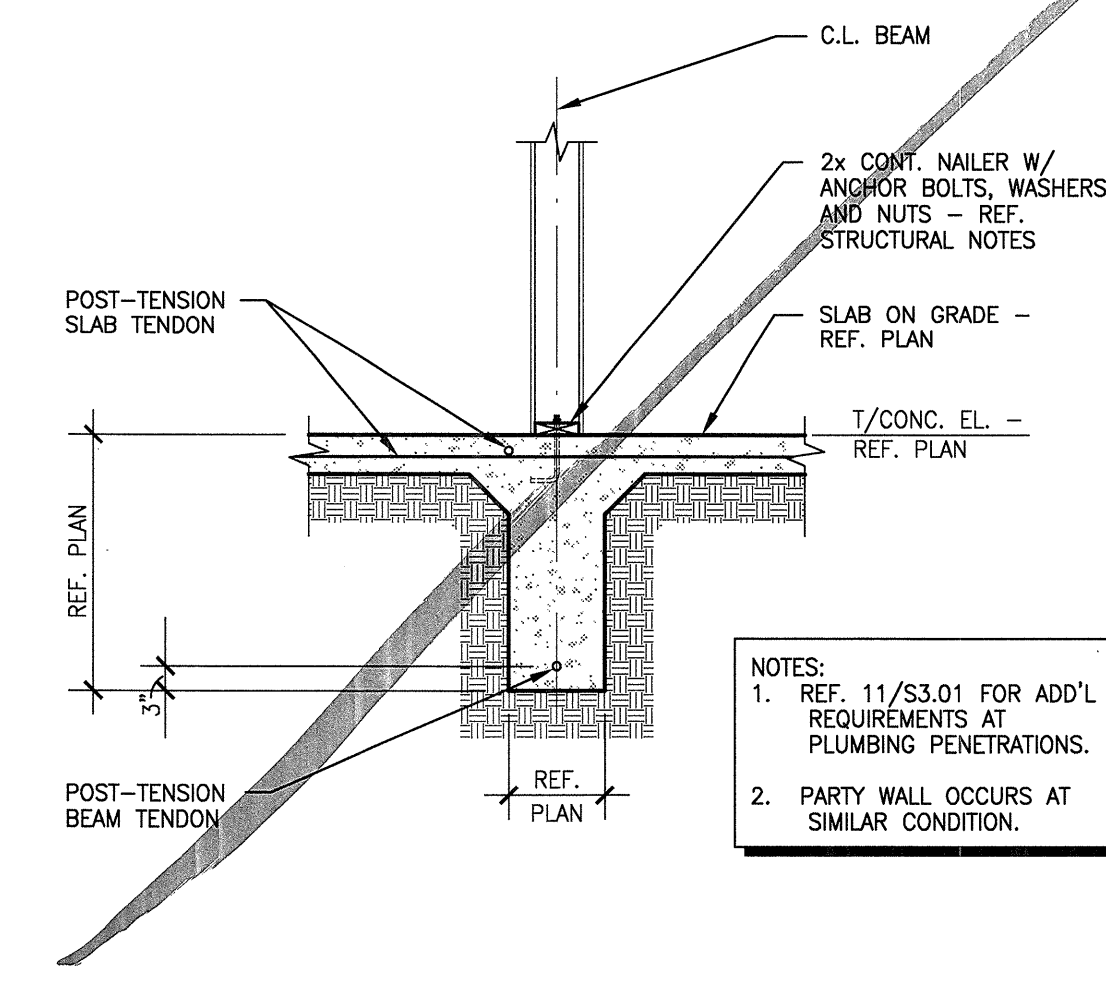

10 SECTION  
SCALE: 1/2"=1'-0"

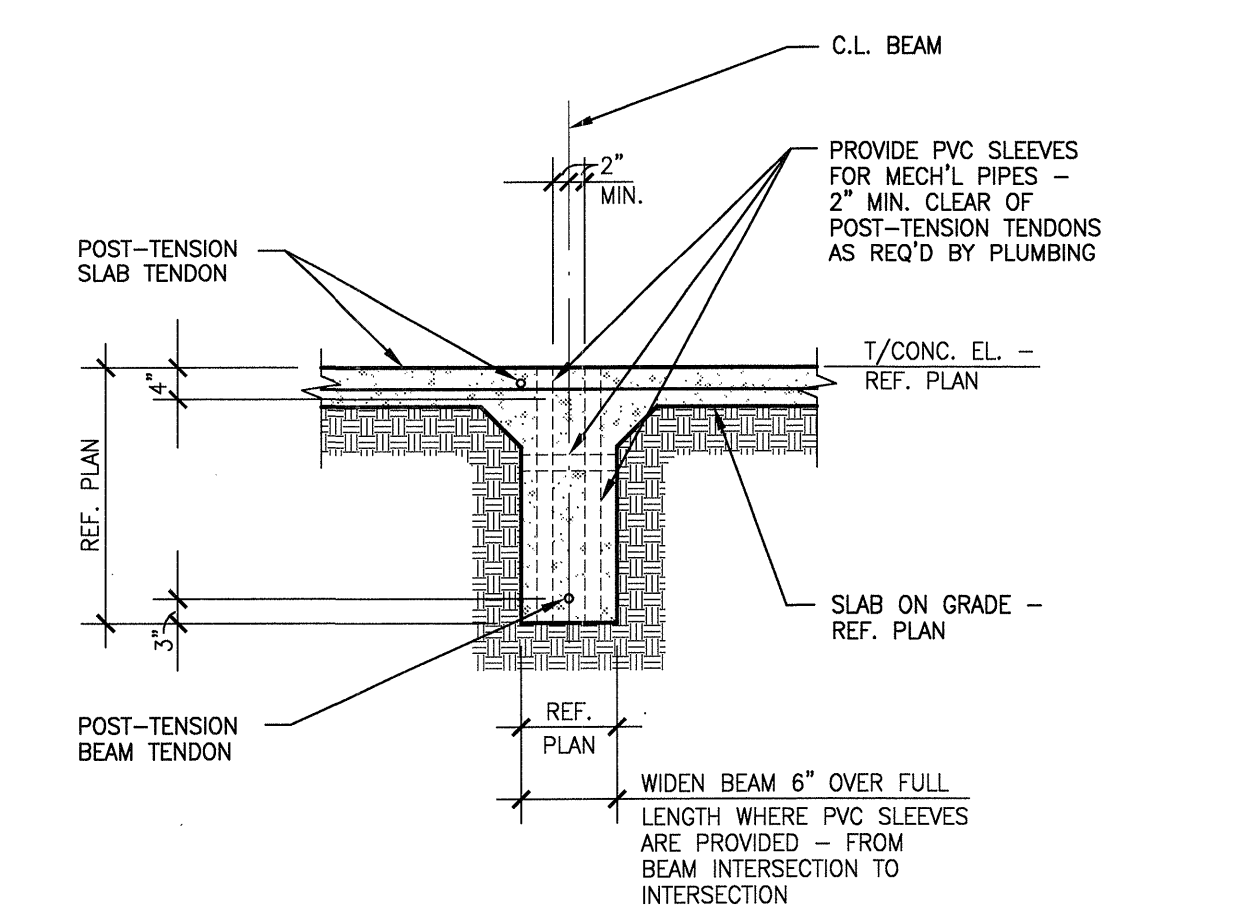

11 SECTION  
SCALE: 1/2"=1'-0"

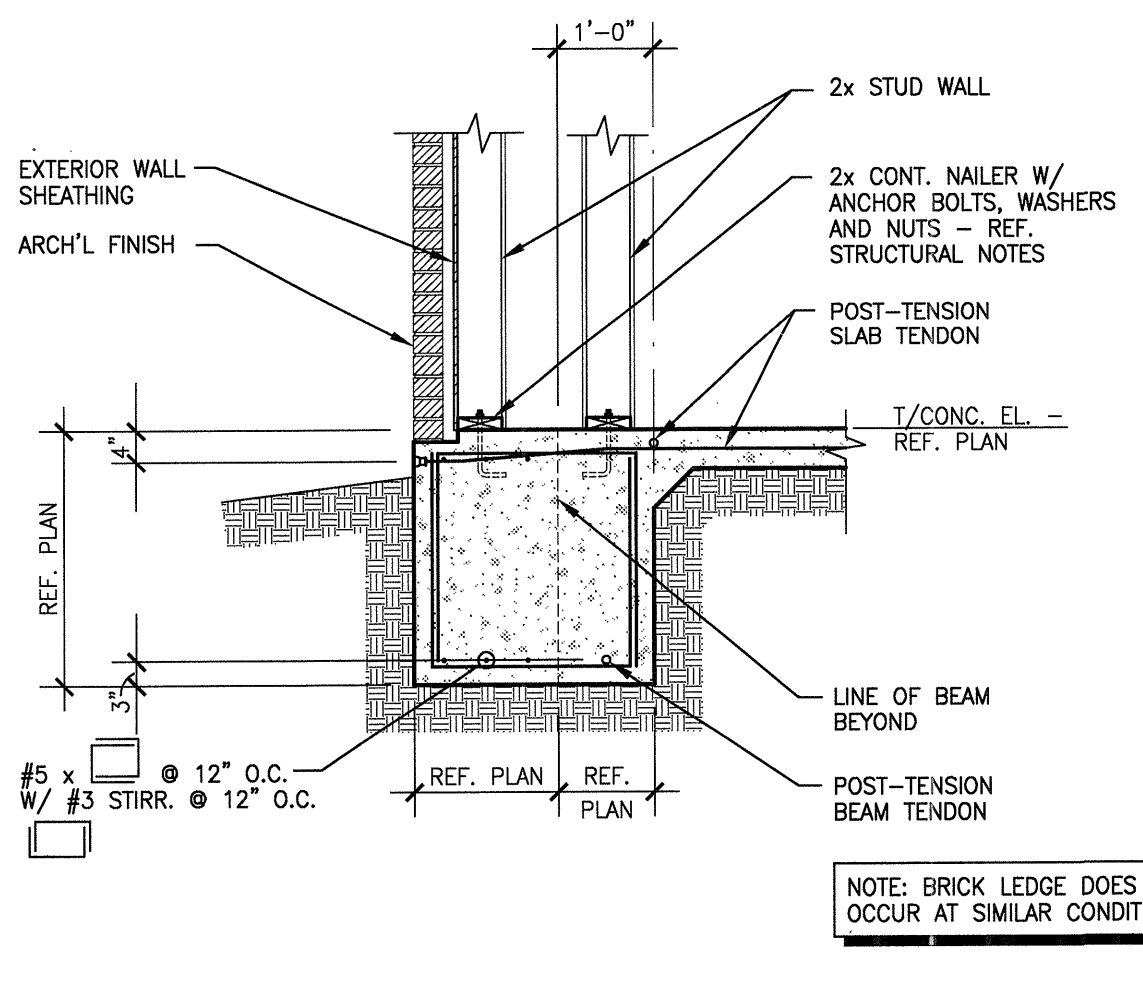

12 SECTION  
SCALE: 1/2"=1'-0"


NOTES:  
1. REF. 11/S3.01 FOR ADD'L REQUIREMENTS AT PLUMBING PENETRATIONS.  
2. PARTY WALL OCCURS AT SIMILAR CONDITION.

NOTE: REINFORCE GRADE BEAM PER 7/S3.01 AT SIM. CONDITION

NOTE: BRICK LEDGE DOES NOT OCCUR AT SIMILAR CONDITION

NOTE: BRICK LEDGE DOES NOT OCCUR AT SIMILAR CONDITION

NOTE: BRICK LEDGE DOES NOT OCCUR AT SIMILAR CONDITION

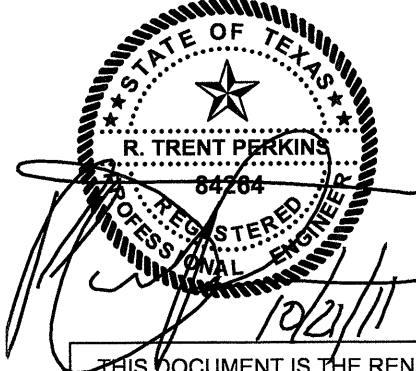

THE SEAL APPEARING ON THIS DOCUMENT WAS AUTHORIZED BY R. TRENT PERKINS, P.E. 94284

THIS DOCUMENT IS THE RENDERING OF A PROFESSIONAL SERVICE, THE ESSENCE OF WHICH IS THE PROVIDING OF ADVICE, JUDGEMENT, OPINION, OR SIMILAR PROFESSIONAL SKILL.

PARKIN - PERKINS - OLSEN CONSULTING ENGINEERING, INC.  
9330 LBJ Freeway Suite 1055  
Dallas, Texas 75243  
Tel 214.221.2220 Fax 214.221.2228  
Project No. 39155 Registration No. E-1479

NO.	REVISIONS

**KELLER SPRINGS LOFTS**  
LOFT APARTMENTS IN ADDISON, TEXAS

CONSTRUCTION ISSUE  
10-17-2011

**BGO architects**  
4144 N. Central Expy., Suite 855  
Dallas, TX 75204  
214.520.8878  
bgoarchitects.com

DATE  
08-05-2011

PROJECT  
11129

SHEET NUMBER

**S3.01**