

4-#6 x 6'-0" DOWELS

CONTINUOUS

GRADE BEAM -

REF. PLAN

1. SLAB ON GRADE OMITTED FOR CLARITY.

REF. PLAN FOR ADDITIONAL INFORMATION.

2. GRADE BEAM STIRRUPS OMITTED FOR CLARITY. REF. SECTIONS FOR ADDITIONAL

INFORMATION.

— 16"x16"x16" DEEP SUMP PIT

#4 DOWELS AT 12" O.C.

EACH WAY

REF. SECTIONS

TOP OF GRADE BEAM

GRADE BEAM STEEL -

EXTEND TO WITHIN 3" OF




ELEVATION


MINIMUM


TYPICAL STEP IN

GRADE BEAM DETAIL




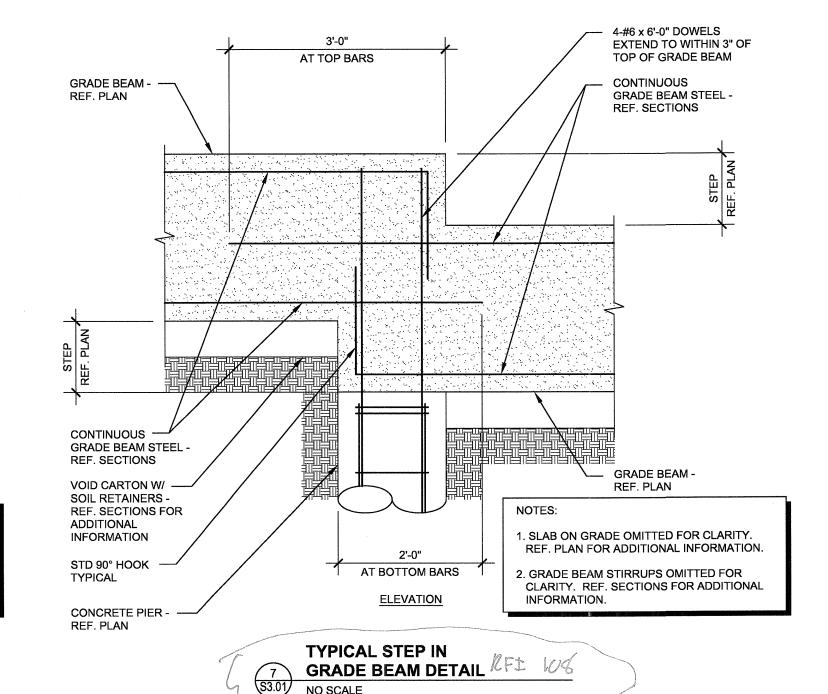

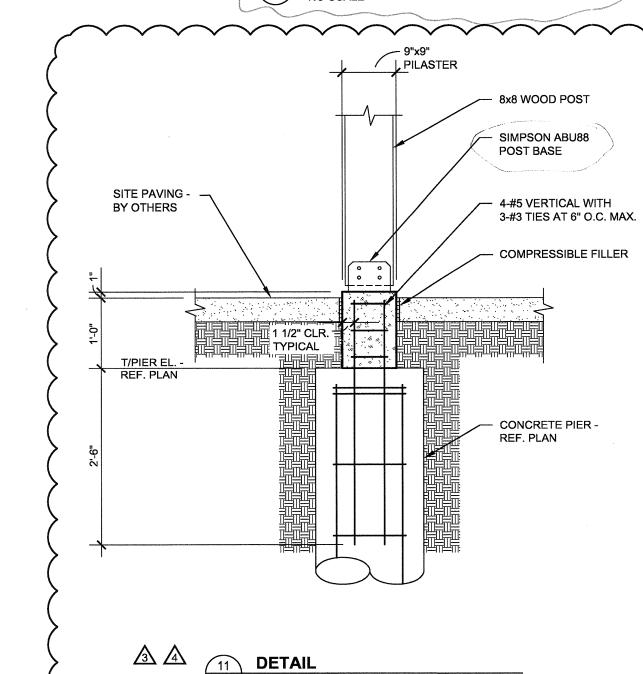


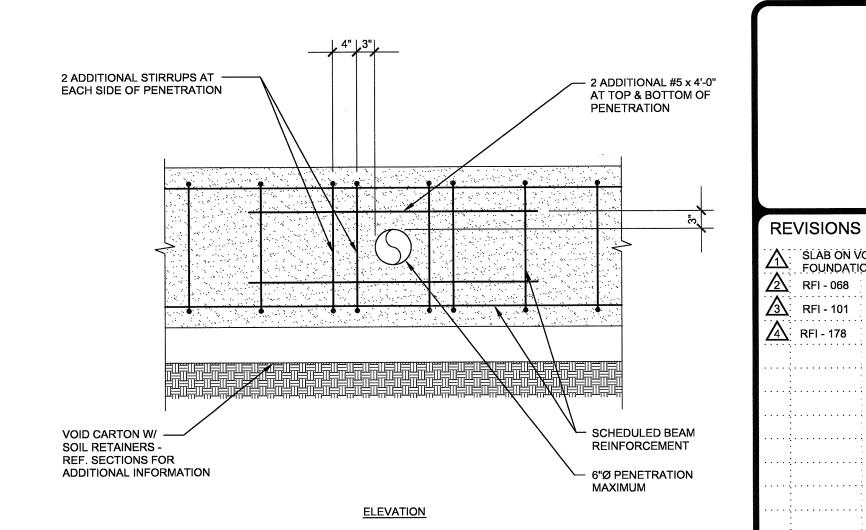



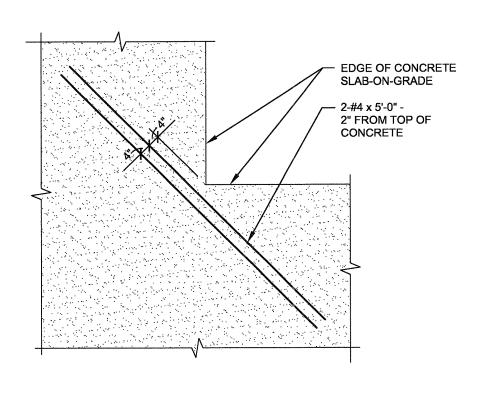

TYPICAL RE-ENTRANT SLAB CORNER REINFORCING DETAIL NO SCALE

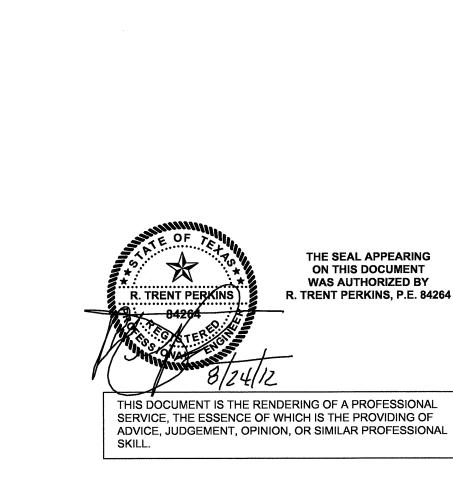



Registration No.



SLAB ON VOID

FOUNDATION

RFI - 101

11/18/2011

03/01/2012

5/30/2012

8/23/2012

architects

4144 N. Central Expy., Suite 855 Dallas, TX 75204 214.520.8878 bgoarchitects.com

DATE

08-05-2011

PROJECT 11129

SHEET NUMBER