

REVISIONS	
1	9-2-2011 DESIGN REVISIONS
2	9-13-2011 ANSI/FHA COMMENTS
3	9-23-2011 DESIGN REVISIONS
4	10-17-2011 CONSTRUCTION ISSUE
5	12-21-2011 DESIGN REVISIONS
6	1-17-2012 DESIGN REVISIONS
7	2-15-2012 TRANSFORMER REVISIONS
8	3-27-2012 CLUBHOUSE REVISIONS
9	4-17-2012 COORDINATION

**KELLER SPRINGS LOFTS**  
 LOFT APARTMENTS IN ADDISON, TEXAS

10	5-15-2012 COORDINATION
11	5-30-2012 SITE COORDINATION
12	6-01-12 LIGHTING REVISIONS
13	6-29-12 SITE COORDINATION
14	9-05-12 CLUB REVISIONS
15	4-19-13 EL. LOBBY REVISIONS

**BGO architects**  
 4144 N. Central Expy. Suite 855  
 Dallas, TX 75204  
 214.520.8878  
 bgoarchitects.com

DATE  
 08-05-11

PROJECT  
 11129


SHEET NUMBER

**M-3.6**  
**LEVEL 6 & 7**  
**GARAGE**  
**MECHANICAL**


**JSE** Jordan & Skala Engineers  
 17855 N. Dallas Parkway, Suite 320  
 Dallas, TX 75287-6857  
 V: (469) 385-1616 F: (469) 385-1615  
 Project Number - 113-0555 Texas Firm Registration # F-4990  
 Drawn By: **DKR** Checked By: **RBK**

**KEYNOTES:**


- 1 3/4"CD ROUTED DOWN TO FLOOR BELOW.
- 2 3/4"CD ROUTED FROM PTAC ABOVE. THE CD FROM LEVEL 6 AND LEVEL 7 INTO A 1"CD RISER.
- 3 3/4"CD ROUTED FROM PTAC TO CD RISER. ROUTE RISER DOWN TO ROOF BELOW.
- 4 72x18 ELEVATOR SMOKE RELIEF LOUVER STUBBED INTO SIDE OF ELEVATOR SHAFT AND SEALED AIR & WATER TIGHT. MOUNT LOUVER 12" BELOW TOP OF HOISTWAY. PROVIDE WITH MOTORIZED DAMPER INTERLOCKED TO FIRE ALARM. DAMPER SHALL FAIL IN THE OPEN POSITION.

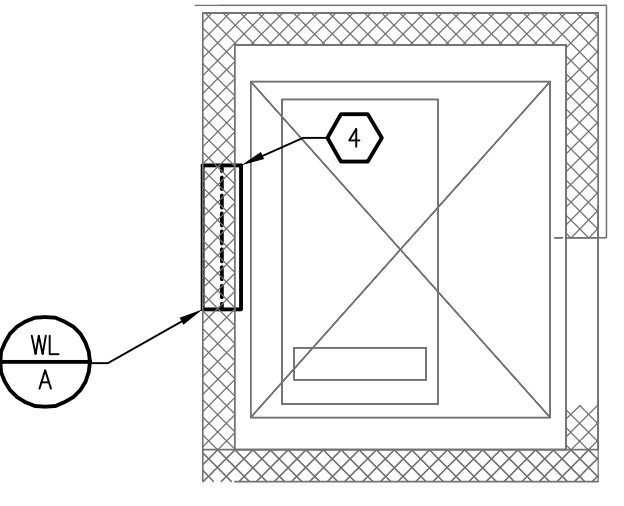

5 TOP OF ELEVATOR SHAFT — MECHANICAL  
 SCALE: 1/4" = 1'-0"

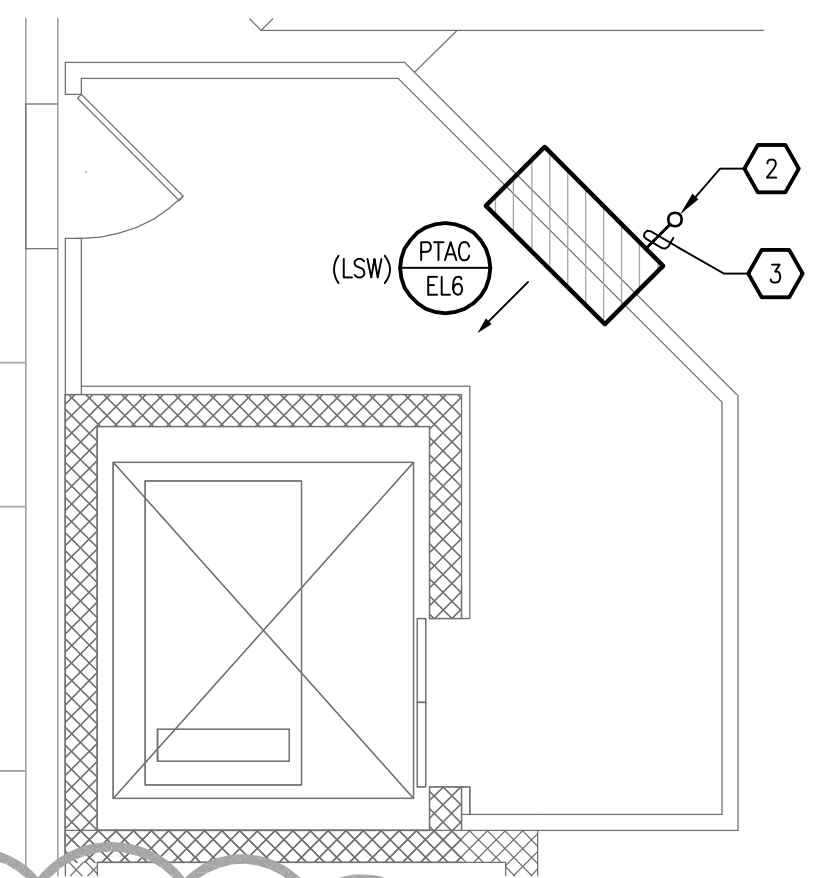

3 6TH FLOOR ENLARGED ELEVATOR LOBBY — MECHANICAL  
 SCALE: 1/4" = 1'-0"

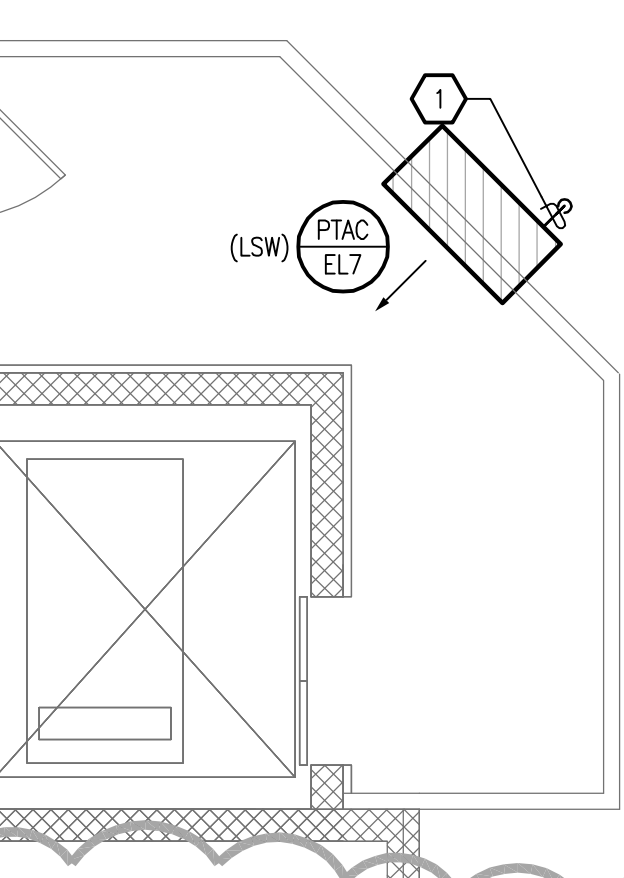


4 7TH FLOOR ENLARGED ELEVATOR LOBBY — MECHANICAL  
 SCALE: 1/4" = 1'-0"



1 6TH FLOOR GARAGE PLAN — MECHANICAL  
 SCALE: 1/16" = 1'-0"

2 7TH FLOOR GARAGE PLAN — MECHANICAL  
 SCALE: 1/16" = 1'-0"

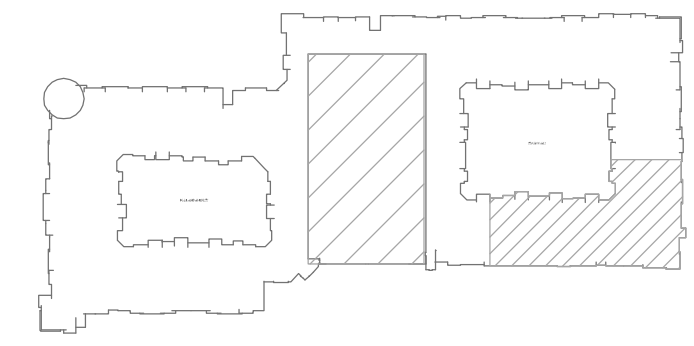

4