



REVISIONS


1	9-2-2011	DESIGN REVISIONS
2	9-13-2011	ANSI/FHA COMMENTS
3	9-23-2011	DESIGN REVISIONS
4	10-17-2011	CONSTRUCTION ISSUE

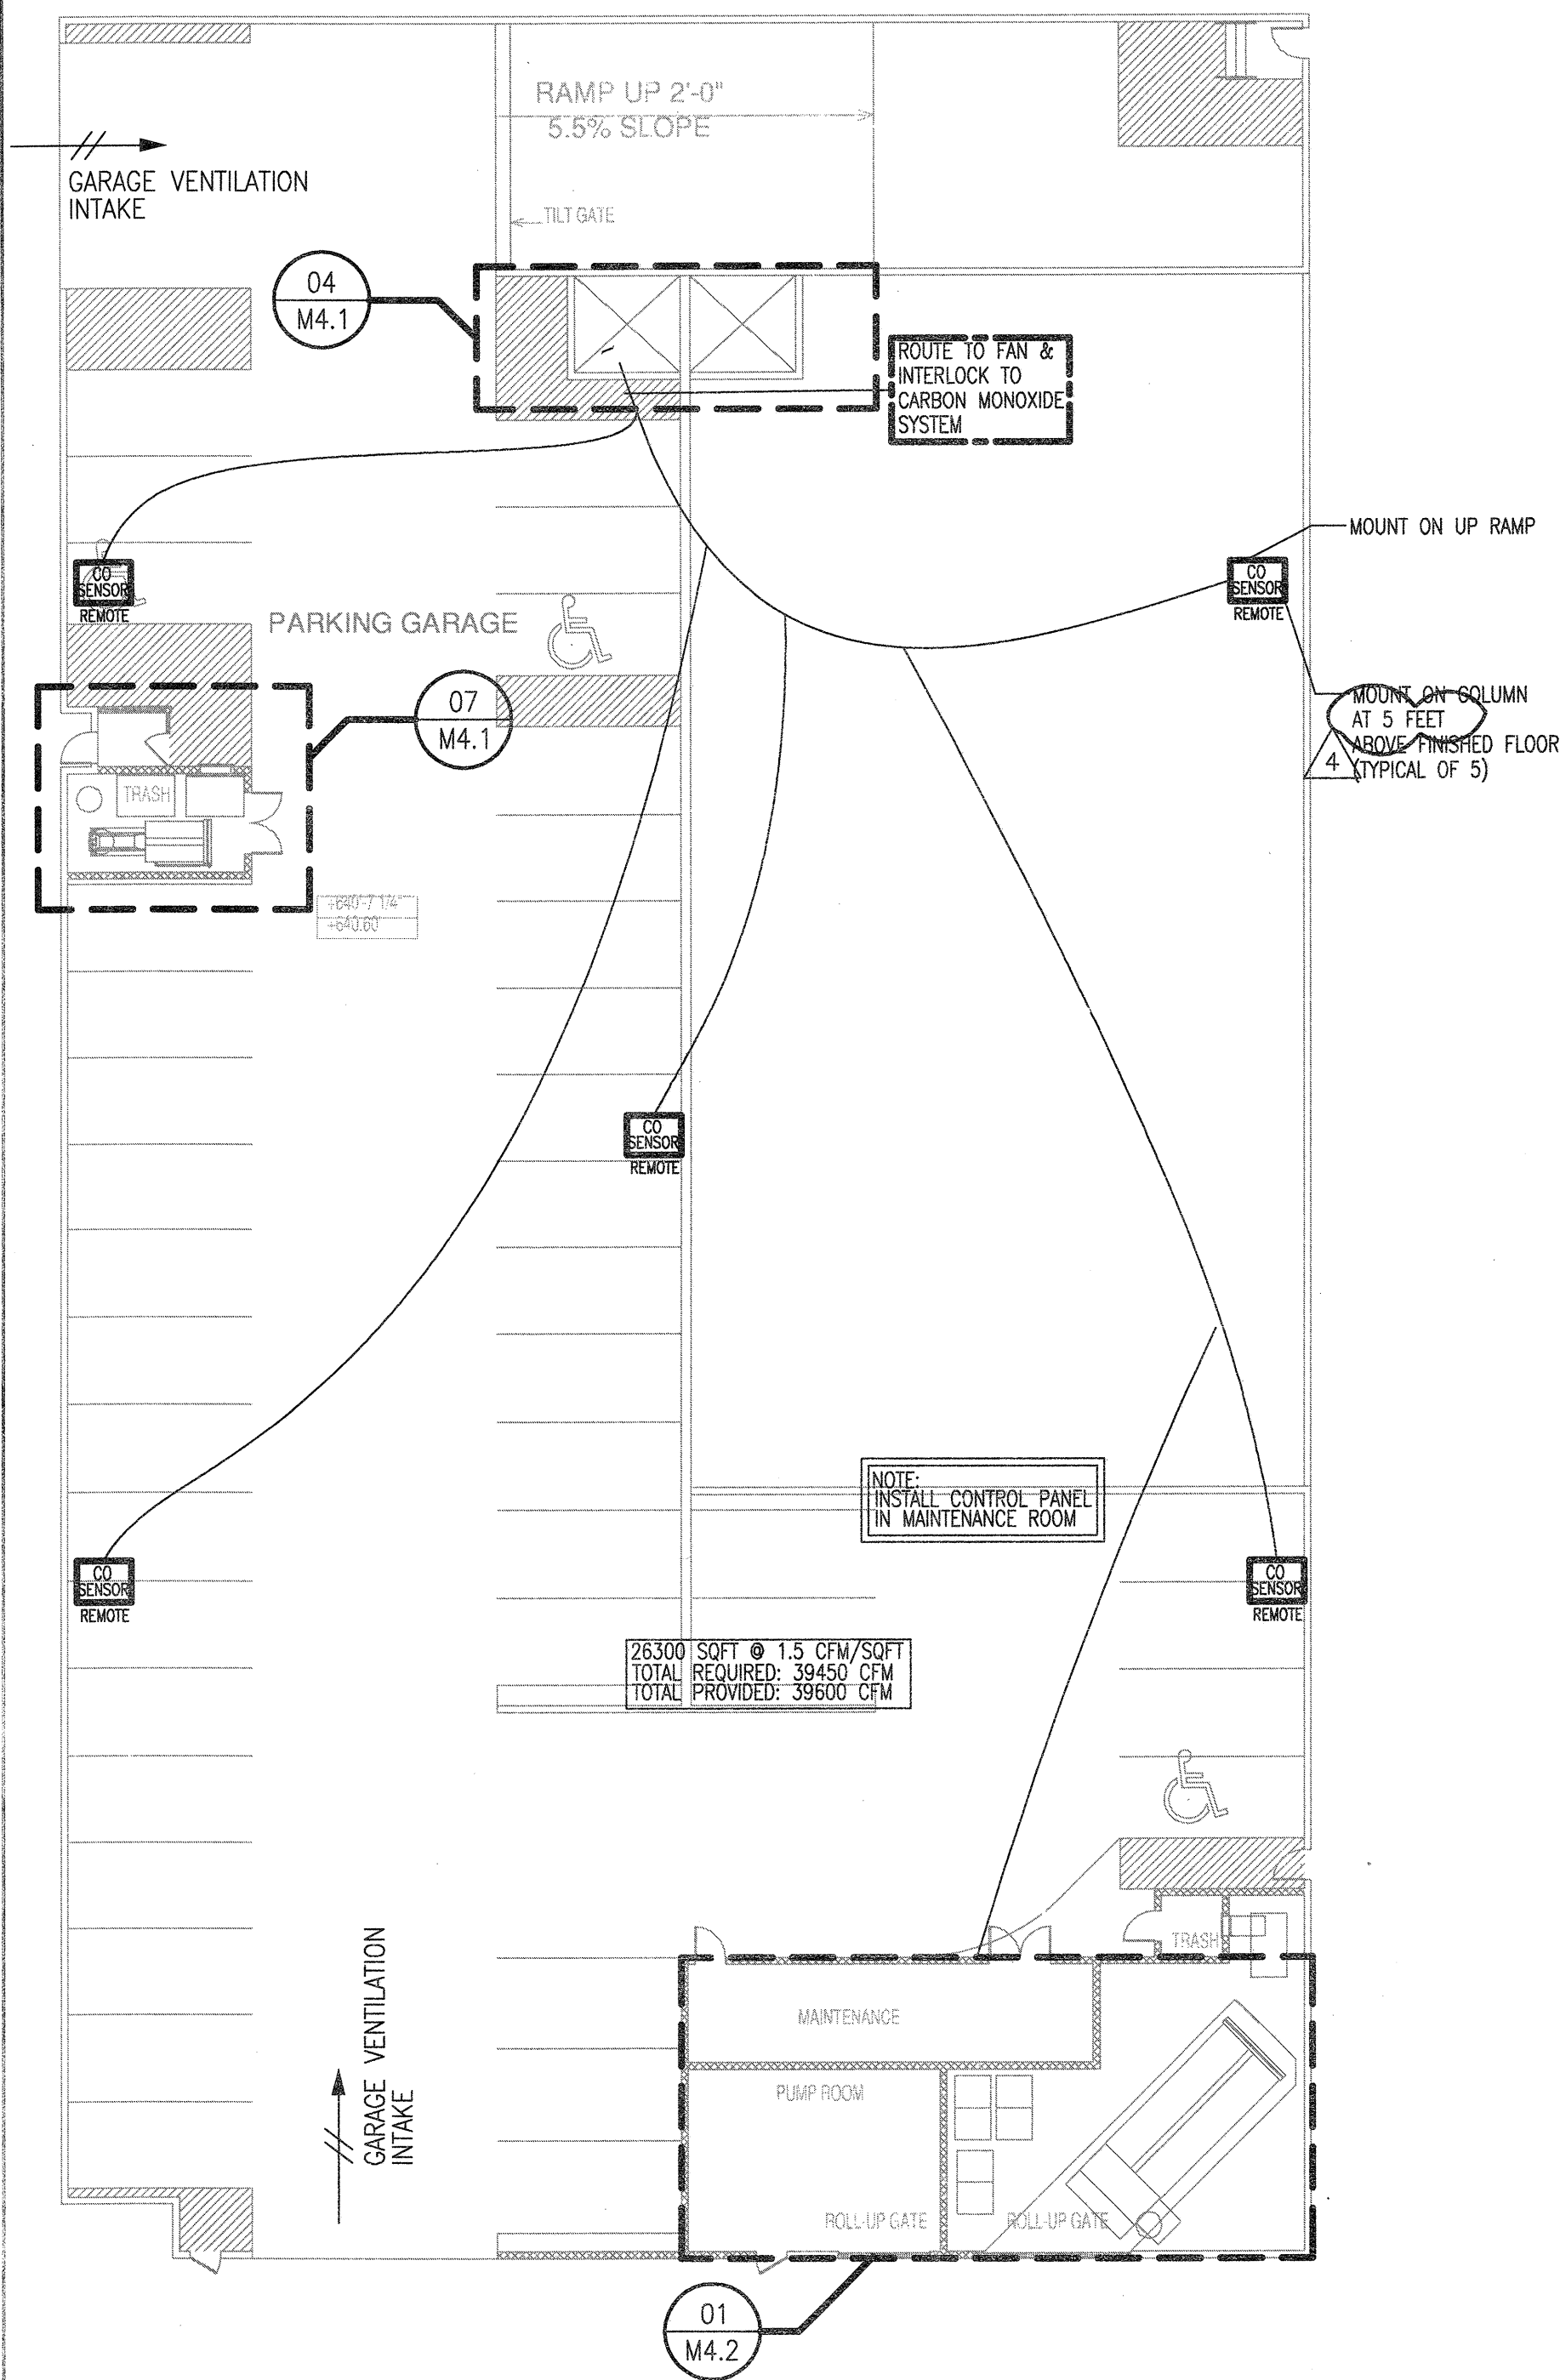

1 1ST FLOOR GARAGE PLAN - MECHANICAL
SCALE: 1/16" = 1'-0"

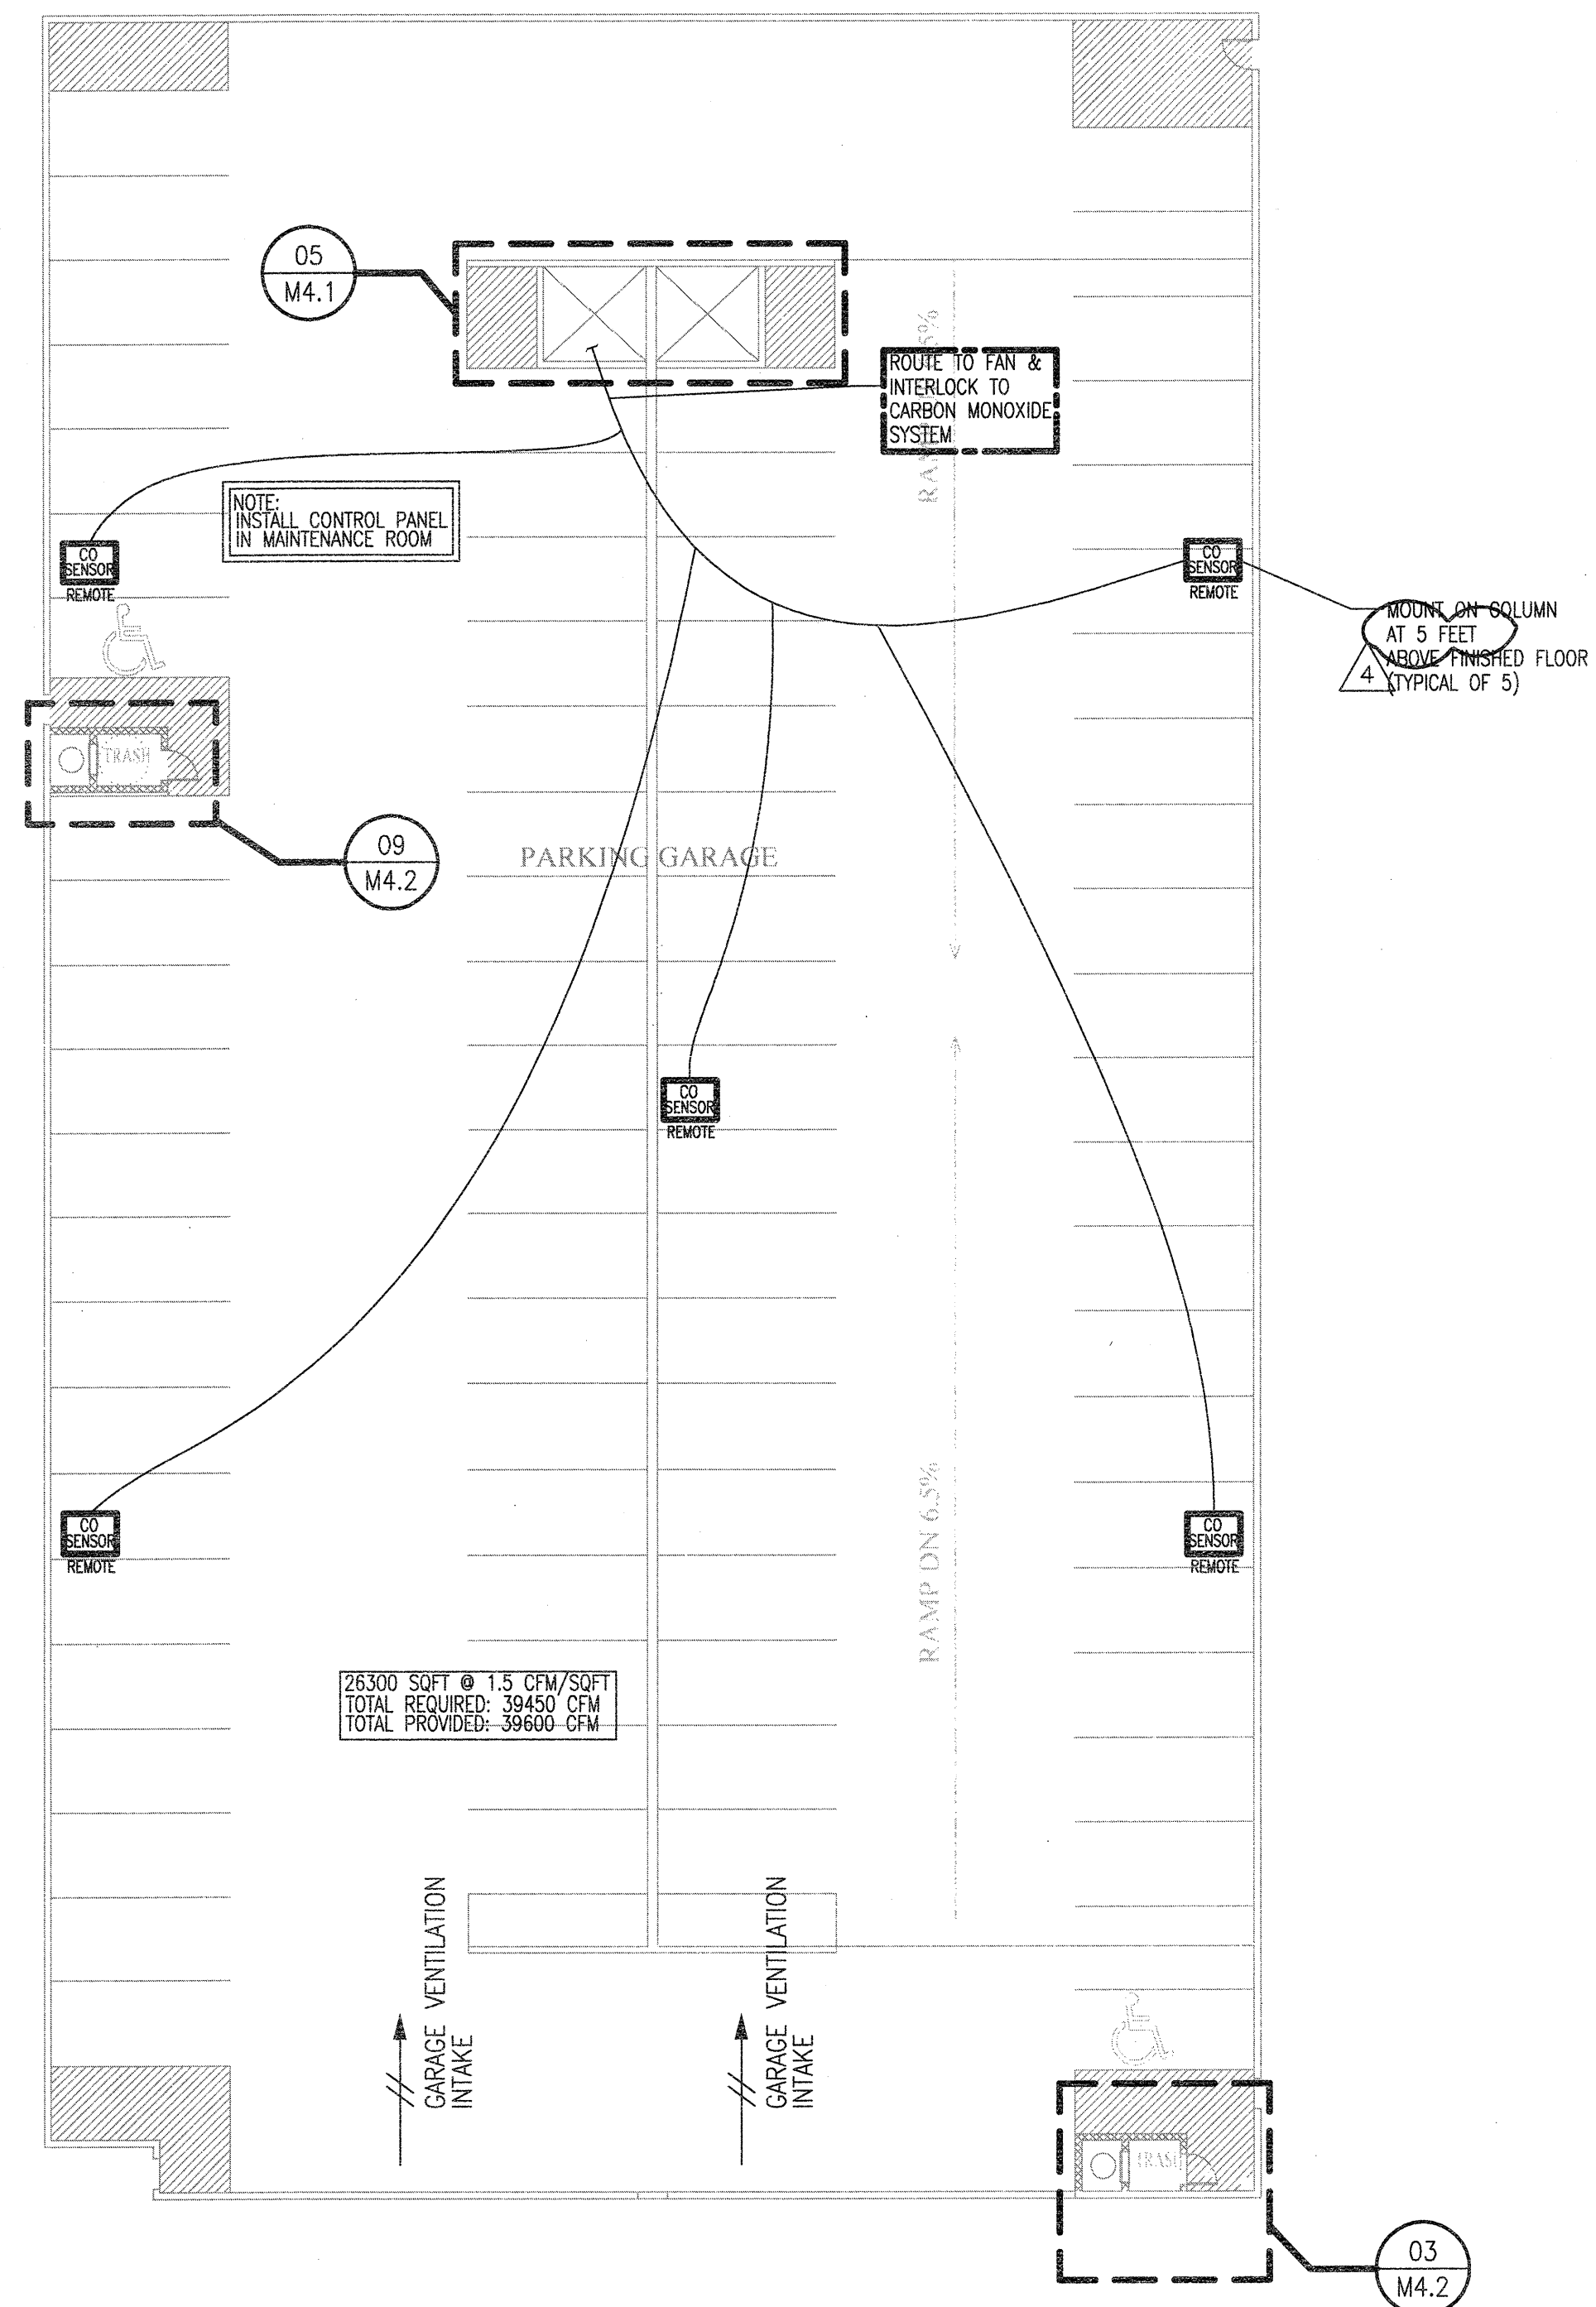

2 2ND FLOOR GARAGE PLAN - MECHANICAL
SCALE: 1/16" = 1'-0"

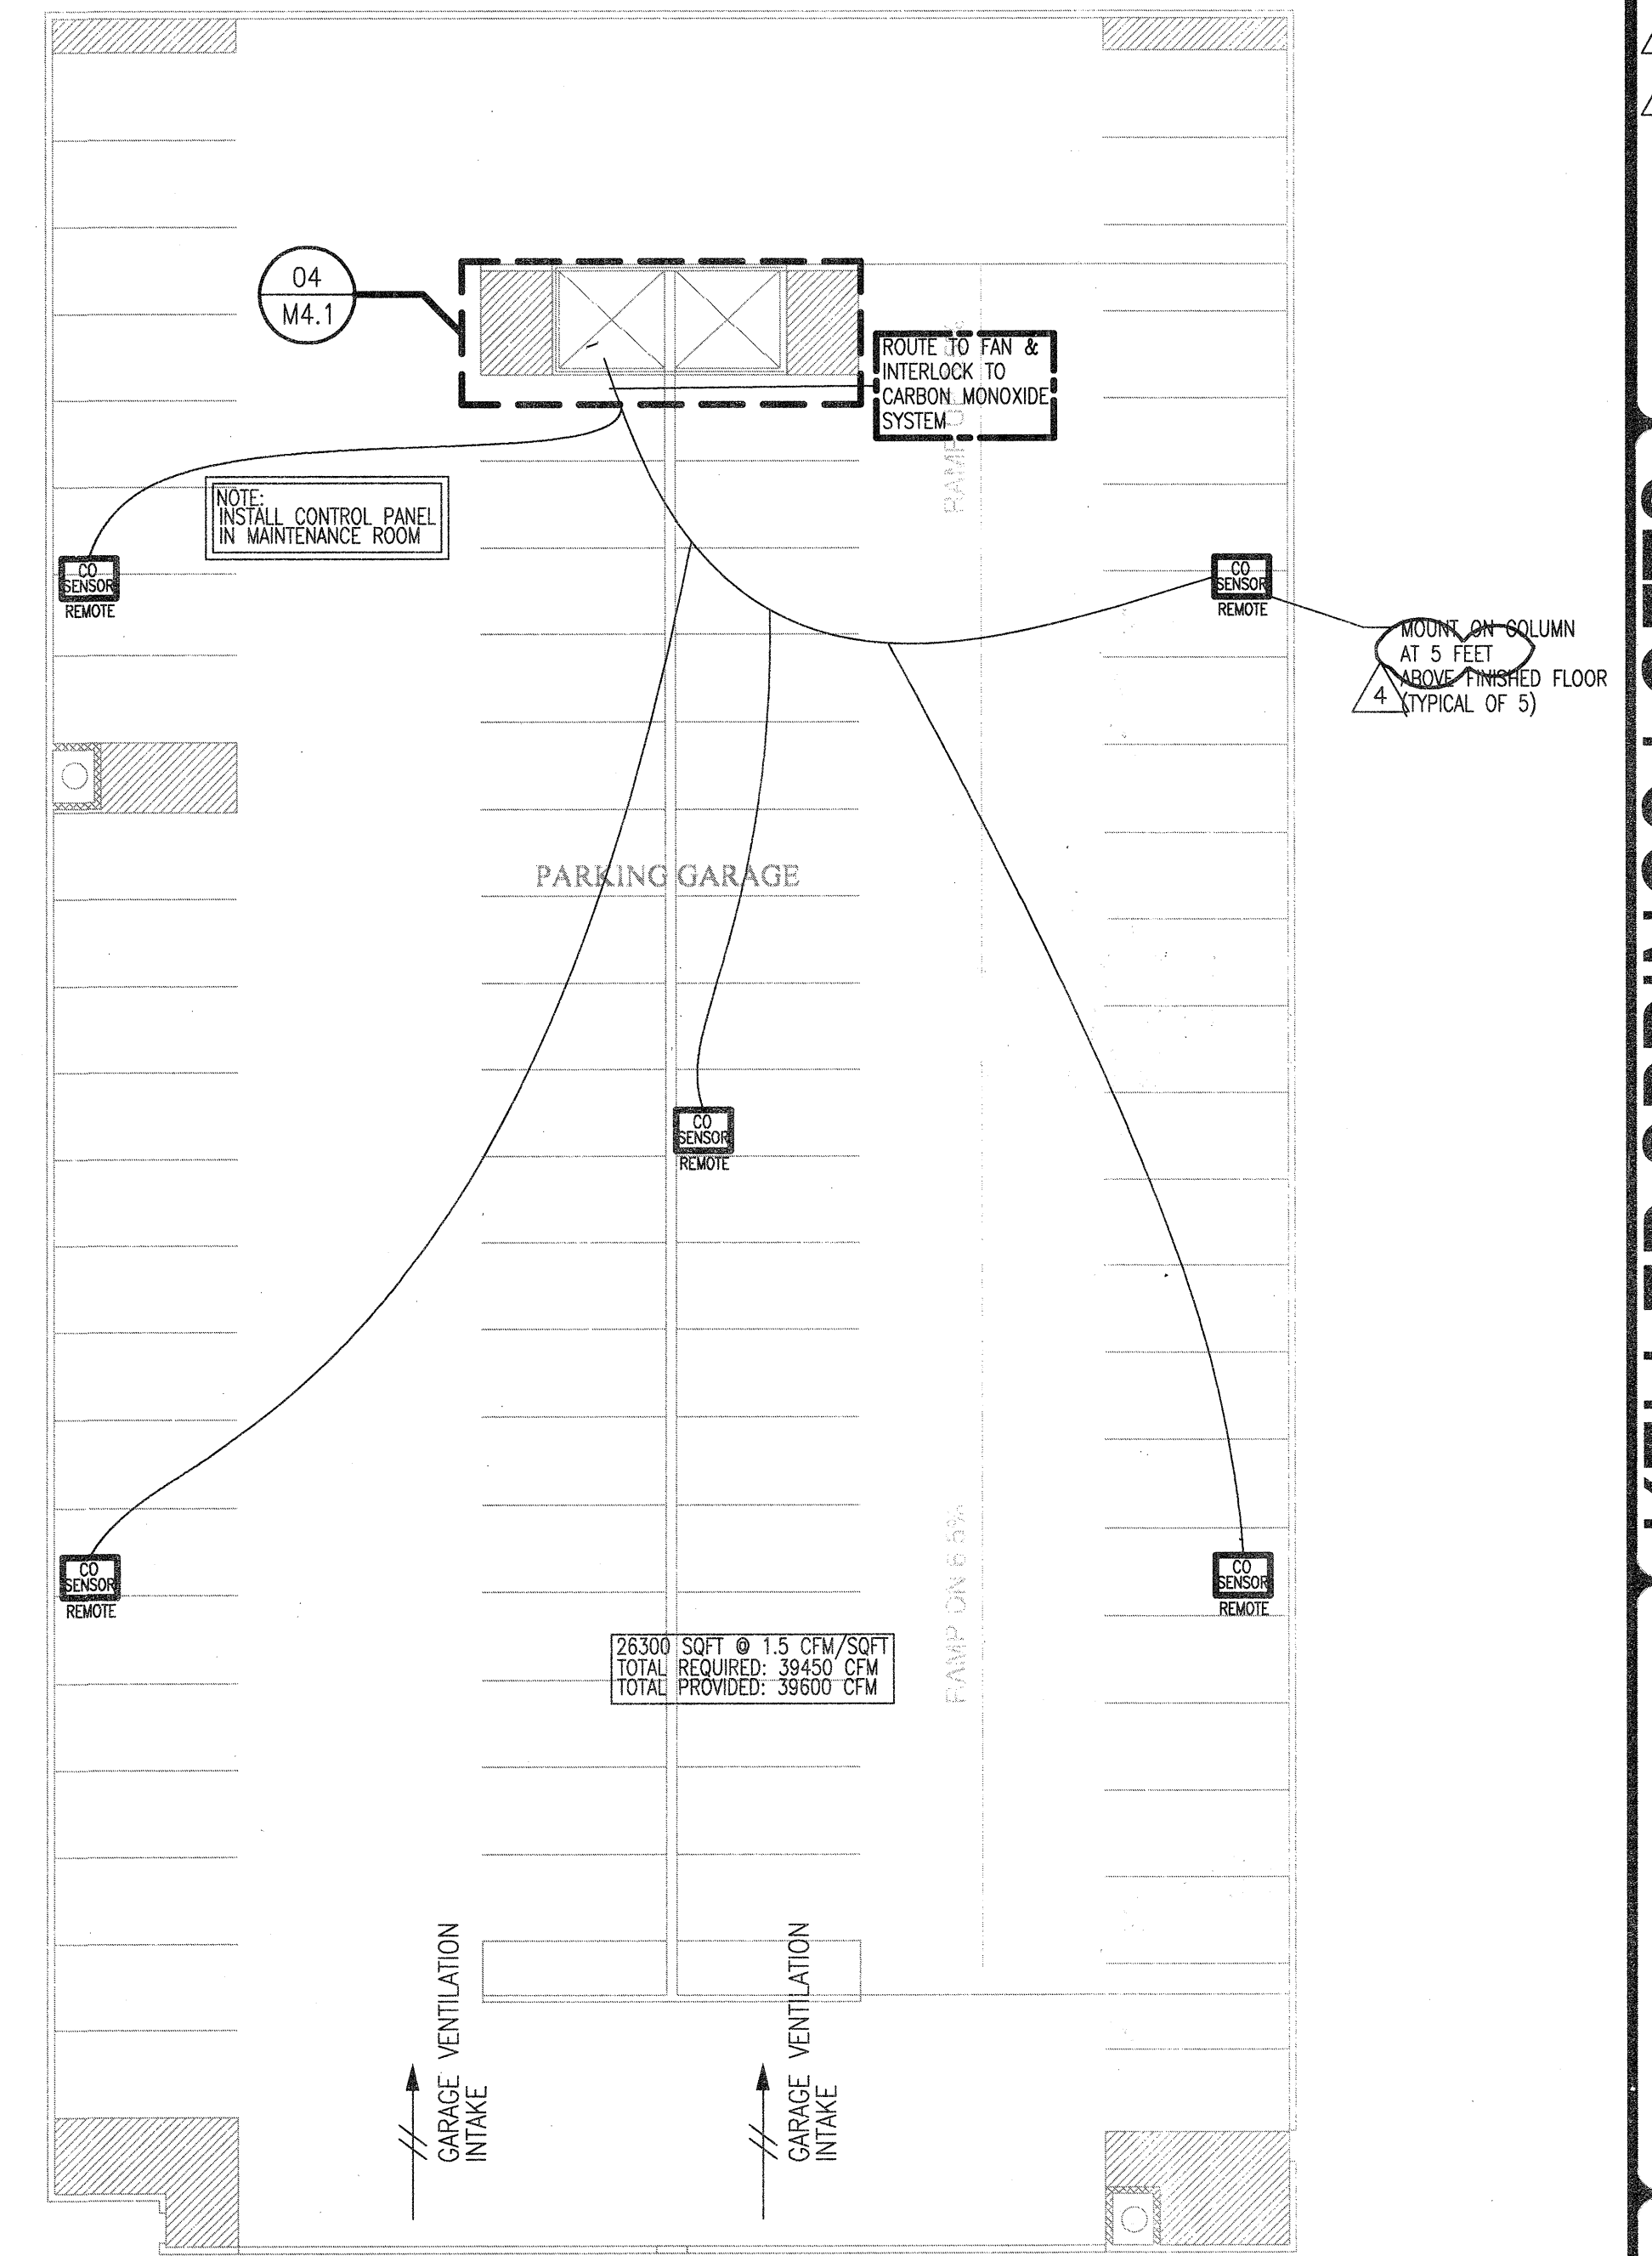

3 3RD FLOOR GARAGE PLAN - MECHANICAL
SCALE: 1/16" = 1'-0"

7th FLOOR IS OPEN ABOVE, NO MECHANICAL VENTING IS REQUIRED.

KELLER SPRINGS LOFTS

LOFT APARTMENTS IN ADDISON, TEXAS

AS BUILT



4144 N. Central Exp. Suite 855
Dallas, TX 75204
214.520.8878
bgoarchitects.com

DATE
08-05-11

PROJECT
11129

SHEET NUMBER

M-3.0

GARAGE MECHANICAL

JSE Jordan & Skala Engineers
14780 Midway Road, Suite 350
Dallas, TX 75244-5138
Project Number - 113-055 Texas Firm Registration # F-4990
Drawn By: CJH Checked By: AHS