


REVISIONS

- 1 9-2-2011 DESIGN REVISIONS
- 2 9-13-2011 ANSI/FHA COMMENTS
- 3 9-23-2011 DESIGN REVISIONS
- 4 10-17-2011 CONSTRUCTION ISSUE

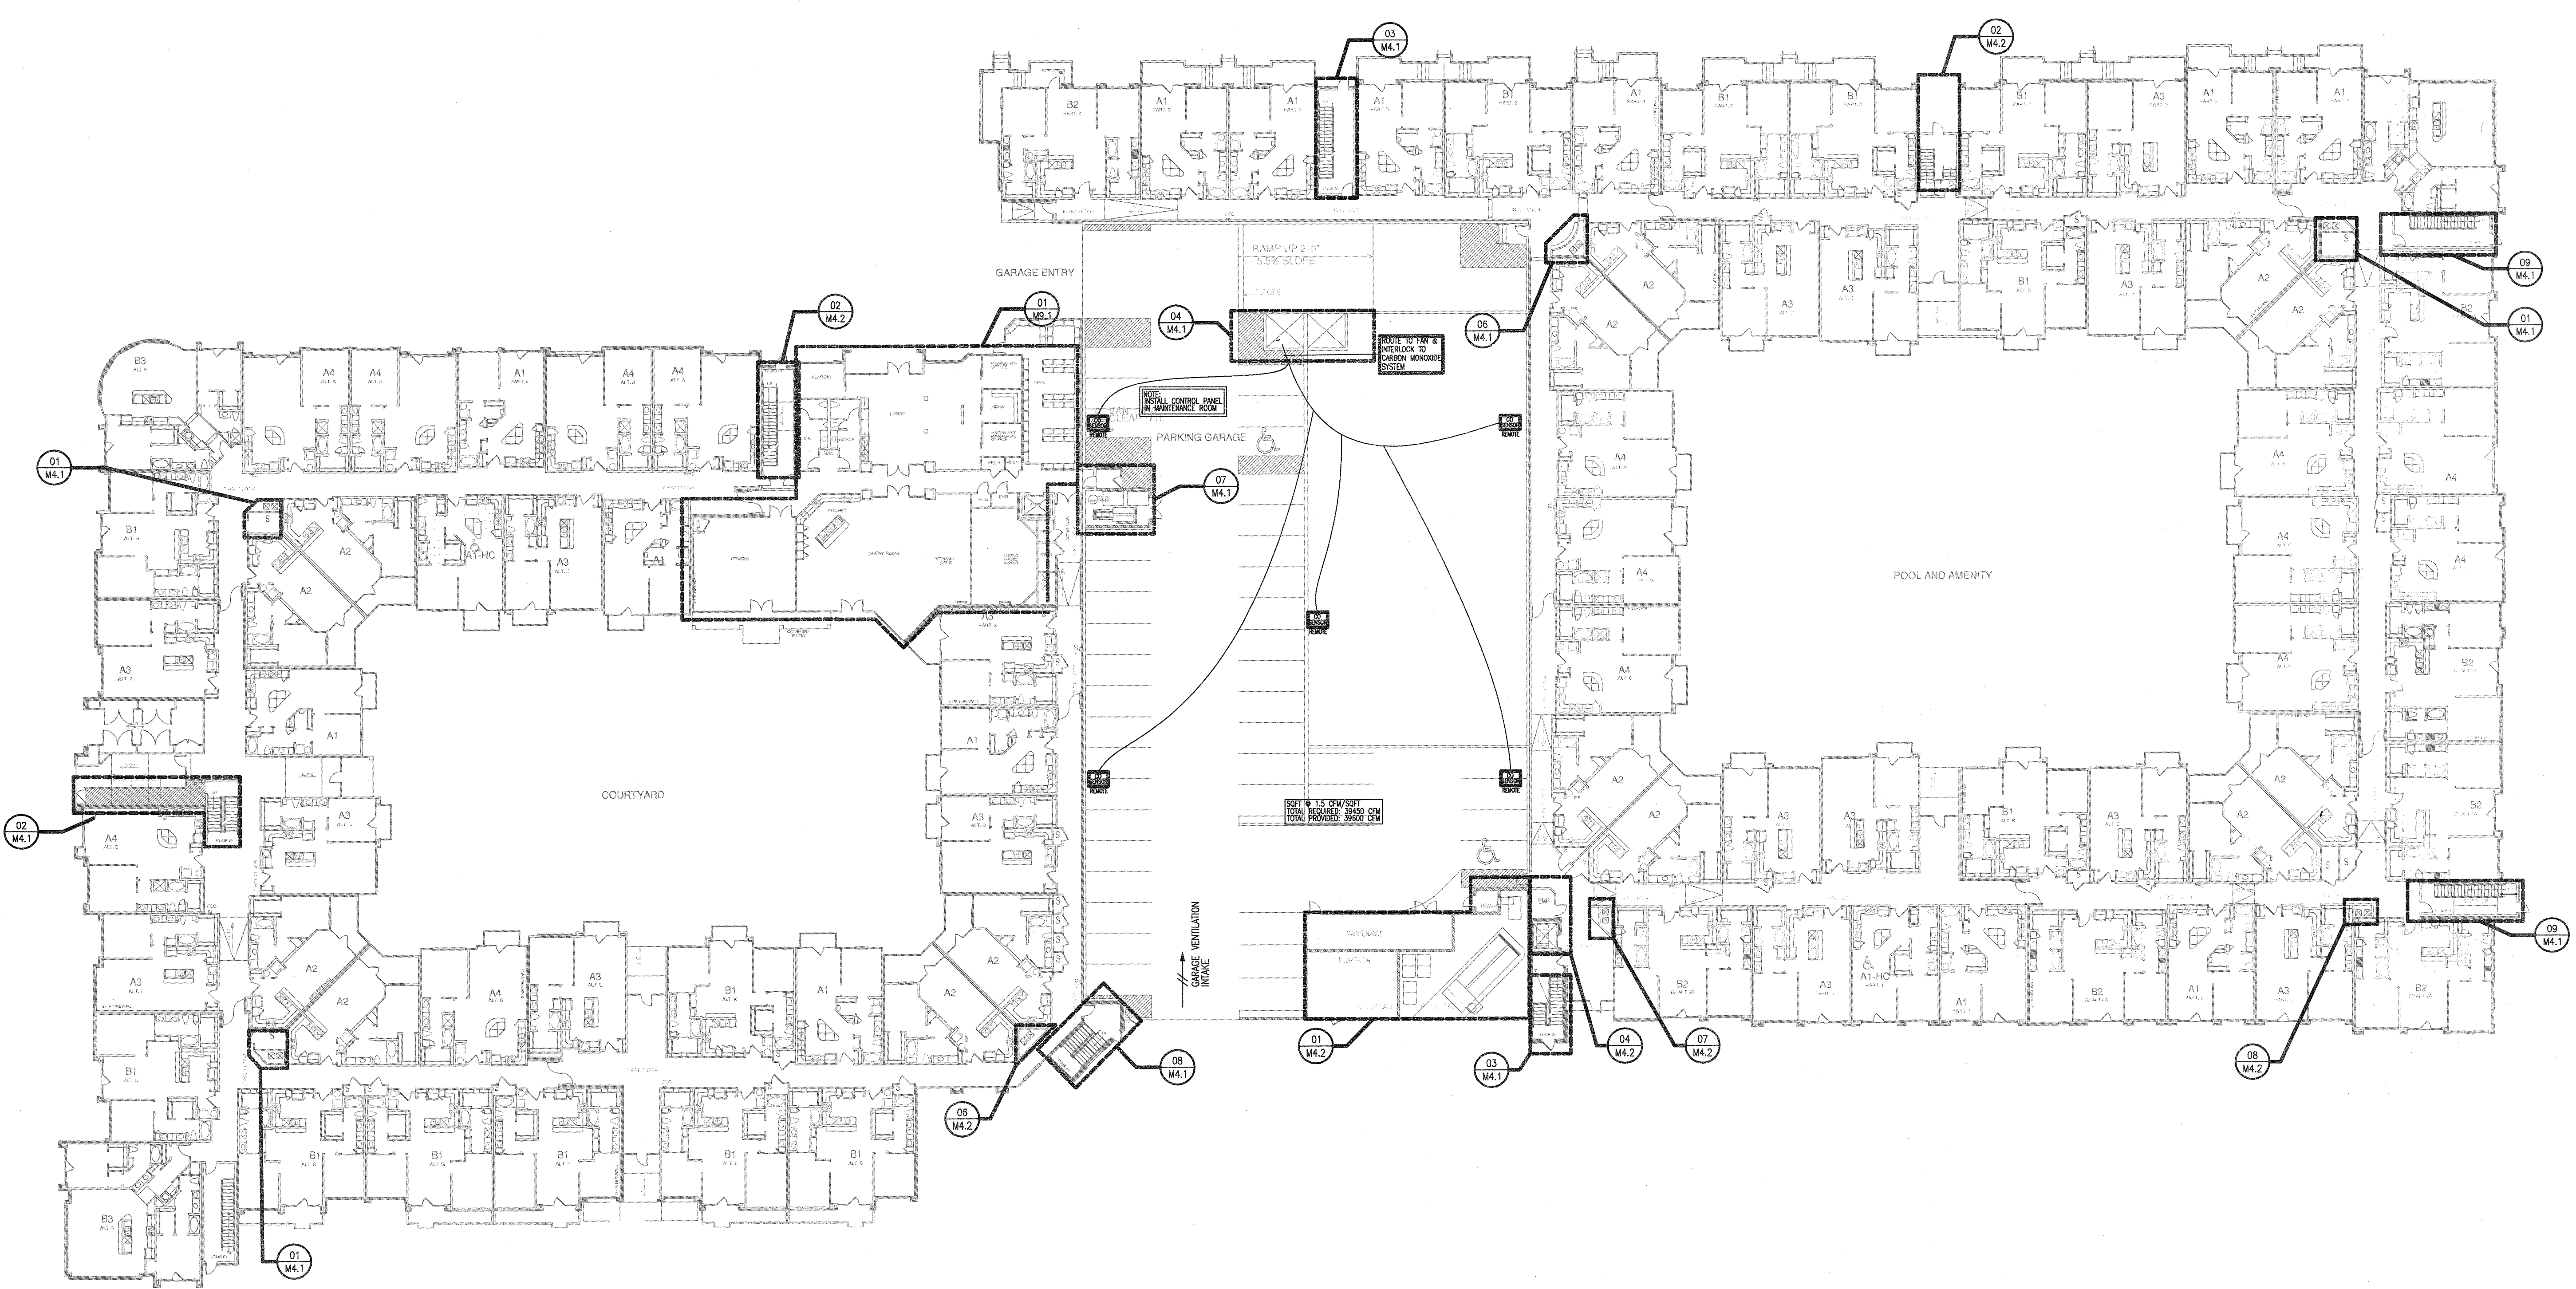

1 OVERALL FIRST FLOOR PLAN
SCALE: NOT TO SCALE

KELLER SPRINGS LOFTS

LOFT APARTMENTS IN ADDISON, TEXAS

AS BUILT



4144 N. Central Expy.
Suite 855
Dallas, TX 75204
214.520.8878
bgoarchitects.com

DATE
08-05-11

PROJECT
11129

SHEET NUMBER

M-3.1
FIRST FLOOR
BUILDING
MECHANICAL

JSE Jordan & Skala Engineers
14240 Midway Road, Suite 330
Dallas, TX 75244-0149
Project Number - 113-0355 Texas Firm Registration # F-4990
Drawn By: CJH Checked By: AHS