

REVISIONS	
1	9-2-2011 DESIGN REVISIONS
2	9-13-2011 ANS/FHA COMMENTS
3	9-23-2011 DESIGN REVISIONS
4	10-17-2011 CONSTRUCTION ISSUE

KELLER SPRINGS LOFTS

LOFT APARTMENTS IN ADDISON, TEXAS


AS BUILT

BGO
architects
4144 N. Central Exp.
Suite 855
Dallas, TX 75204
214.520.8878
bgoarchitects.com

DATE
08-05-11

PROJECT
11129

SHEET NUMBER
M-3.2
SECOND FLOOR
BUILDING
MECHANICAL

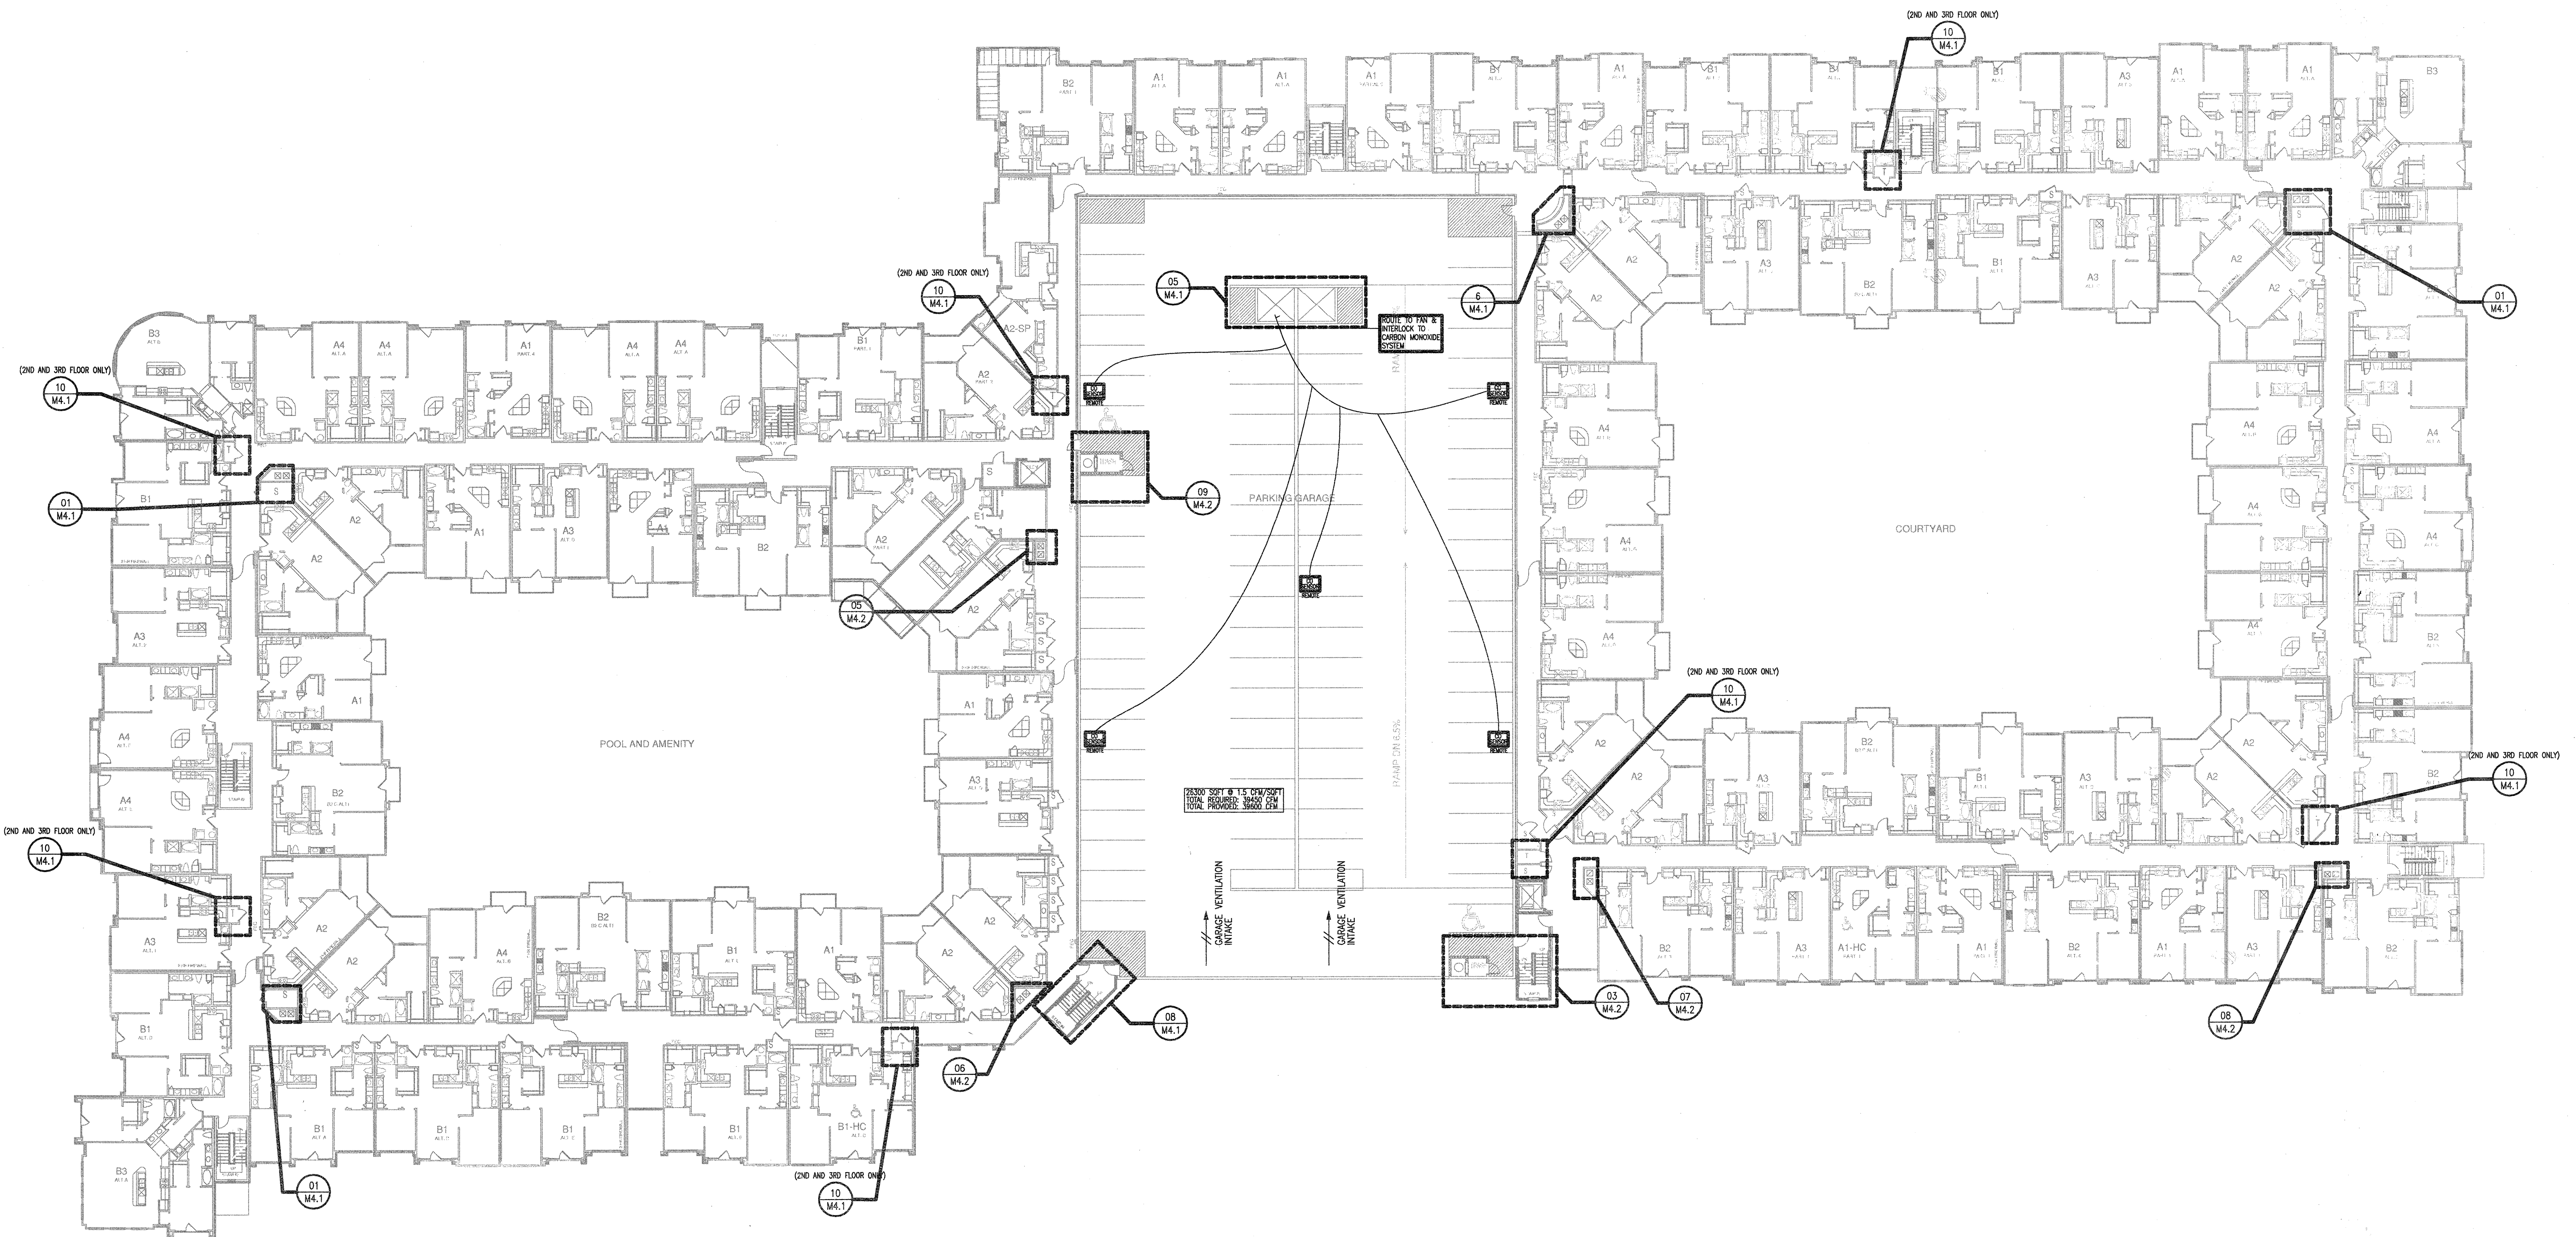

1 OVERALL SECOND-FOURTH FLOOR PLAN
SCALE: NOT TO SCALE

JSE Jordan & Skala Engineers
14750 Midway Road, Suite 320
Dallas, TX 75244 5138
V: (469) 385 1616 F: (469) 385 1615
Project Number - 113-0355 Texas Firm Registration # F-4990
Drawn By: CJH Checked By: AHS