


REVISIONS

1	9-2-2011	DESIGN REVISIONS
2	9-13-2011	ANSI/FHA COMMENTS
3	9-23-2011	DESIGN REVISIONS
4	10-17-2011	CONSTRUCTION ISSUE


KELLER SPRINGS LOFTS
LOFT APARTMENTS IN ADDISON, TEXAS

KEYNOTES: (APPLIES TO THIS SHEET ONLY)


1 ROUTE 1" CONDENSATE DRAIN TO HUB DRAIN.

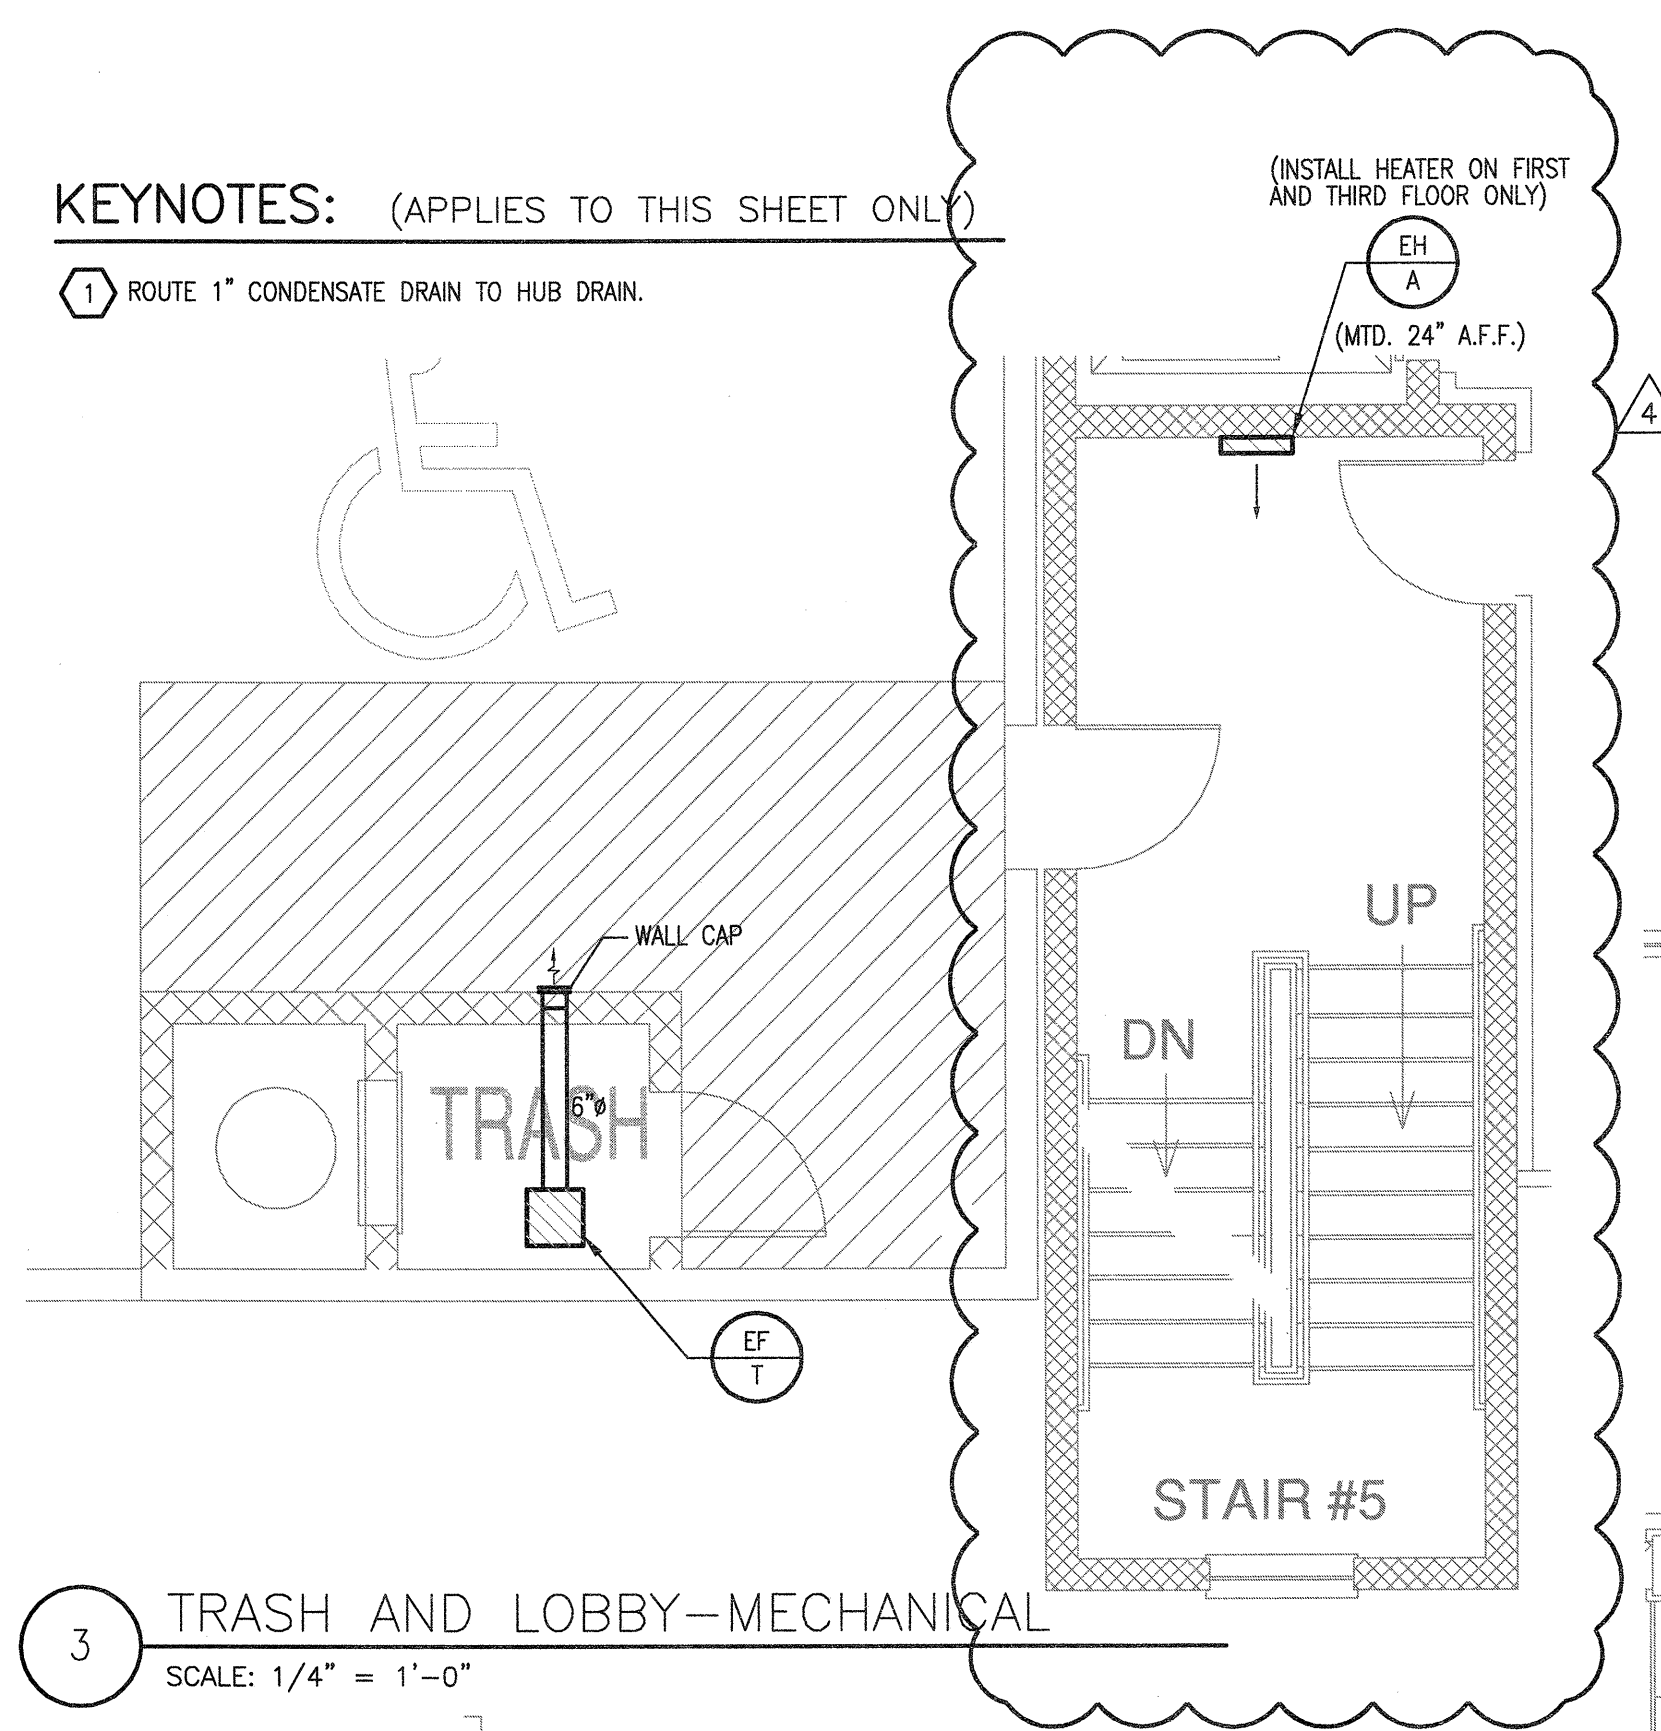

3 TRASH AND LOBBY-MECHANICAL
SCALE: 1/4" = 1'-0"

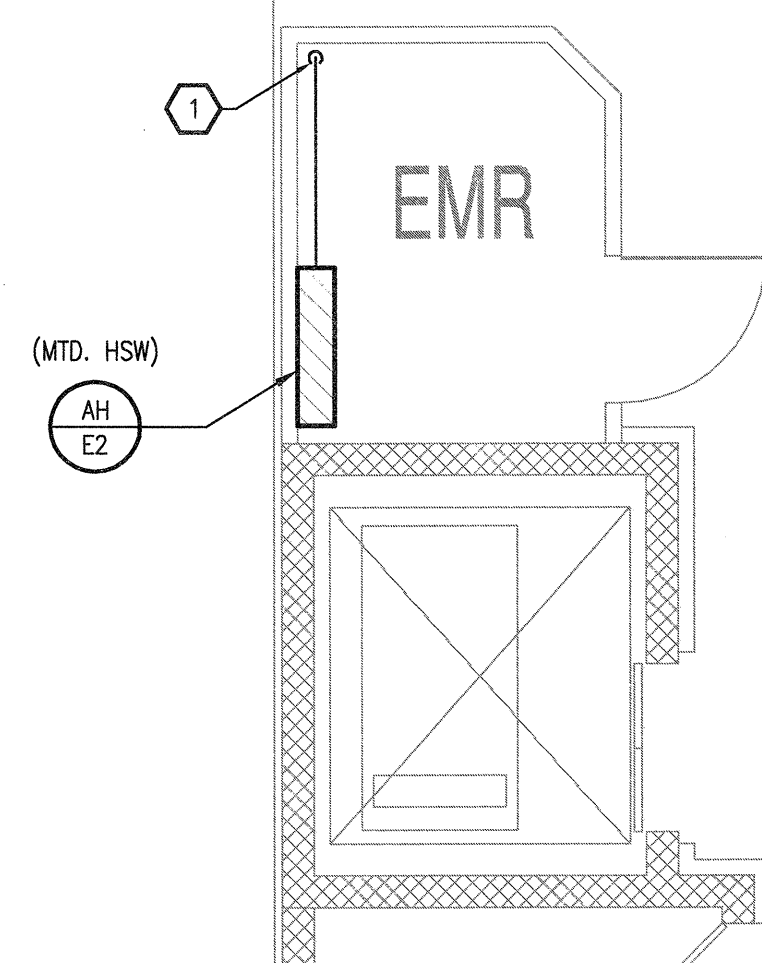


4 ELEVATOR MECHANICAL ROOM
SCALE: 1/4" = 1'-0"

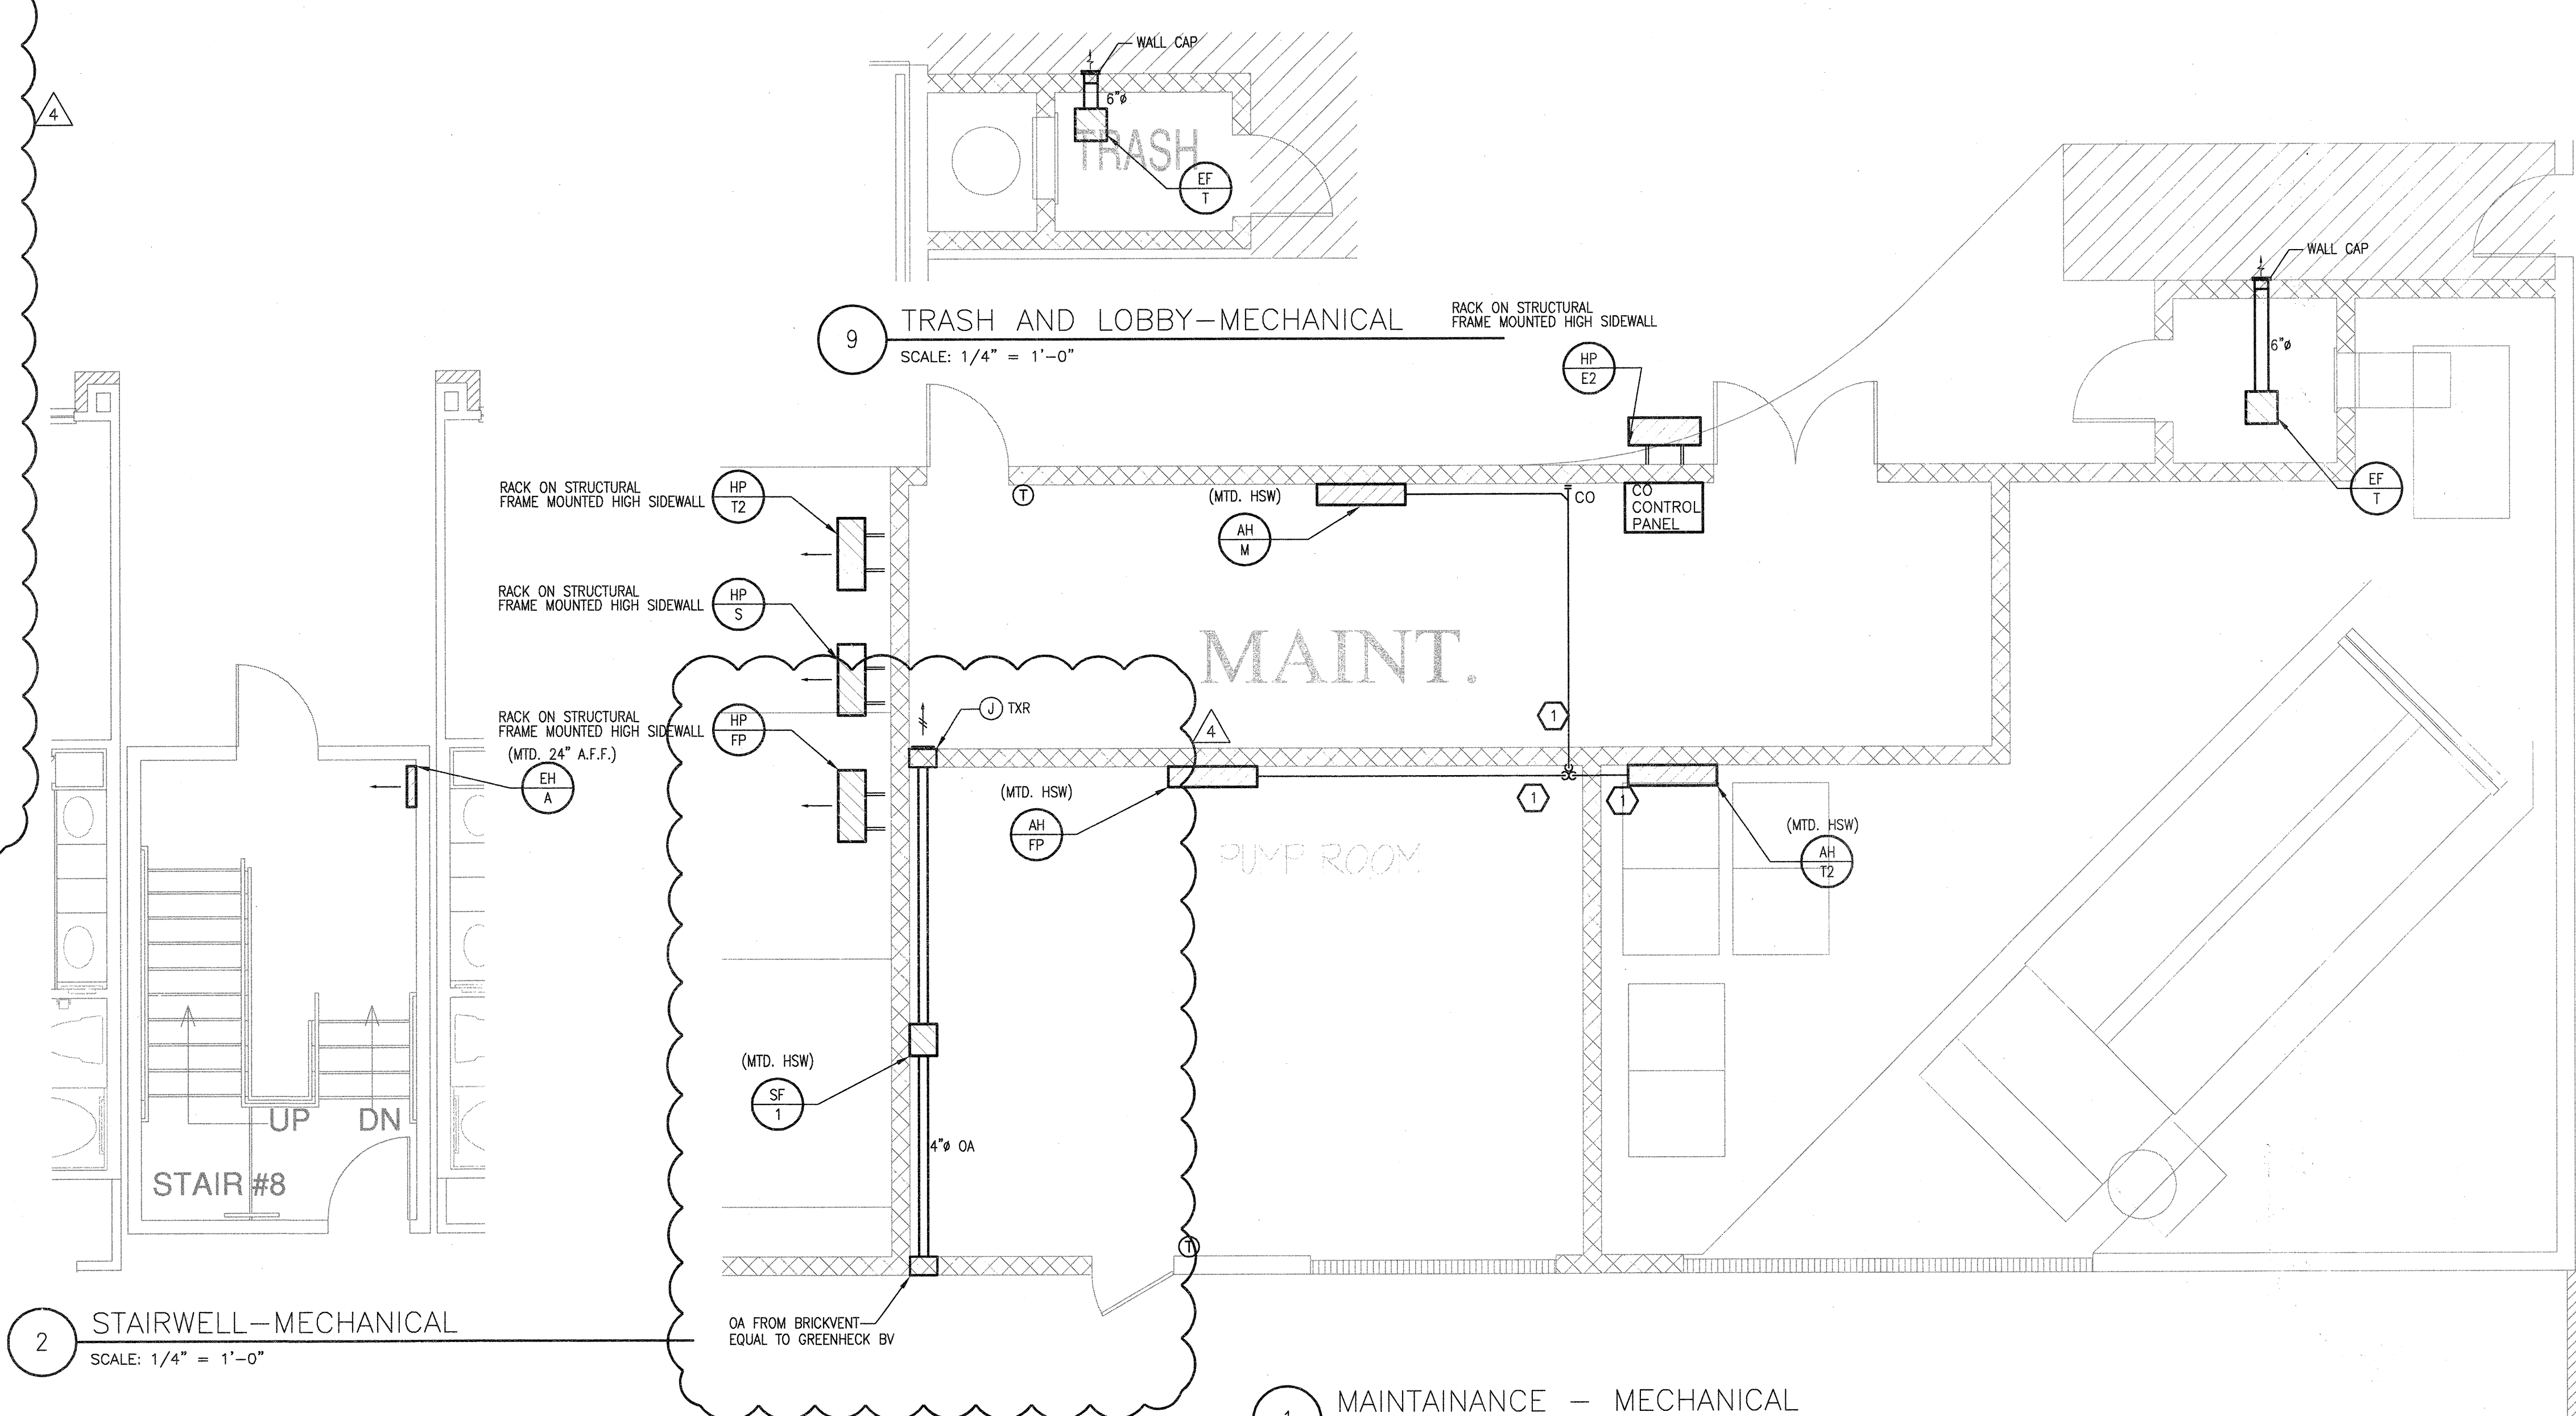


2 STAIRWELL-MECHANICAL
SCALE: 1/4" = 1'-0"

9 TRASH AND LOBBY-MECHANICAL
SCALE: 1/4" = 1'-0"


1 MAINTENANCE - MECHANICAL
SCALE: 1/4" = 1'-0"

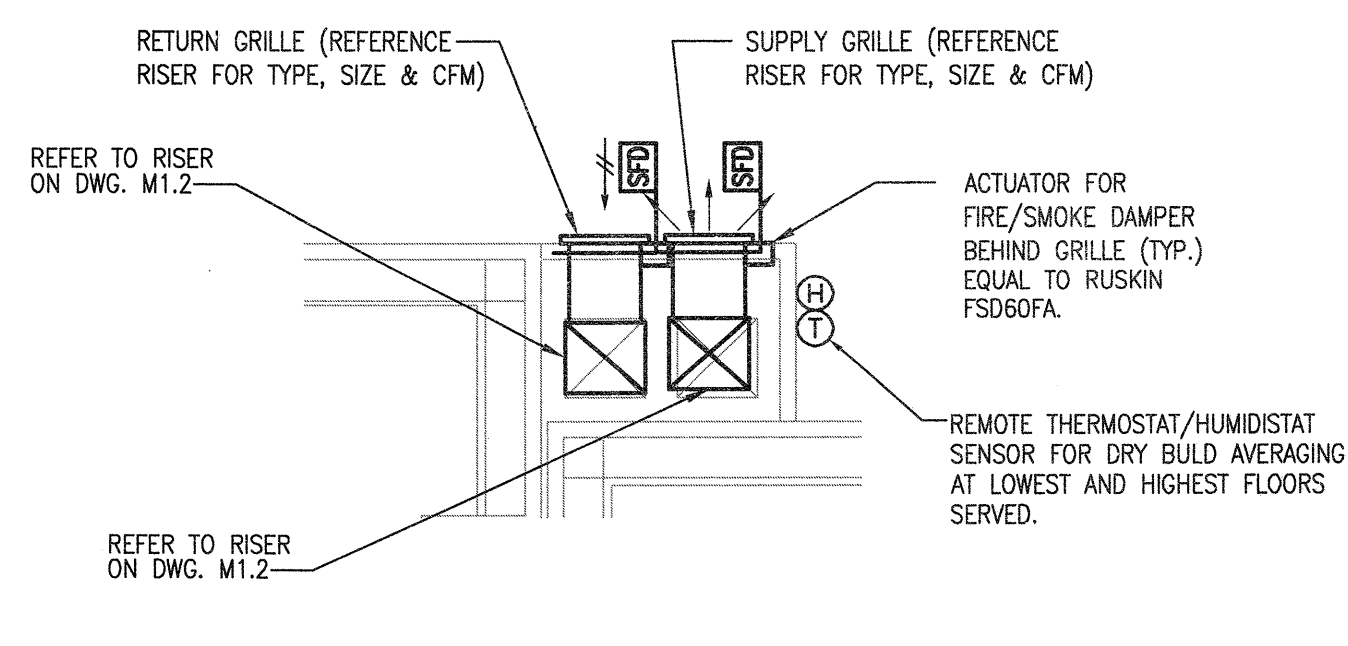


8 CORRIDOR PRESSURIZATION -MECHANICAL
SCALE: 1/4" = 1'-0"

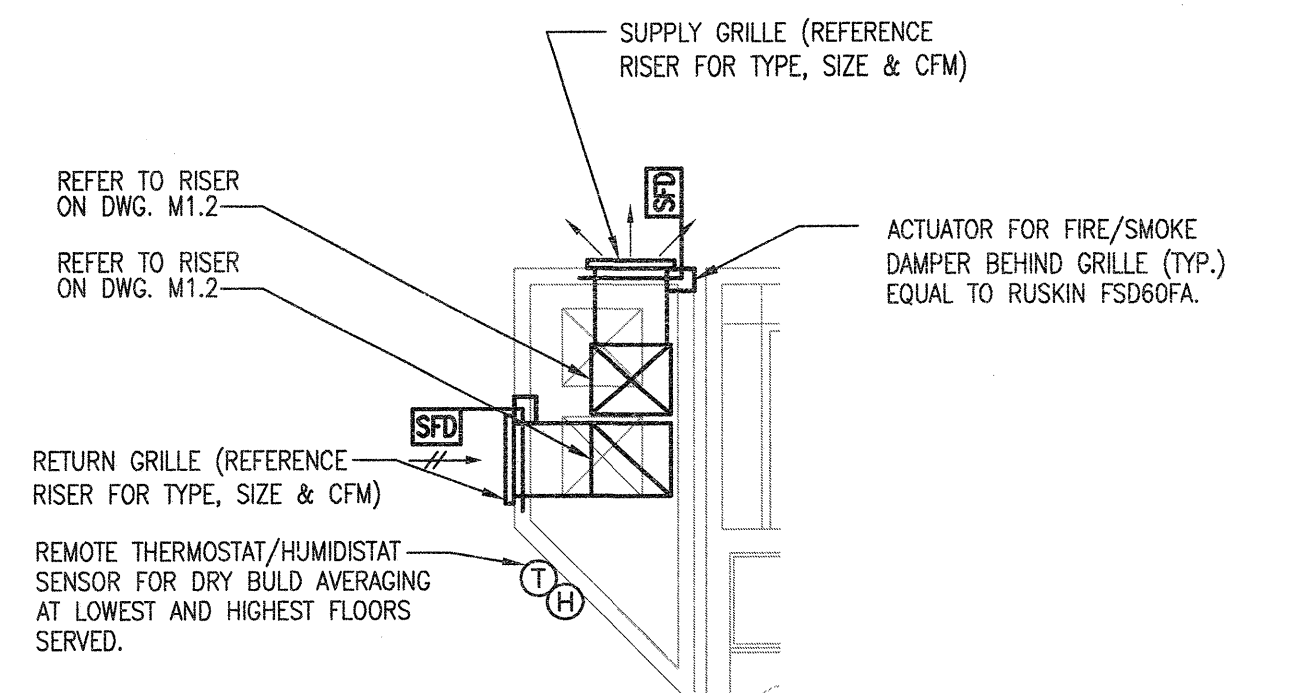

7 CORRIDOR PRESSURIZATION -MECHANICAL
SCALE: 1/4" = 1'-0"

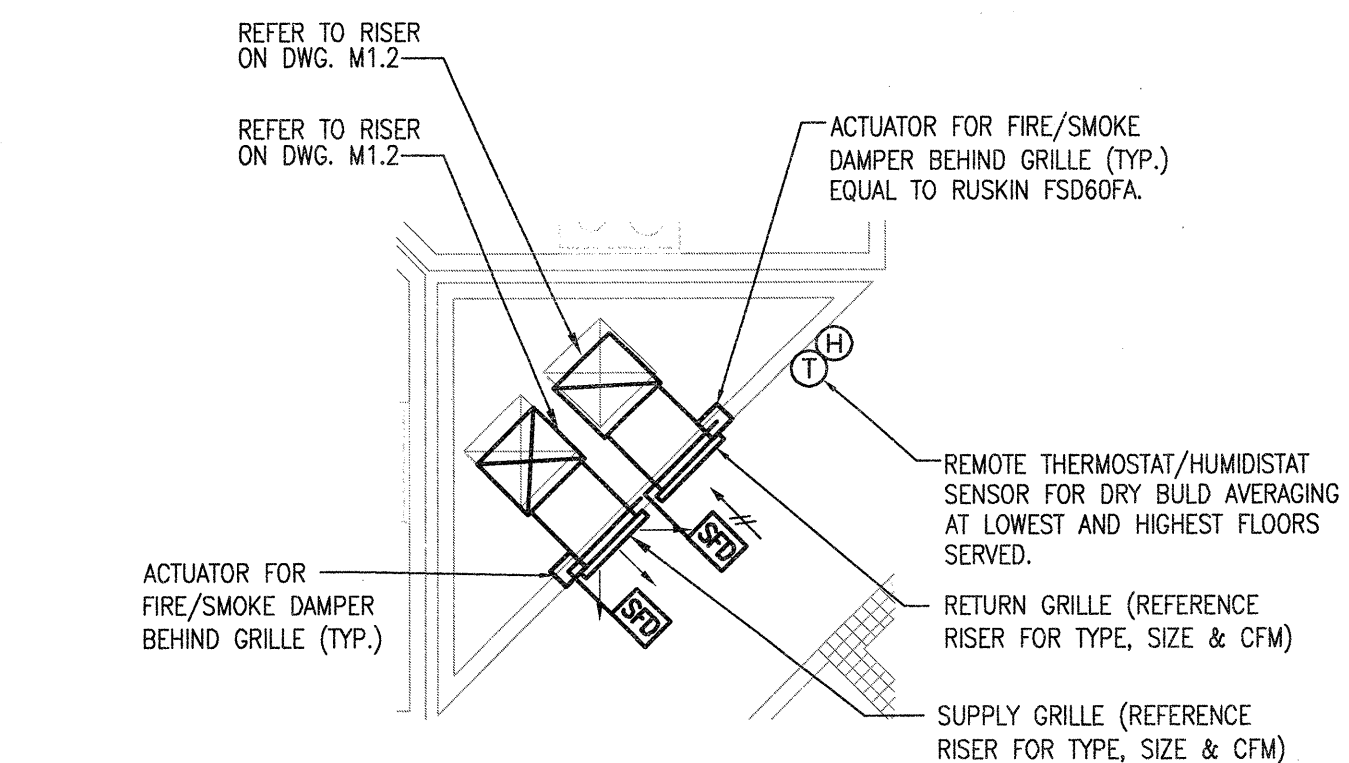

6 CORRIDOR PRESSURIZATION -MECHANICAL
SCALE: 1/4" = 1'-0"

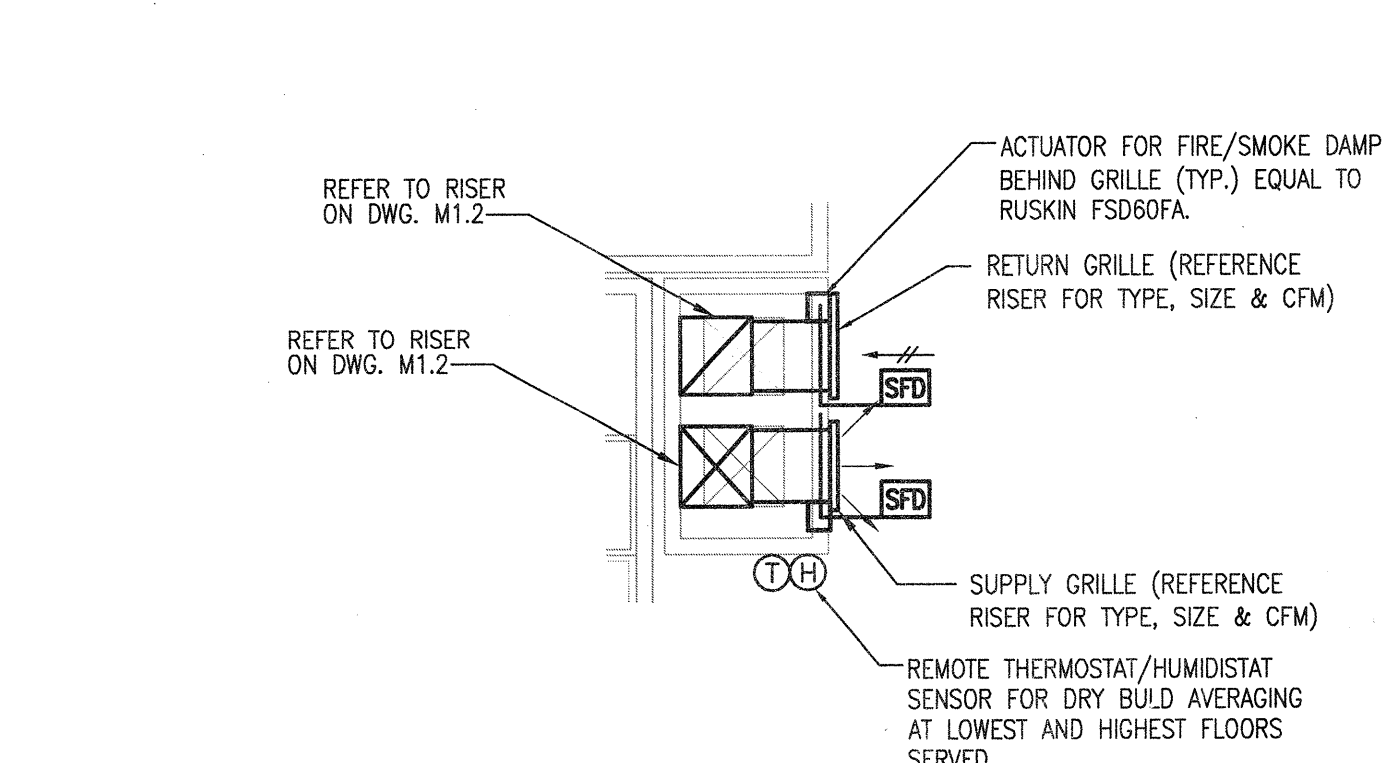

5 CORRIDOR PRESSURIZATION -MECHANICAL
SCALE: 1/4" = 1'-0"

USE Jordan & Skala Engineers
14240 Midway Road, Suite 330
Dallas, TX 75244-5138
Project Number - 113-0355
Drawn By: CJH
Texas Firm Registration # F-4990
Checked By: AHS

BGO architects
4144 N. Central Expy.
Suite 855
Dallas, TX 75204
214.520.8878
bgoarchitects.com

DATE
08-05-11

PROJECT
11129

SHEET NUMBER

M-4.2
PART
PLANS
MECHANICAL