

CAUTION!!
 EXIST. GAS MAIN IN AREA
 CONTACT TEXAS ONE CALL
 1-800-245-4545
 48 HOURS PRIOR TO
 CONSTRUCTION

PROPOSED POWER POLE (TYPICAL)
 (REFER TO ELECTRICAL PLANS BY OTHERS)

VERIFY LOCATION OF EXISTING GAS MAIN PRIOR TO PLACING POWER POLES

PROPOSED BOLLARDS (TYPICAL)
 (REFER TO ELECTRICAL PLANS BY OTHERS)

PROPOSED SINGLE PHASE TRANSFORMER (TYPICAL)
 (REFER TO ELECTRICAL PLANS BY OTHERS)

KELLER SPRINGS ROAD

EXISTING POWER POLE TO BE RELOCATED
 EXISTING POWER POLE TO BE REMOVED

PROPOSED POWER POLE (TYPICAL)
 (REFER TO ELECTRICAL PLANS BY OTHERS)

EXISTING UNDERGROUND ELECTRICAL TO BE ABANDONED

Handwritten notes:
 11/19/11
 MT = 2'-4"
 TWC = 2'-4"
 2'-4"

POWER POLE COORDINATES:

POLE#	NORTHING	EASTING
P1	5231.4687	5137.3653
P2	5230.7169	5299.7169
P3	5230.8269	5411.0117
P4	5230.9763	5485.1045
P5	5226.2535	5563.8478
P6	5125.3917	5555.7196
P7	5085.3118	5555.3903
P8	5042.4552	5555.1847
P11	4989.3960	4778.1064
P12	5029.7737	4778.1064
P13	5073.3003	4776.1447
P14	5132.3670	4771.4433

SECONDARY CONDUIT SCHEDULE

CONDUIT	TYPE	SIZE	LENGTH	NOTES
510LF	M&B	L3	SETS	1" PVC W/ (4) 400 AL EA
300LF	M&B	L3	SETS	1" PVC W/ (4) 400 AL EA
520LF	M&B	L3	SETS	1" PVC W/ (4) 500 AL EA
370LF	M&B	L3	SETS	1" PVC W/ (4) 400 AL EA
270LF	M&B	L3	SETS	1" PVC W/ (4) 400 AL EA
285LF	M&B	L3	SETS	1" PVC W/ (4) 400 AL EA
440LF	M&B	L3	SETS	1" PVC W/ (4) 400 AL EA
700	M&B	L3	SETS	1" PVC W/ (4) 400 AL EA
260	FEED PUMP	L3	SETS	1" PVC W/ (4) 300 AL EA

CONDUIT FEEDER SCHEDULE

CONDUIT	TYPE	SIZE	LENGTH	NOTES
260	L-1	SET	3" PVC W/ (4) 300 AL EA	
520	L-2	SET	3" PVC W/ (4) 300 AL EA	
180	PE	SET	3" PVC W/ (4) 300 AL EA	
215	ELEV #1	SET	3" PVC W/ (4) 250 AL EA	
240	ELEV #2	SET	3" PVC W/ (4) 250 AL EA	

NOTE:
 THIS PLAN IS FOR INFORMATION ONLY. SEE ELECTRICAL SITE PLAN PROVIDED BY JORDAN & SKALA AND SCHEMATIC DESIGN PROVIDED BY ONCOR FOR ELECTRICAL DESIGN INCLUDING PRIMARIES AND METER BANK LOCATIONS.

BENCH MARKS:


BMS
 SQUARE CUT ON INLET, SOUTHWEST CORNER OF RATLIFF LANE AND ADDISON ROAD.
 ELEVATION 637.20

BMB
 SQUARE CUT ON INLET, SOUTHWEST CORNER OF AIRPORT PKWY. AND QUORUM DRIVE.
 ELEVATION 631.15

BM1
 BRASS DISK FOUND AT NORTHWEST CORNER OF INLET, SOUTHWEST CORNER OF KELLER SPRINGS AND ADDISON ROAD.
 ELEVATION 638.91

Kimley-Horn and Associates, Inc.
 1000 West Loop South, Suite 200
 Dallas, TX 75240-2000
 Phone: 214-241-2000
 Fax: 214-241-2001

Revision: 1
 REVISION TRANSFORMERS AND POWER POLE LAYOUTS
 Date: 9/19/11

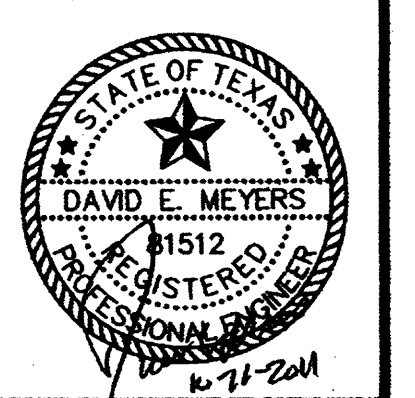

**Keller Springs Lofts
 Loft Apartments in Addison**
 Town of Addison, Texas

ELECTRICAL SITE PLAN

DATE: OCTOBER 11, 2011
 DESIGN: KHA
 DRAWN: KHA
 CHECKED: KHA
 KHA NO.: 084362003
 CITY NO.: