


10/27/11	ADDED 8" CONCRETE, REVISED DRIVEWAY AND ADDED BARRIER FREE RAMP
2/6/12	REVISED PARALLEL PARKING AND SIDEWALK
3/27/13	ADDED PARKING AND RETAINING WALL
4/18/13	REVISED PARKING
5/29/13	REVISED PARKING

Kimley-Horn and Associates, Inc.	
2700 Ross Street, Suite 200 Dallas, TX 75201-9518 Phone: 972-770-8000 Fax: 972-770-8000	Project No. 084362003
Revision	Date
1 REVISED DRIVE APPROACH SPEC	8/26/11
2 ADDED SIDEWALK REFERENCE	9/14/11
3 AND REVISED FIRE LANE	

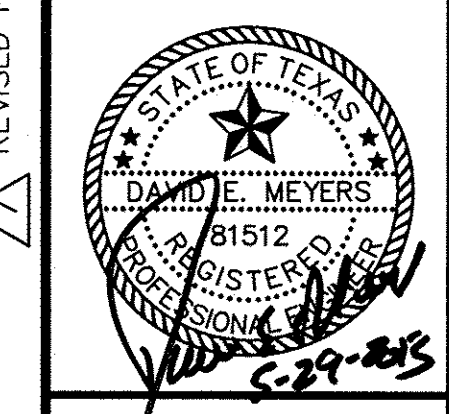

Keller Springs Lofts Loft Apartments in Addison

Town of Addison, Texas

PAVING PLAN

DATE: FEBRUARY 28, 2013
DESIGN: KHA
DRAWN: KHA
CHECKED: KHA
KHA NO.: 084362003
CITY NO.:

SHEET
C4a