
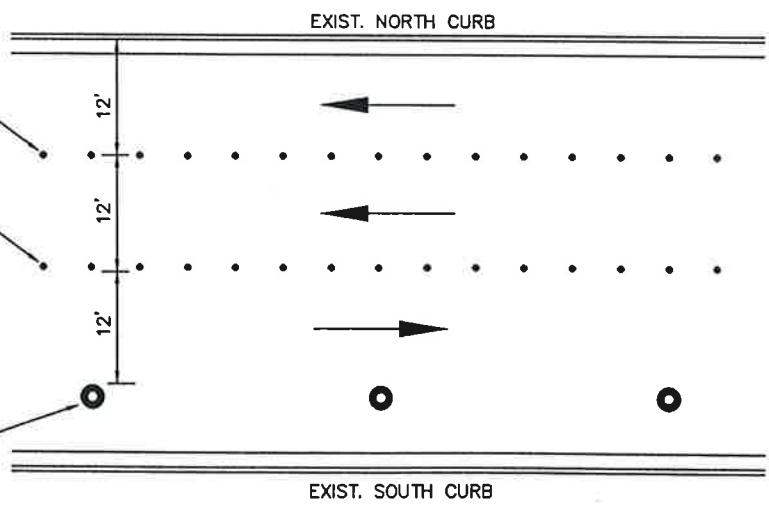


**NOTES :**

1. REMOVE EXISTING PAVEMENT MARKINGS PRIOR TO INSTALLING TEMPORARY PAVEMENT MARKINGS (TABS).
2. PLASTIC DRUMS ARE TO HAVE TxDOT TYPE A WARNING LIGHTS ATTACHED TO EACH DRUM.
3. CONTRACTOR SHALL MAINTAIN SIGNS, DRUMS AND MARKINGS THROUGHOUT THE DURATION OF CONSTRUCTION.

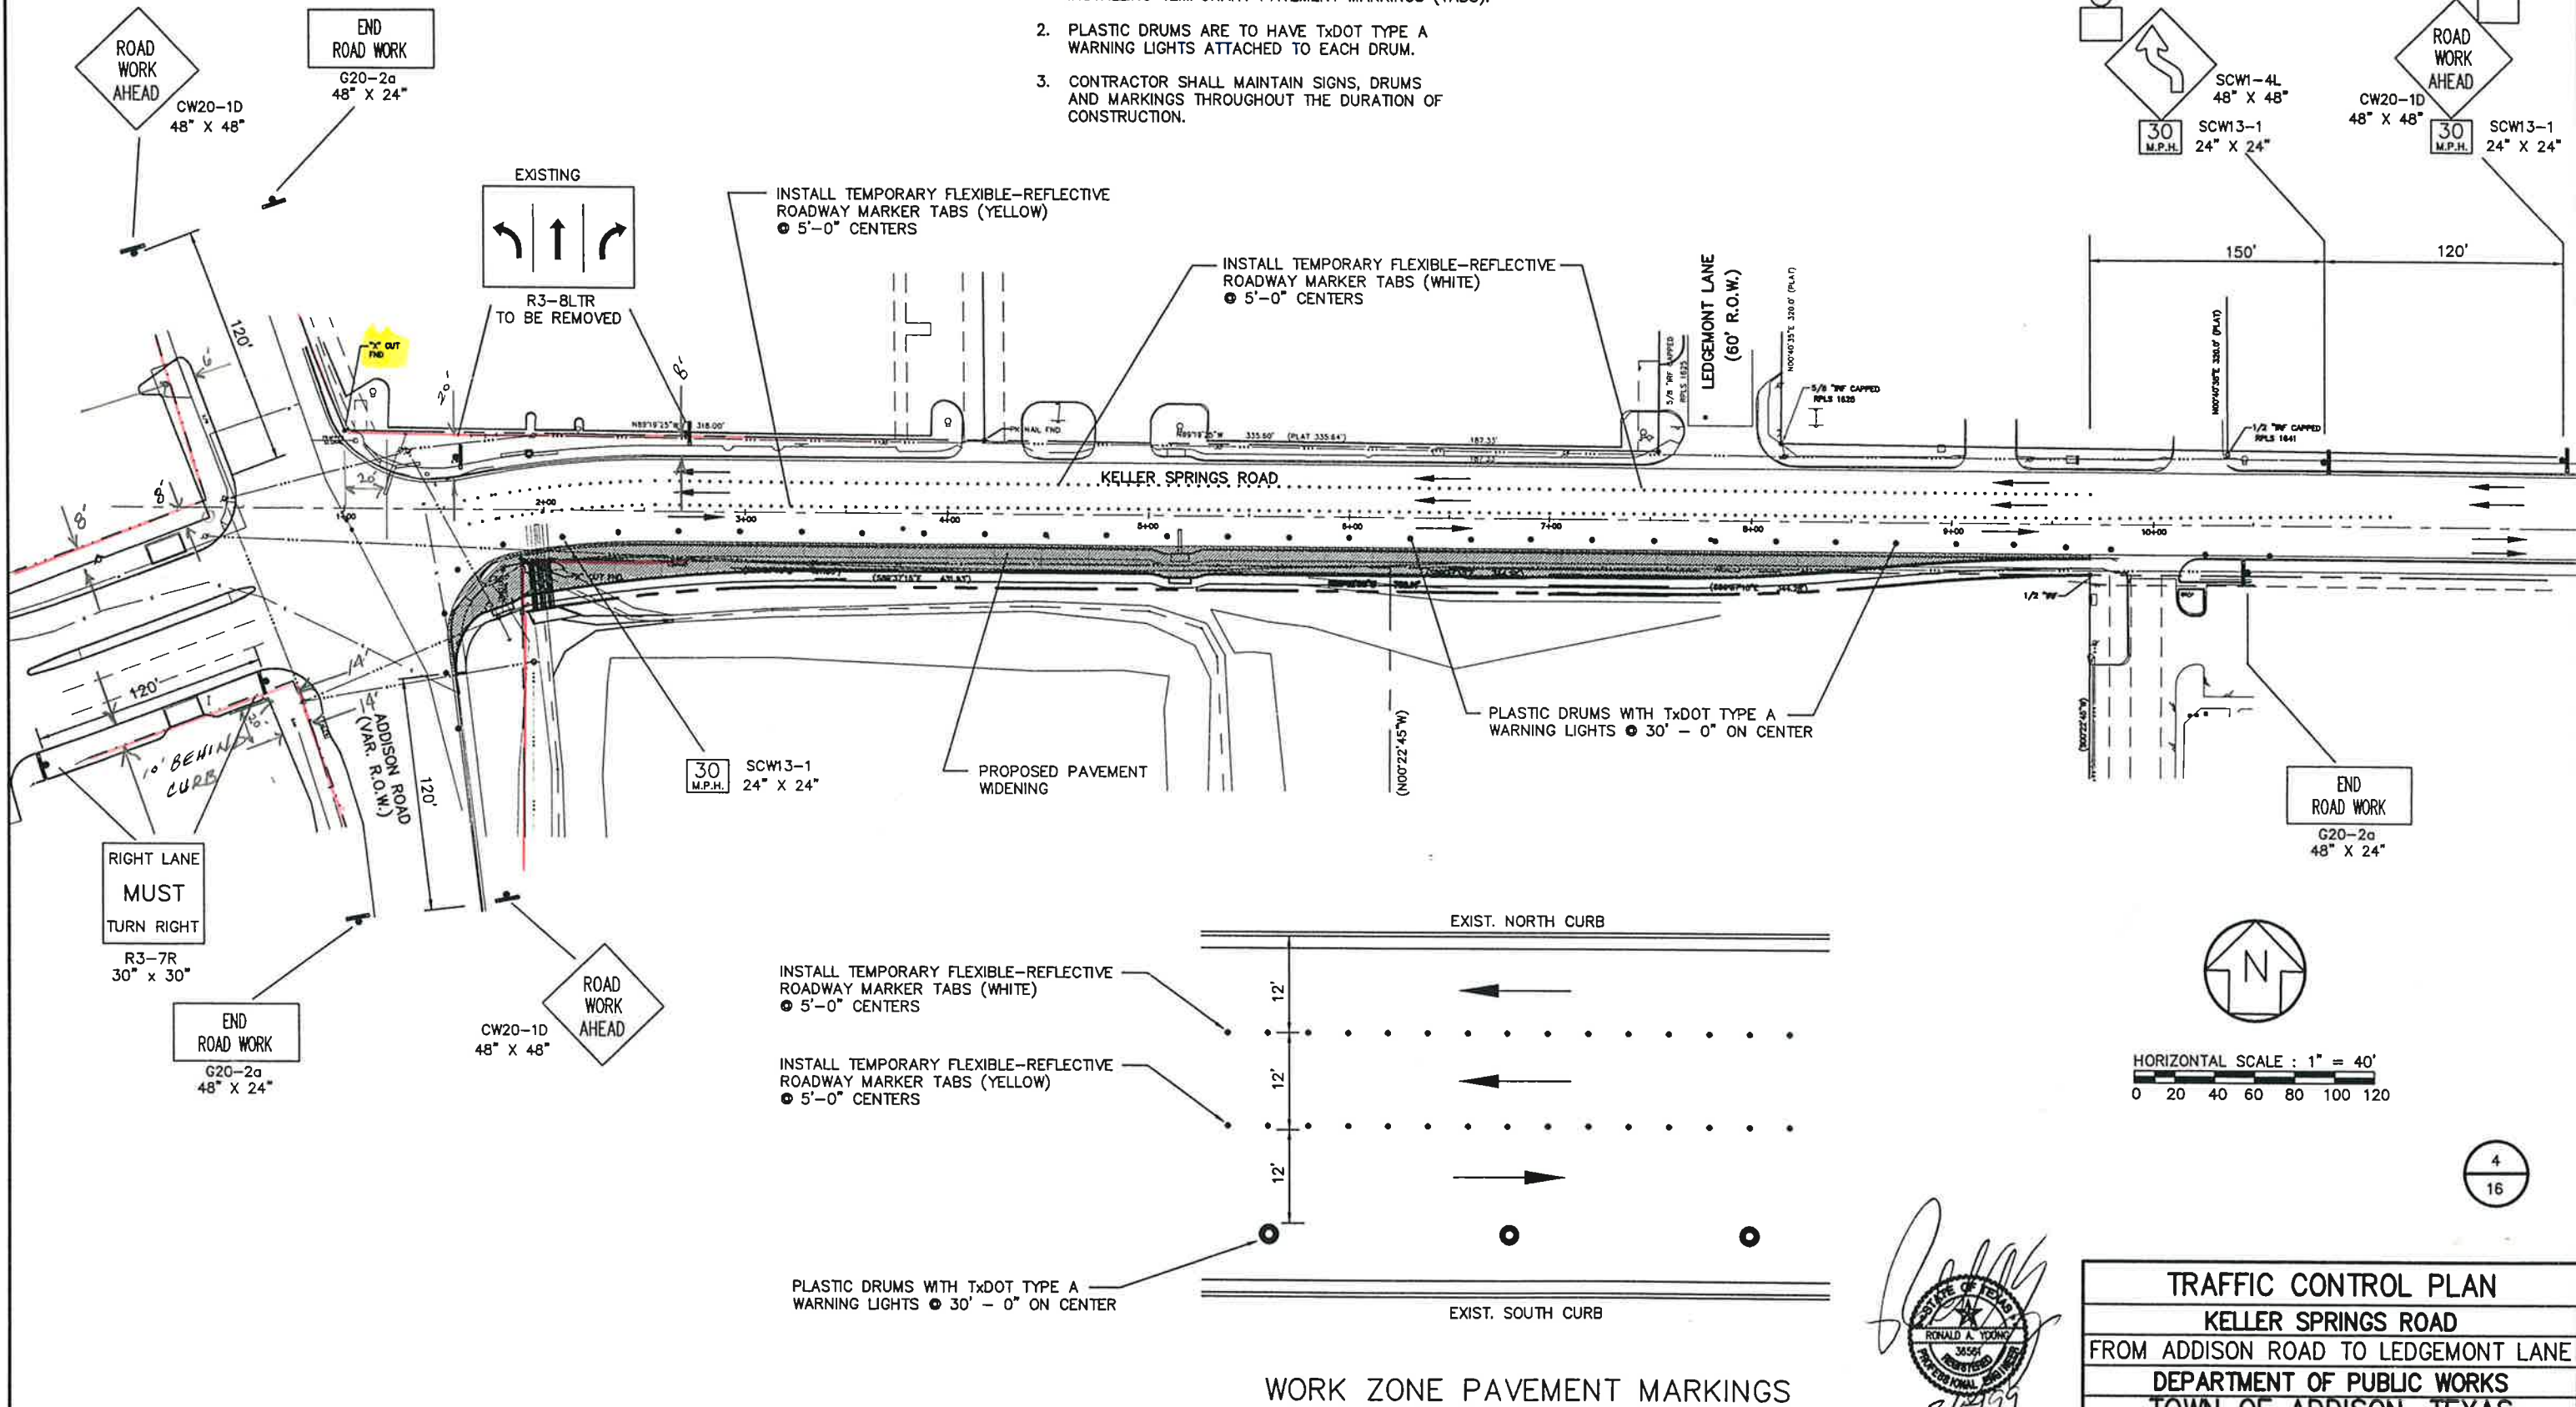

REV. 1 - REM. R3-BLTR  
3/5/99

TRAFFIC CONTROL PLAN						
KELLER SPRINGS ROAD						
FROM ADDISON ROAD TO LEDGEMONT LANE						
DEPARTMENT OF PUBLIC WORKS						
TOWN OF ADDISON, TEXAS						
DESIGN	DRAWN	DATE	SCALE	NOTES	FILE	NUMBER
PTG	PTG	5-98	1"=40' H			