


SCALE 1" = 60'

SAN. SEWER CURVE DATA	
C1	Δ = 31°02'52" R = 87.25' T = 24.24' L = 47.28'
C2	Δ = 06°51'00" R = 2174.33' T = 30.73' L = 260.55'
C3	Δ = 08°17'00" R = 2404.33' T = 174.10' L = 347.59'

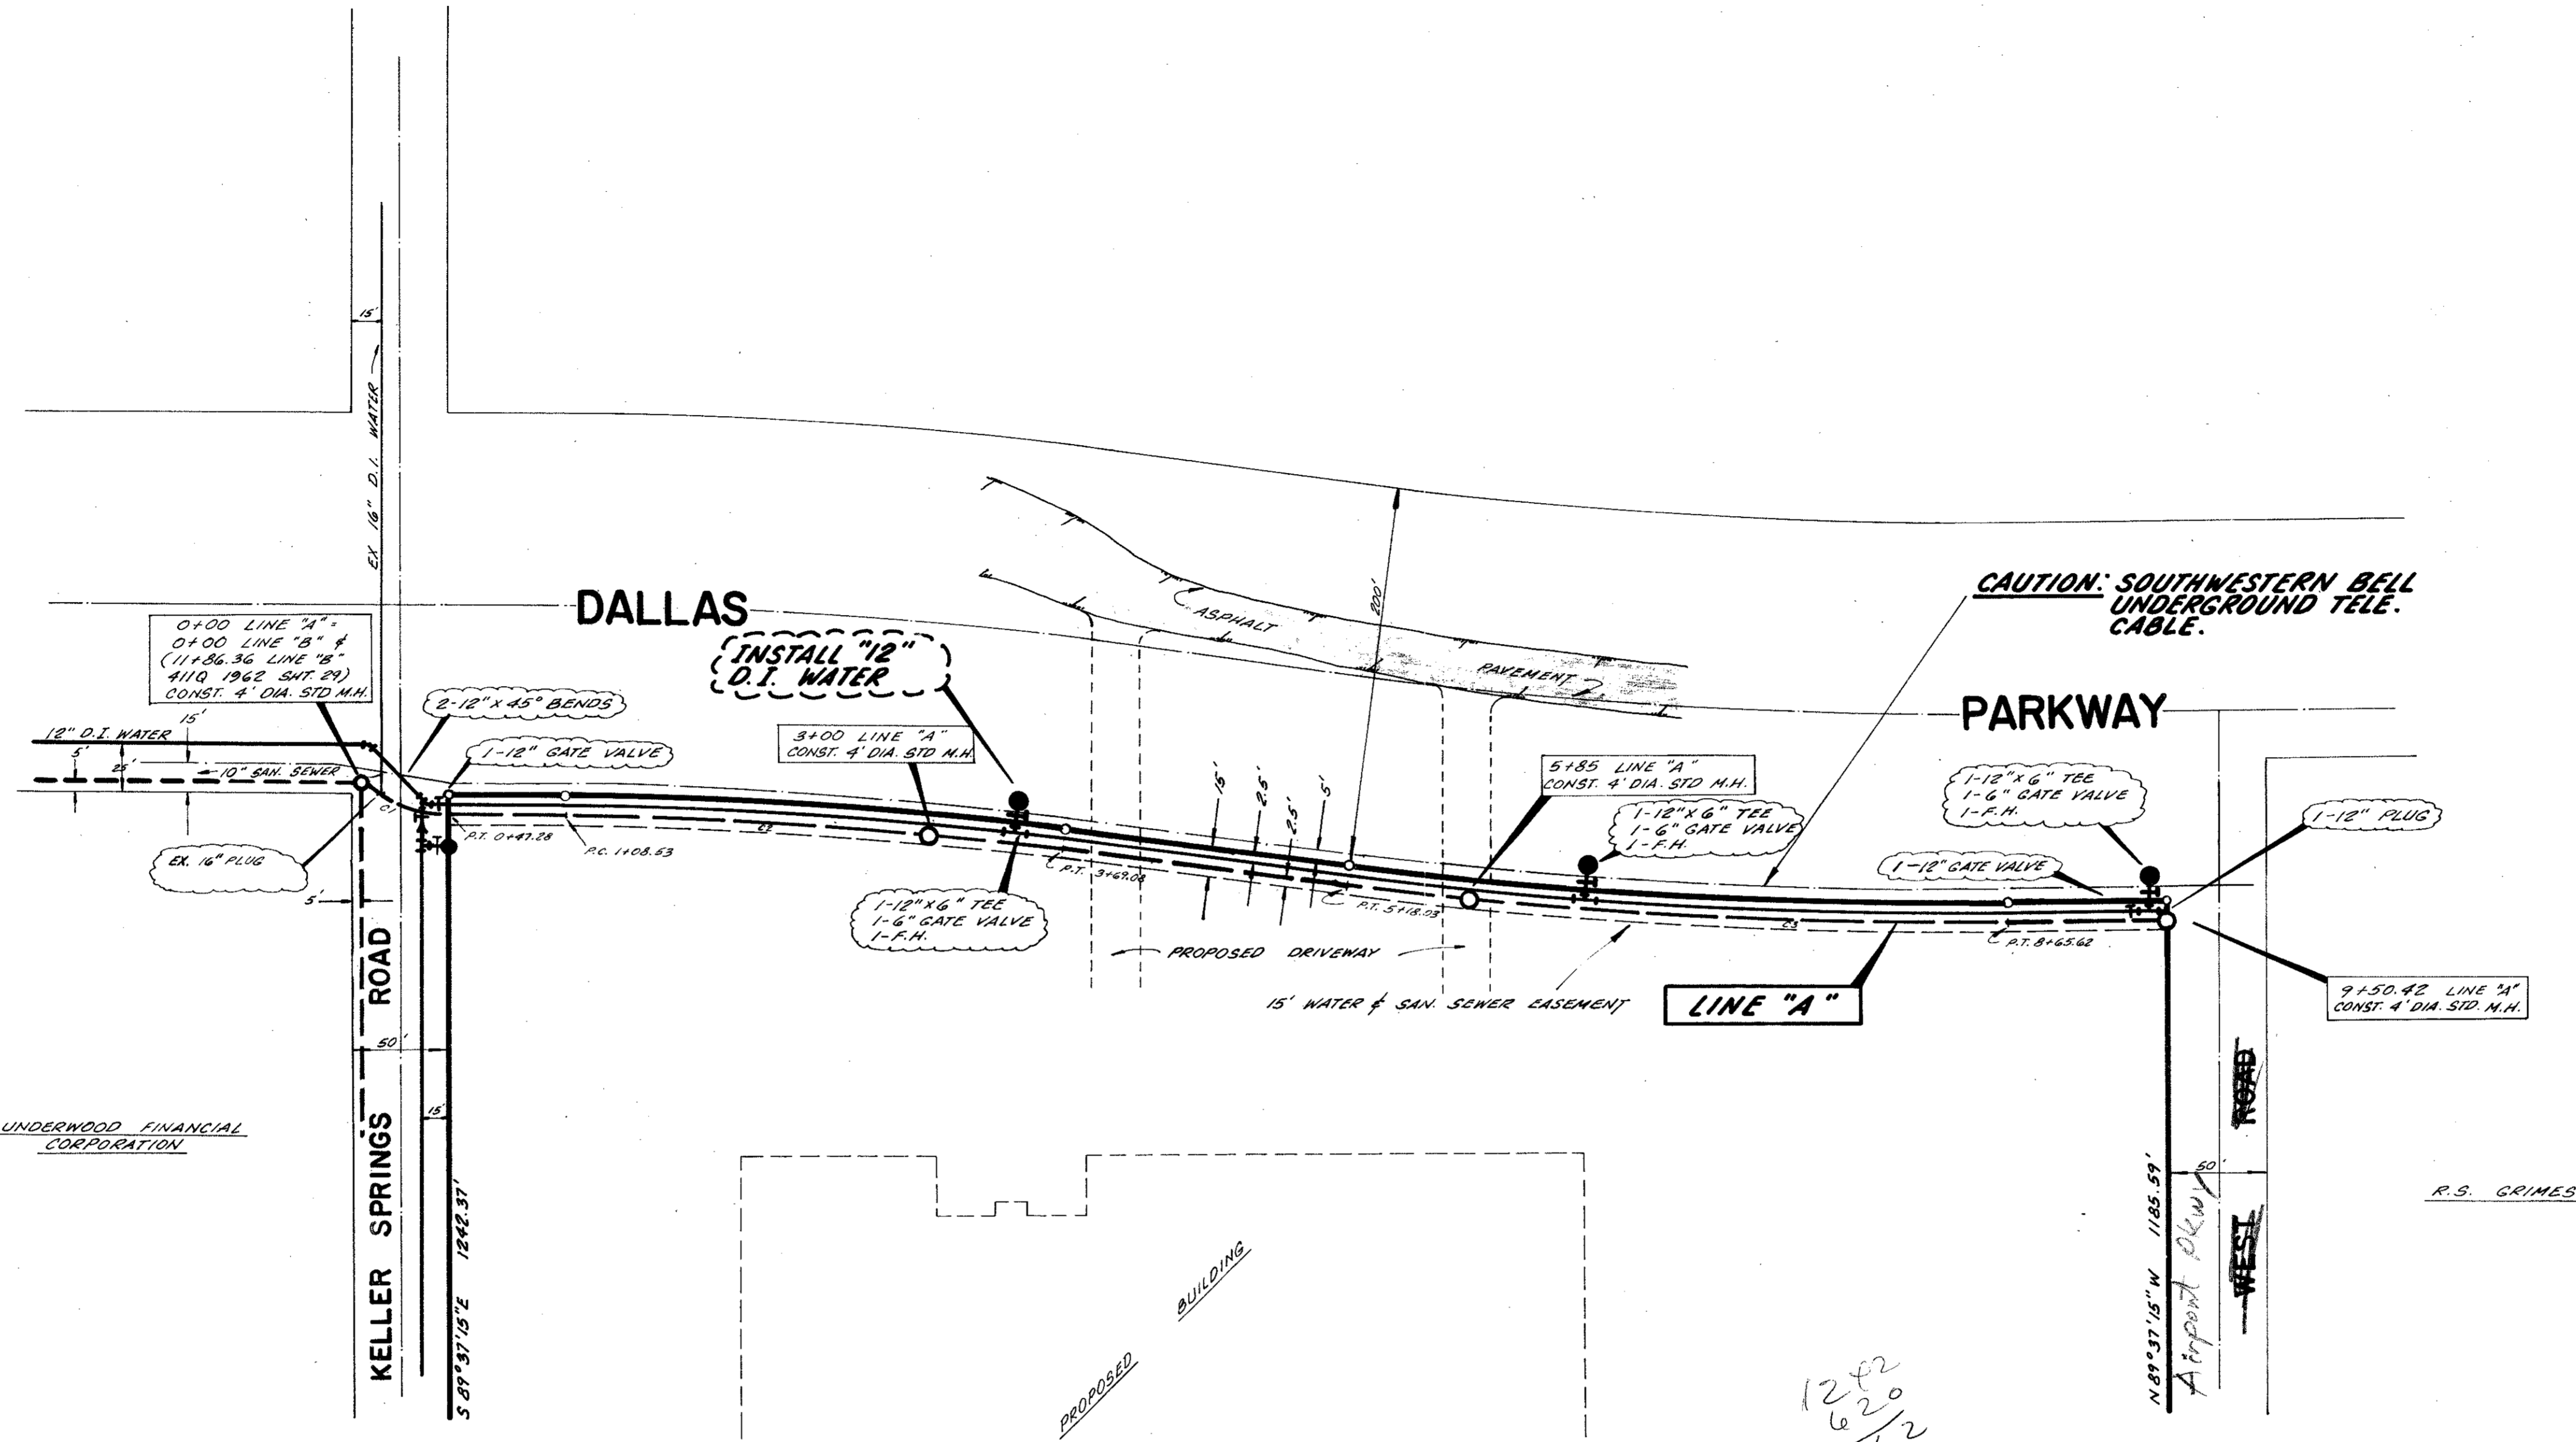


UNDERWOOD FINANCIAL CORPORATION

R.S. GRIMES

BENCH MARK: 60d NAIL IN POWER POLE, NORTH SIDE KELLER SPRINGS ROAD, AND 150' MORE OR LESS EAST OF THE CENTER LINE INTERSECTION OF DALLAS PARKWAY ELEV. 618.92

12/2
620
1862

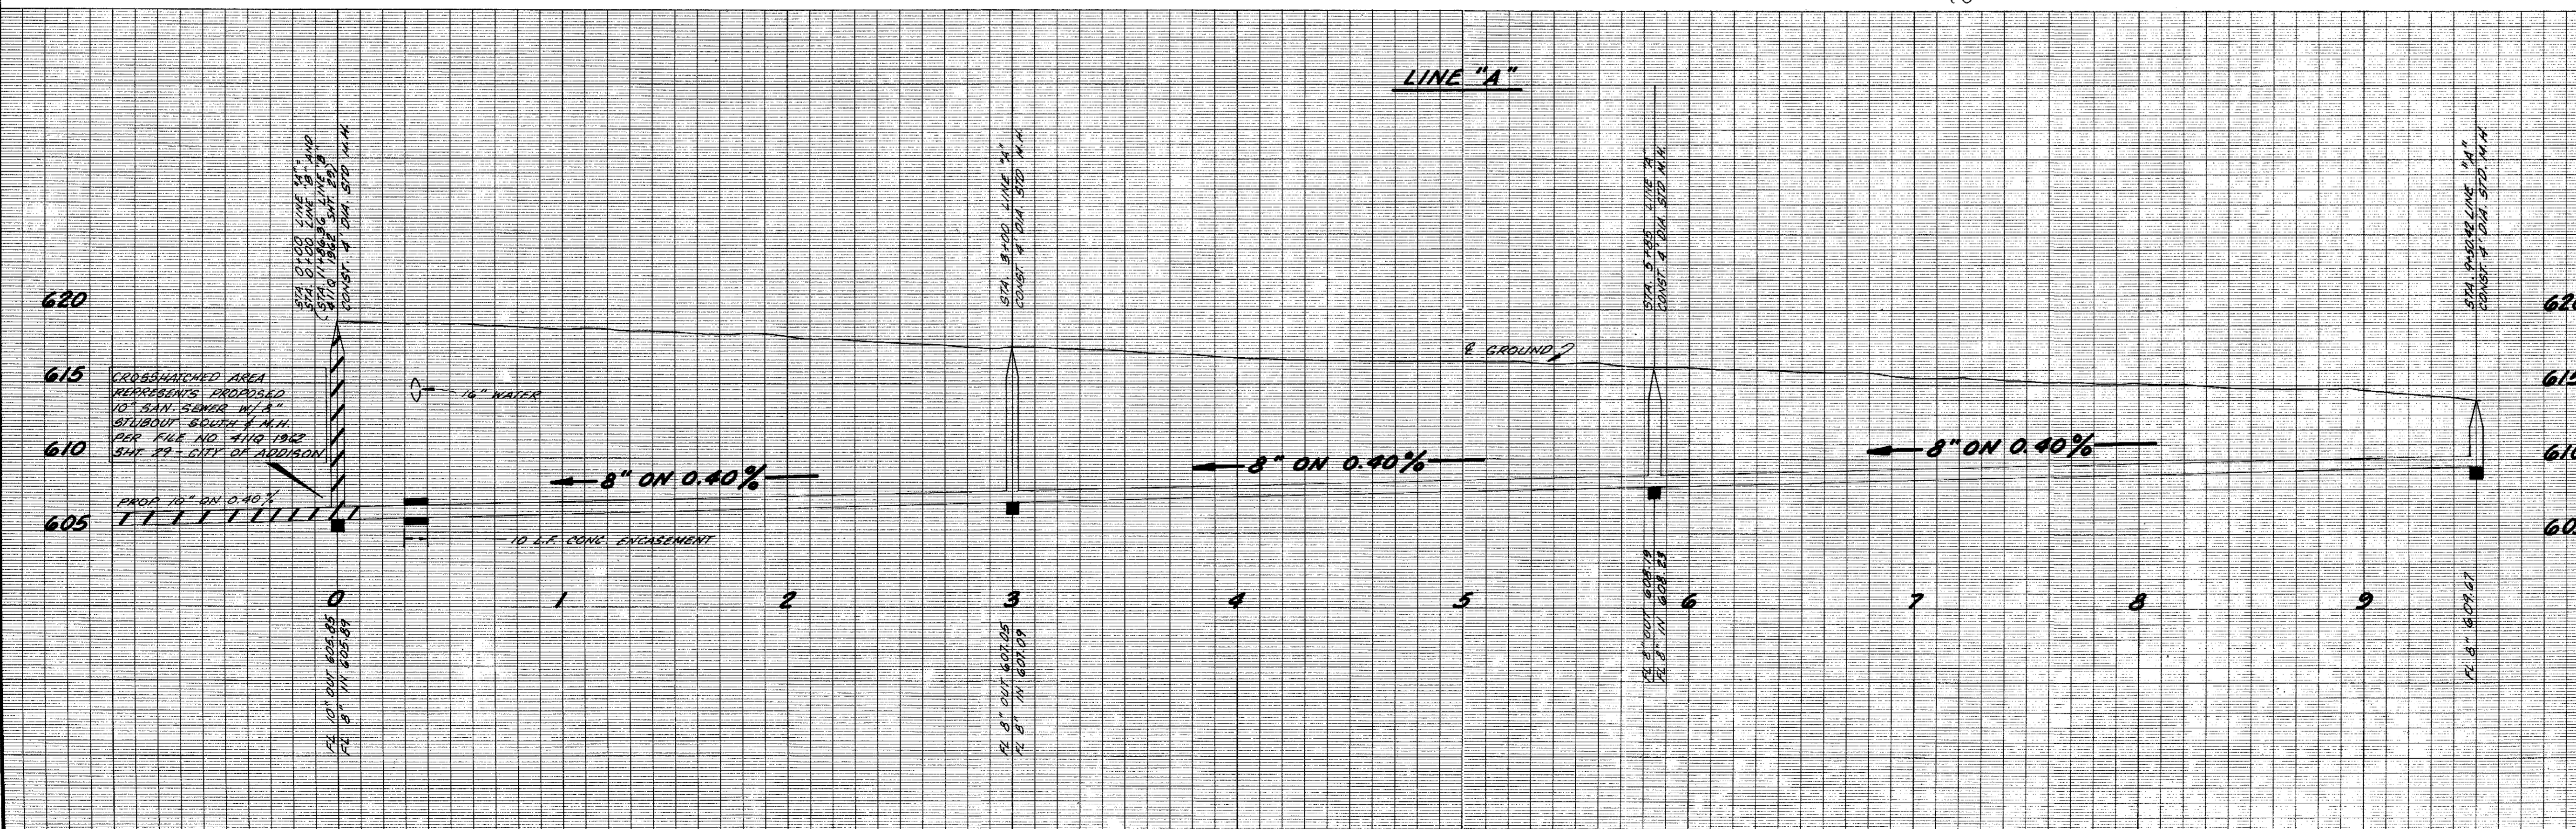

WATER & SAN. SEWER PLANS
HARRIS ADDITION
S.W. CORNER KELLER SPRINGS & DALLAS PKWY.
ADDISON WATER UTILITIES
CITY OF ADDISON, TEXAS

DESIGN	DRAWN	DATE	SCALE	NOTES	FILE	NO.
THREAGILL-DOWDY & ASSOCIATES		APR '97	1"=40' H 1"=6' V	T.F.D.		AL