
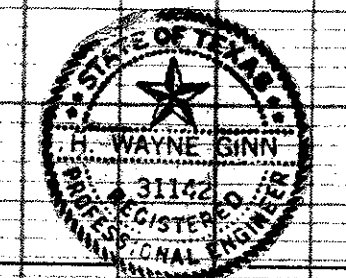


1-09-0003 ALL PLASTICS MOLDING
 1-09-0002 Charles W. Cullwell
 1-09-0001 John Mac, Joint Venture
 1-08-0003 Beltway Development Co.

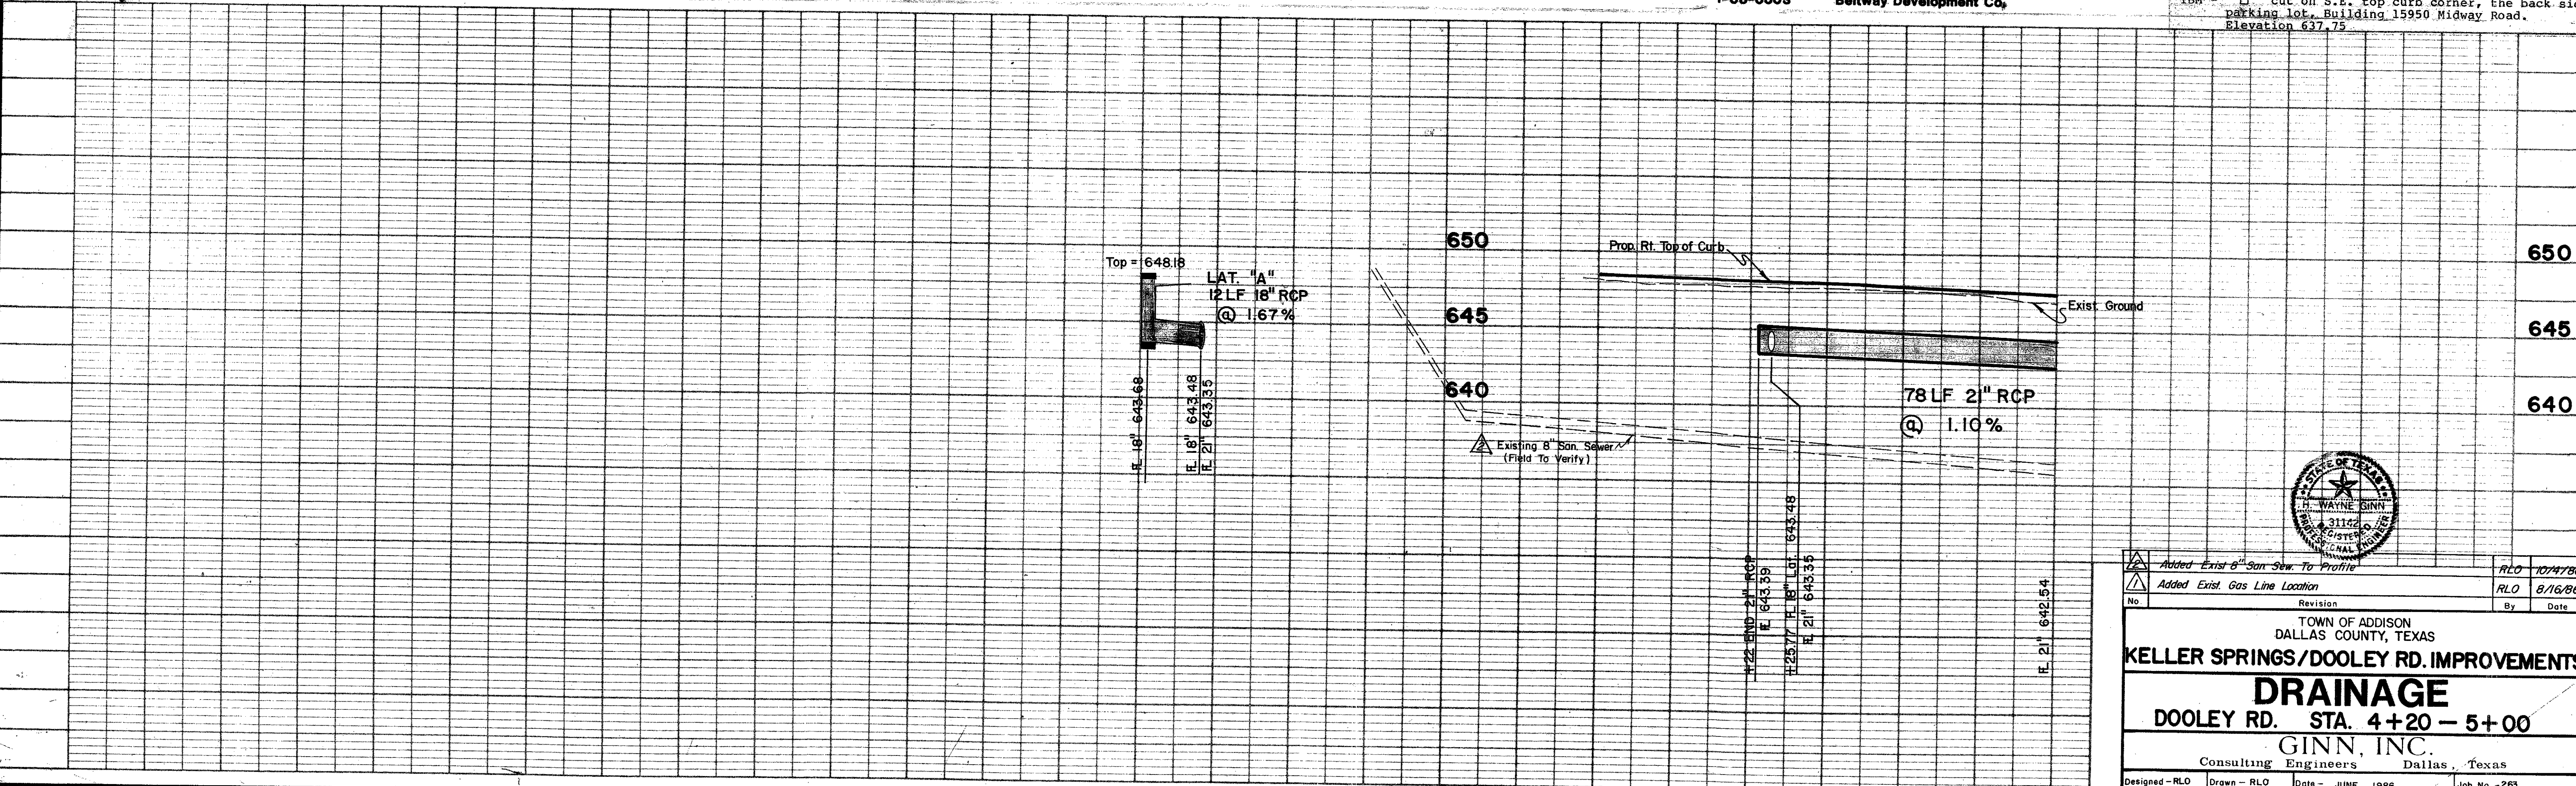

Added Exist 8" San Sew. To Profile		RLO	10/17/86
Added Exist. Gas Line Location		RLO	8/16/86
No.	Revision	By	Date
TOWN OF ADDISON DALLAS COUNTY, TEXAS			
KELLER SPRINGS/DOOLEY RD. IMPROVEMENTS			
DRAINAGE			
DOOLEY RD. STA. 4+20 - 5+00			
GINN, INC.			
Consulting Engineers Dallas, Texas			
Designed - RLO	Drawn - RLO	Date - JUNE, 1986	Job No. - 263
Approved - HWG	Checked - JCK	Scale - 1" = 20' H/1" = 5' V	Sheet 12 Of 30