



Midway Park North

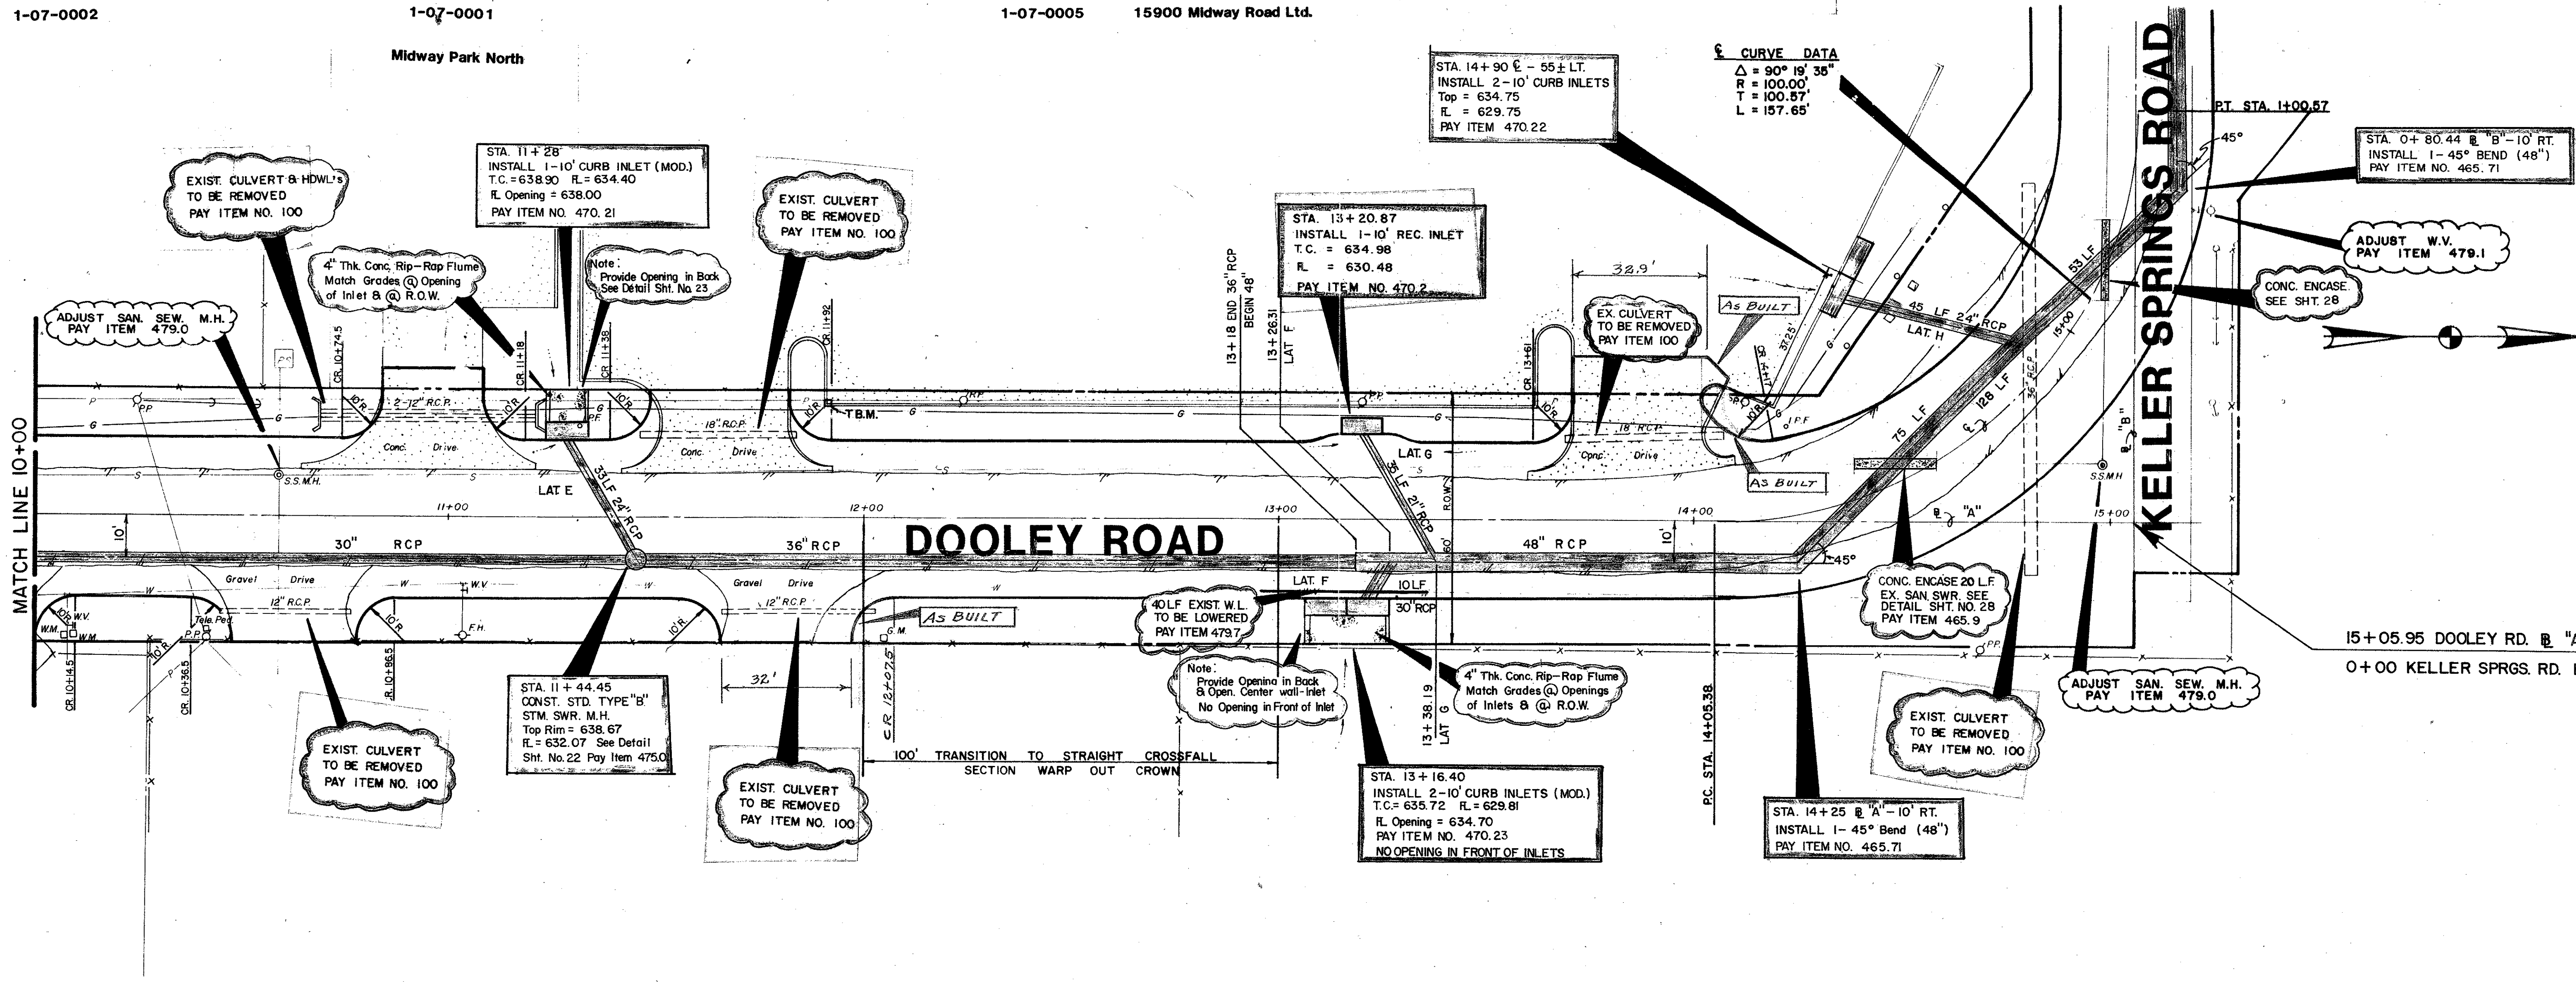

Addison Airport

TBM - "□" cut on S.E. top curb corner, the back side parking lot, Building 15900 Midway Road. Elevation 637.75

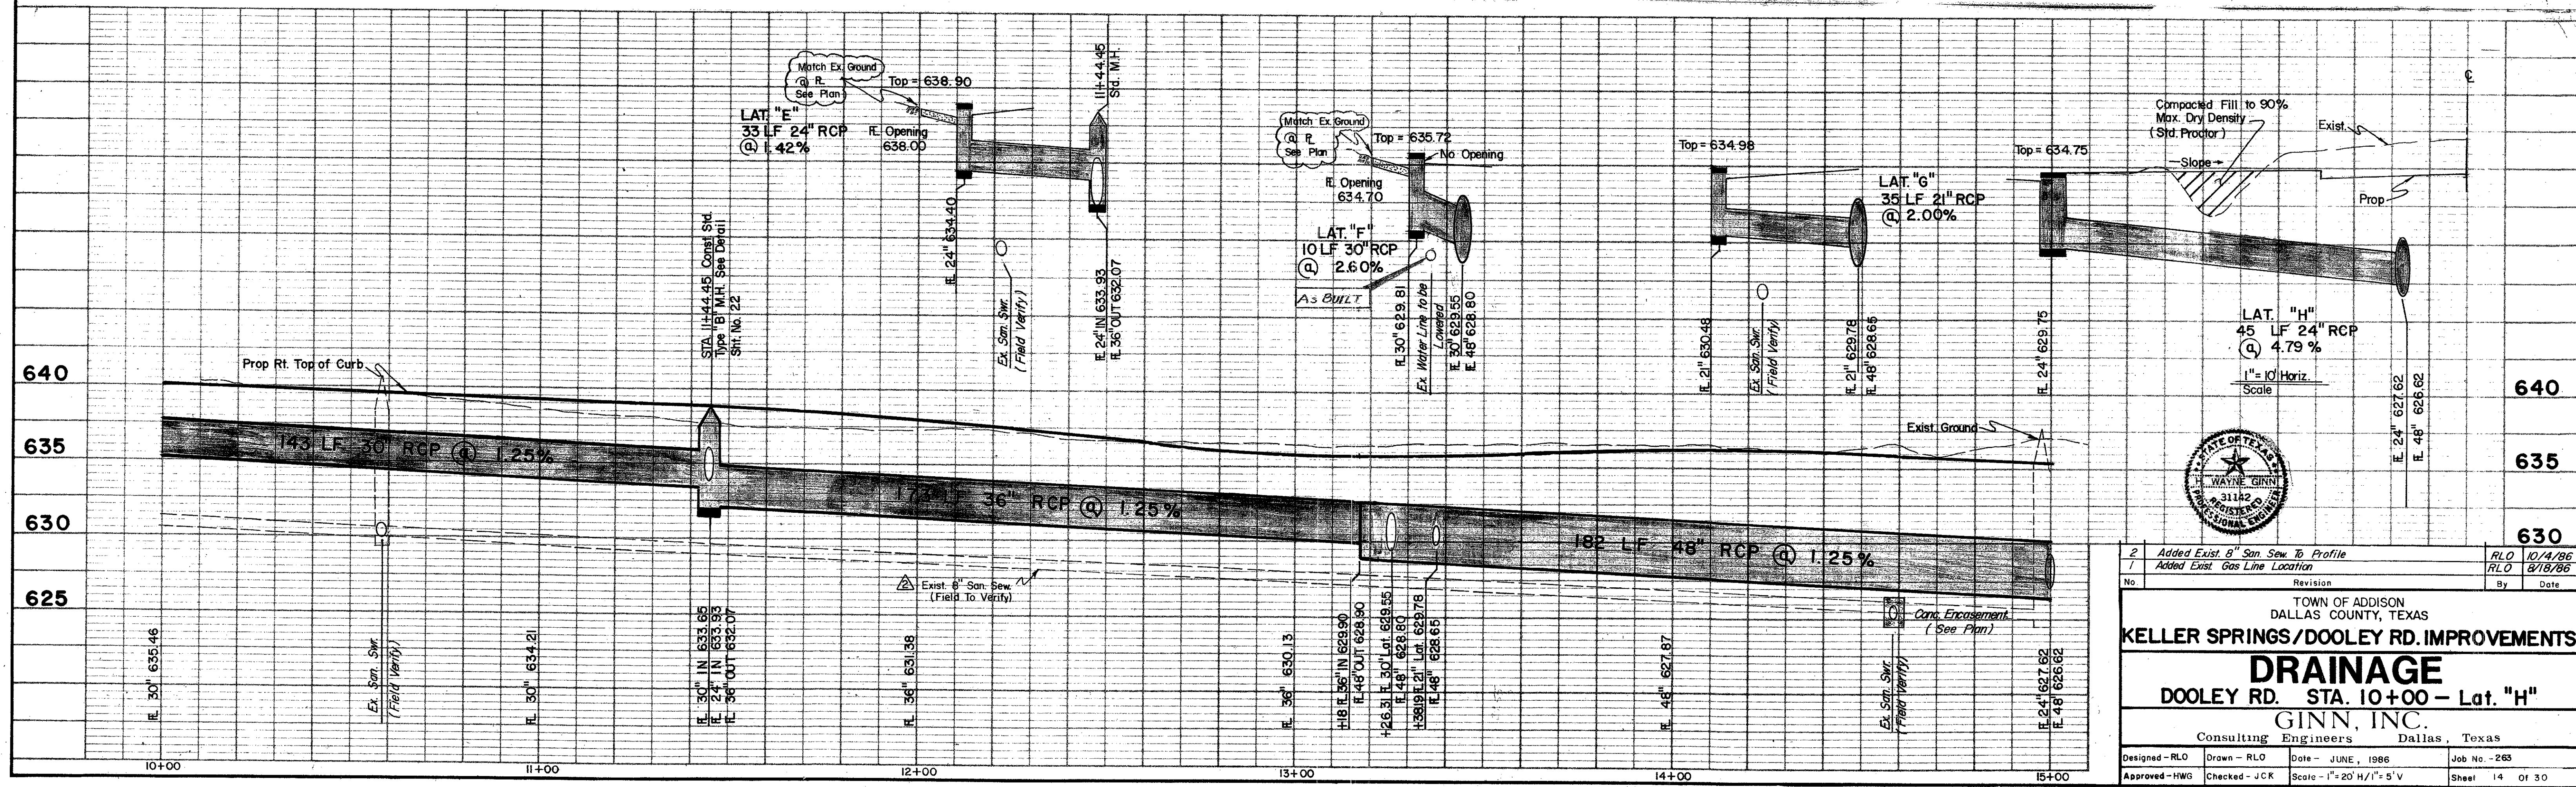

2	Added Exist. 8" San Sew. To Profile	RLO	10/A/86
1	Added Exist. Gas Line Location	RLO	8/18/86
No.	Revision	By	Date
TOWN OF ADDISON DALLAS COUNTY, TEXAS			
KELLER SPRINGS/DOOLEY RD. IMPROVEMENTS			
DRAINAGE			
DOOLEY RD. STA. 10+00 - Lat. "H"			
GINN, INC.			
Consulting Engineers Dallas, Texas			
Designed - RLO	Drawn - RLO	Date - JUNE, 1986	Job No. - 265
Approved - HWG	Checked - JCK	Scale - 1" = 20' H / 1" = 5' V	Sheet 14 of 30