
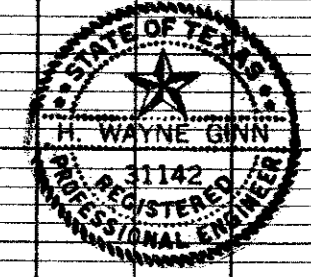


NOTE:  
ALL DRIVEWAY RETURNS ARE  
MIN. 3.5' BEHIND R/W

TBM - "□" cut on S.W. top curb, corner of parking lot,  
4125 Keller Springs Road ± 60' west of Midway Place sign.  
Elevation 634.62

1-06-0022 C.B. Institutional Fund VII

1-06-0035 JWJ Investments

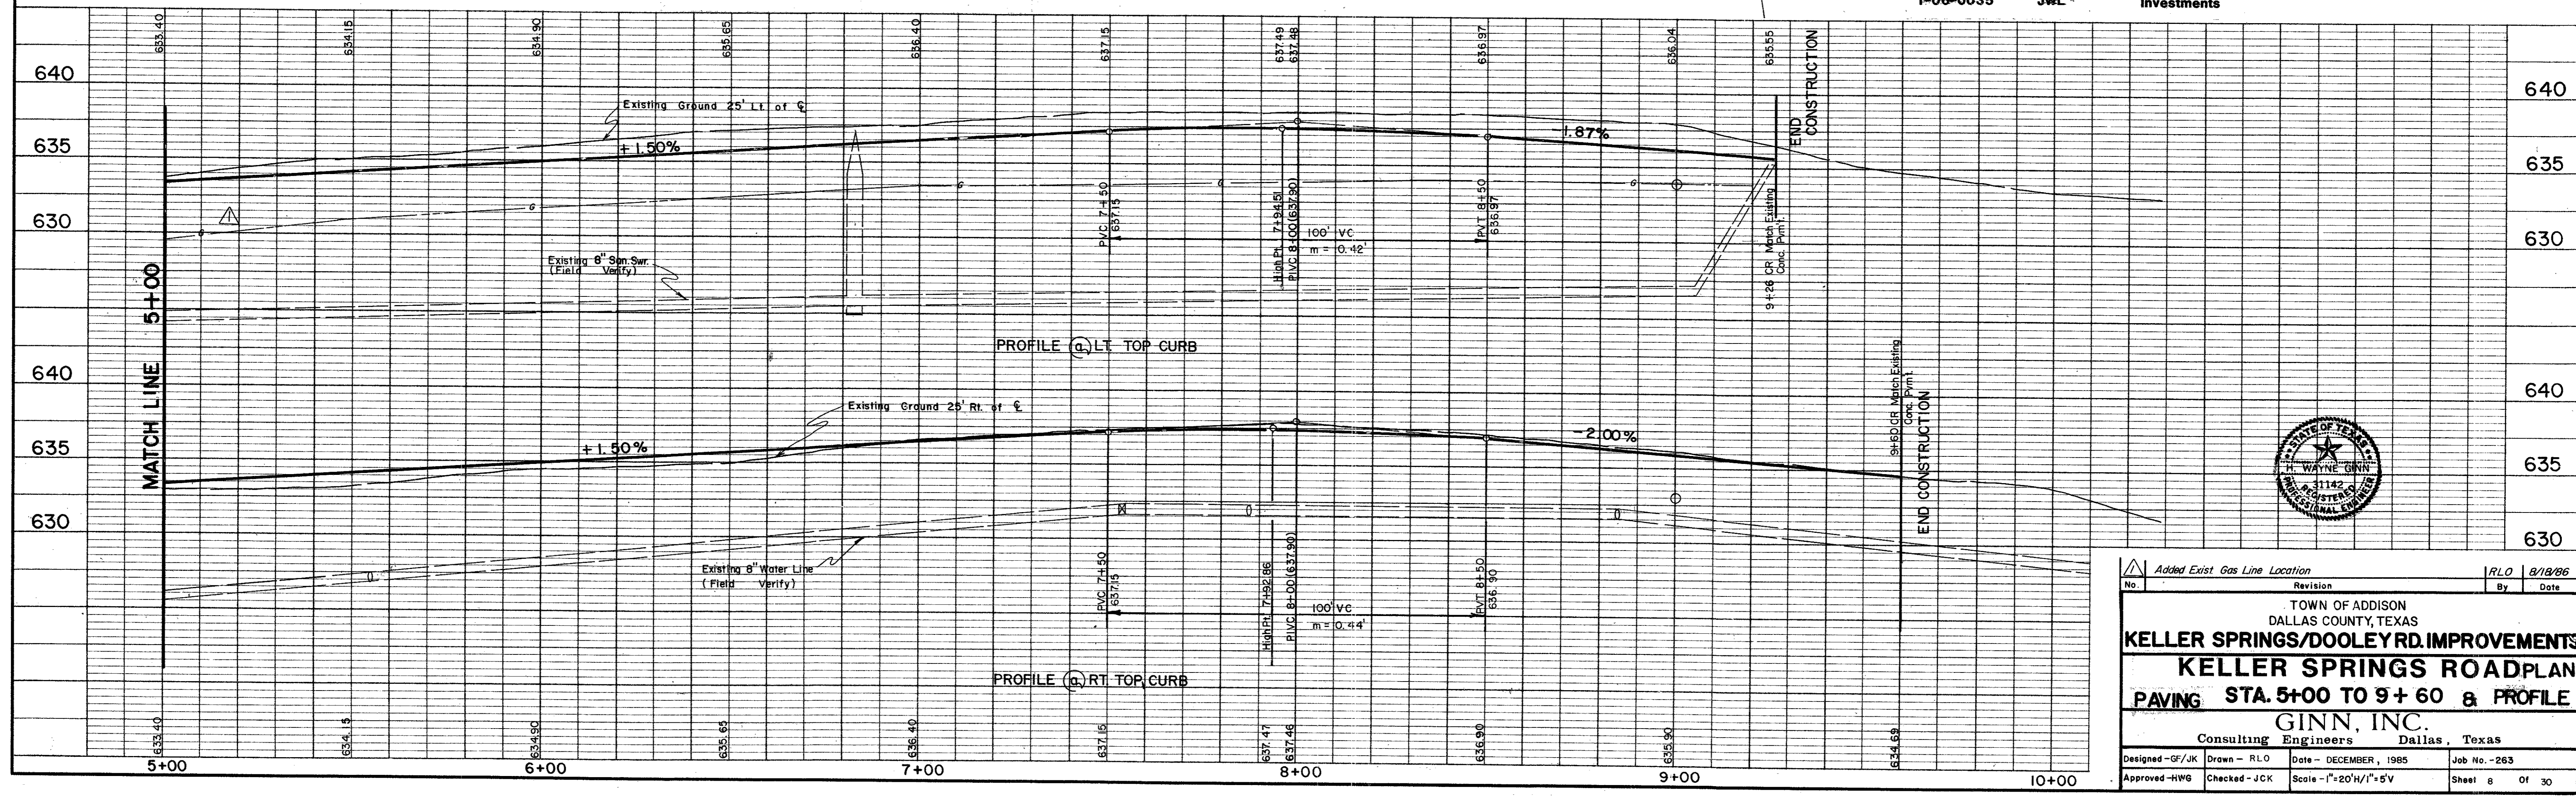

Added Exist. Gas Line Location No. _____ Revision _____ By _____ Date _____		RLO	8/19/86
TOWN OF ADDISON DALLAS COUNTY, TEXAS <b>KELLER SPRINGS/DOOLEY RD. IMPROVEMENTS</b> <b>KELLER SPRINGS ROAD PLAN</b> PAVING STA. 5+00 TO 9+60 & PROFILE GINN, INC. Consulting Engineers Dallas, Texas			
Designed - GF/JK	Drawn - RLO	Date - DECEMBER, 1985	Job No. - 263
Approved - HWG	Checked - JCK	Scale - 1"=20'H/1"=5'V	Sheet 8 OF 30