



Midway Park North

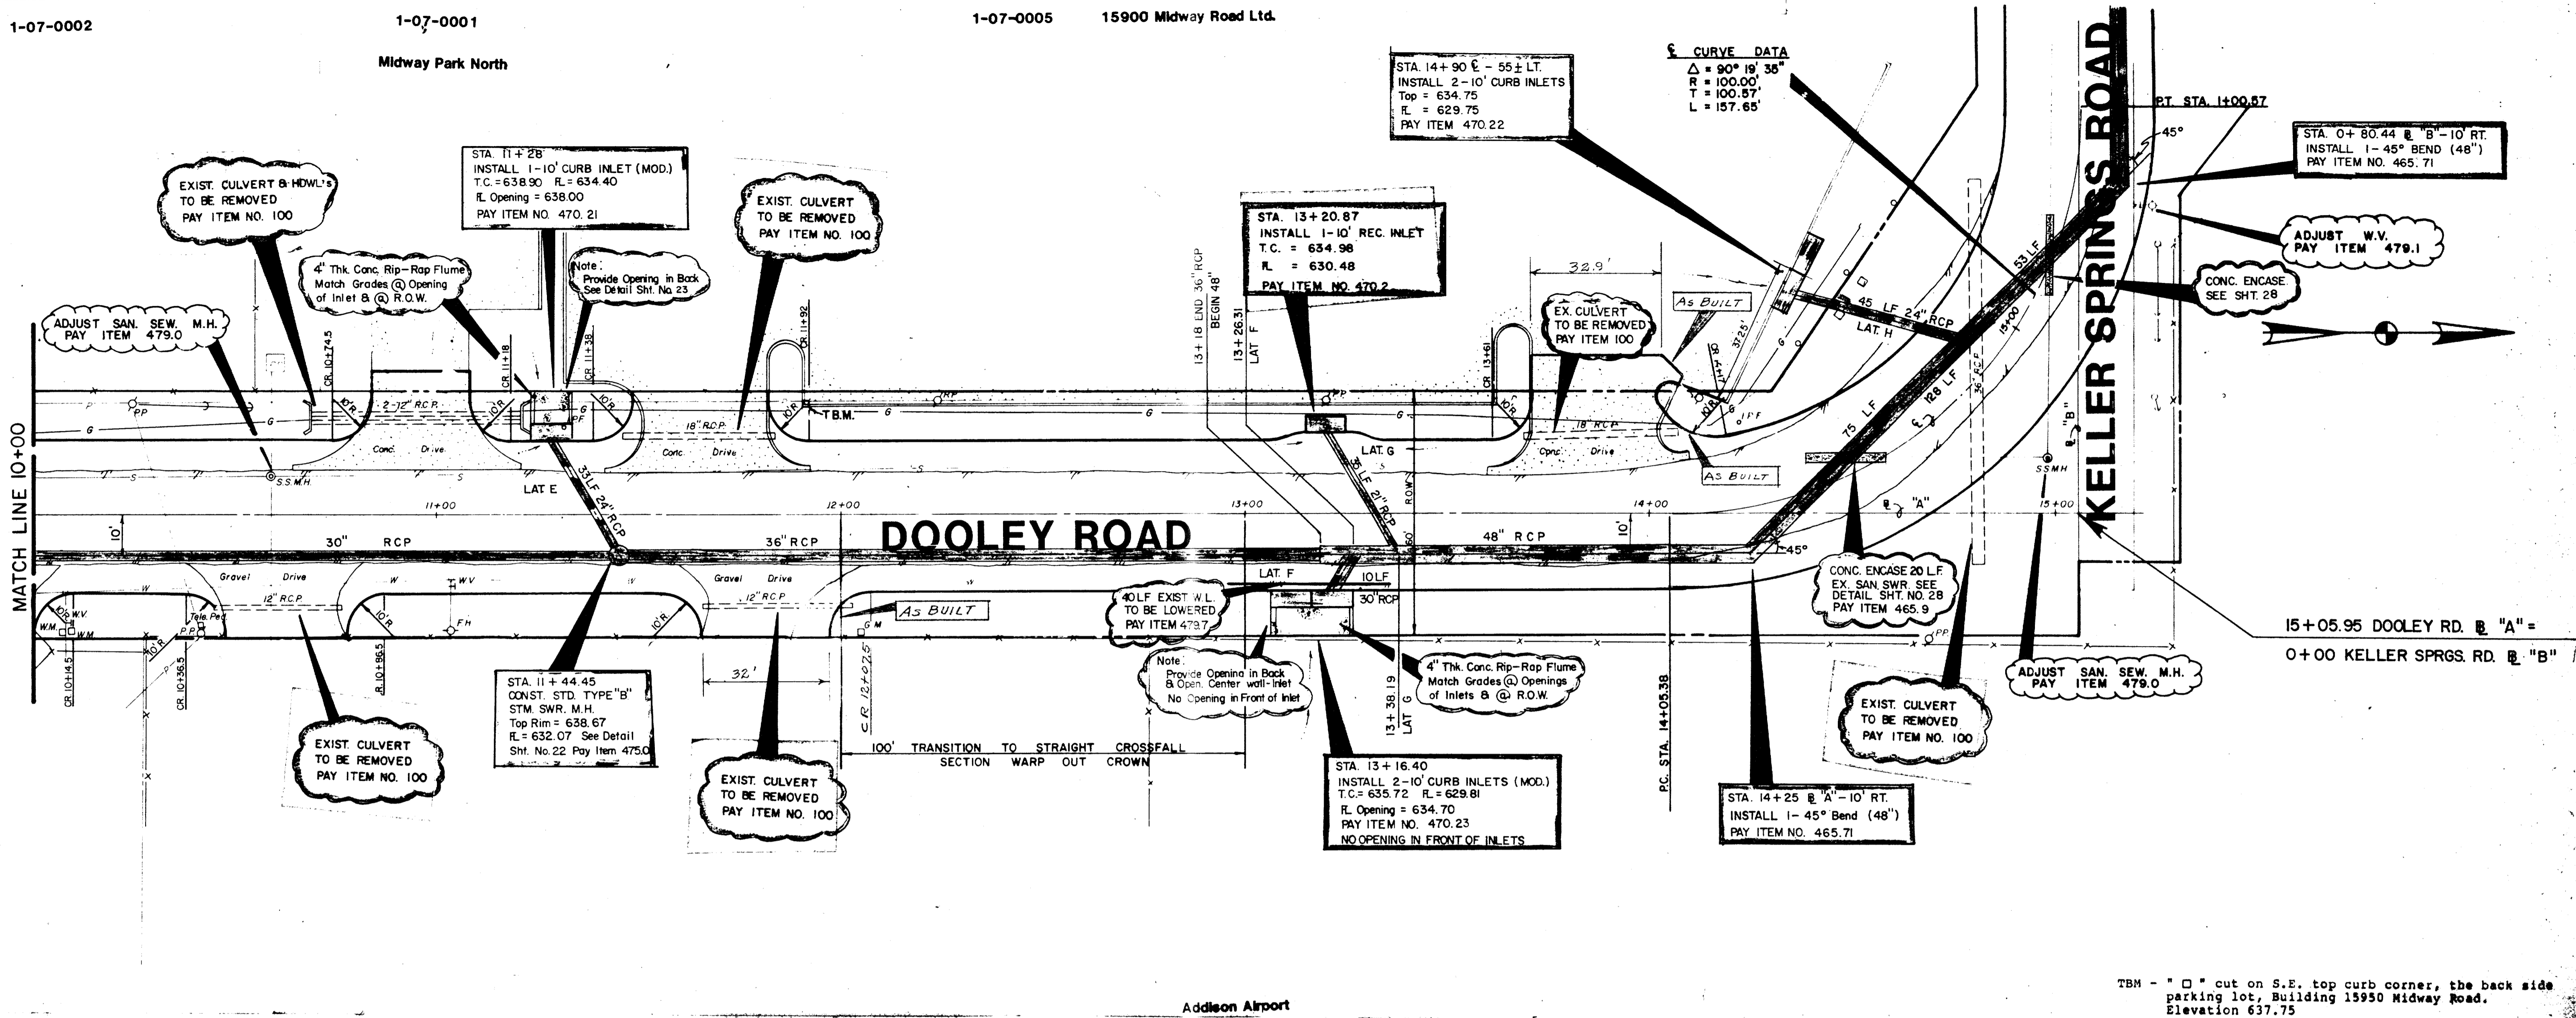

TBM - "□" cut on S.E. top curb corner, the back side parking lot, Building 15950 Midway Road. Elevation 637.75

Addison Airport

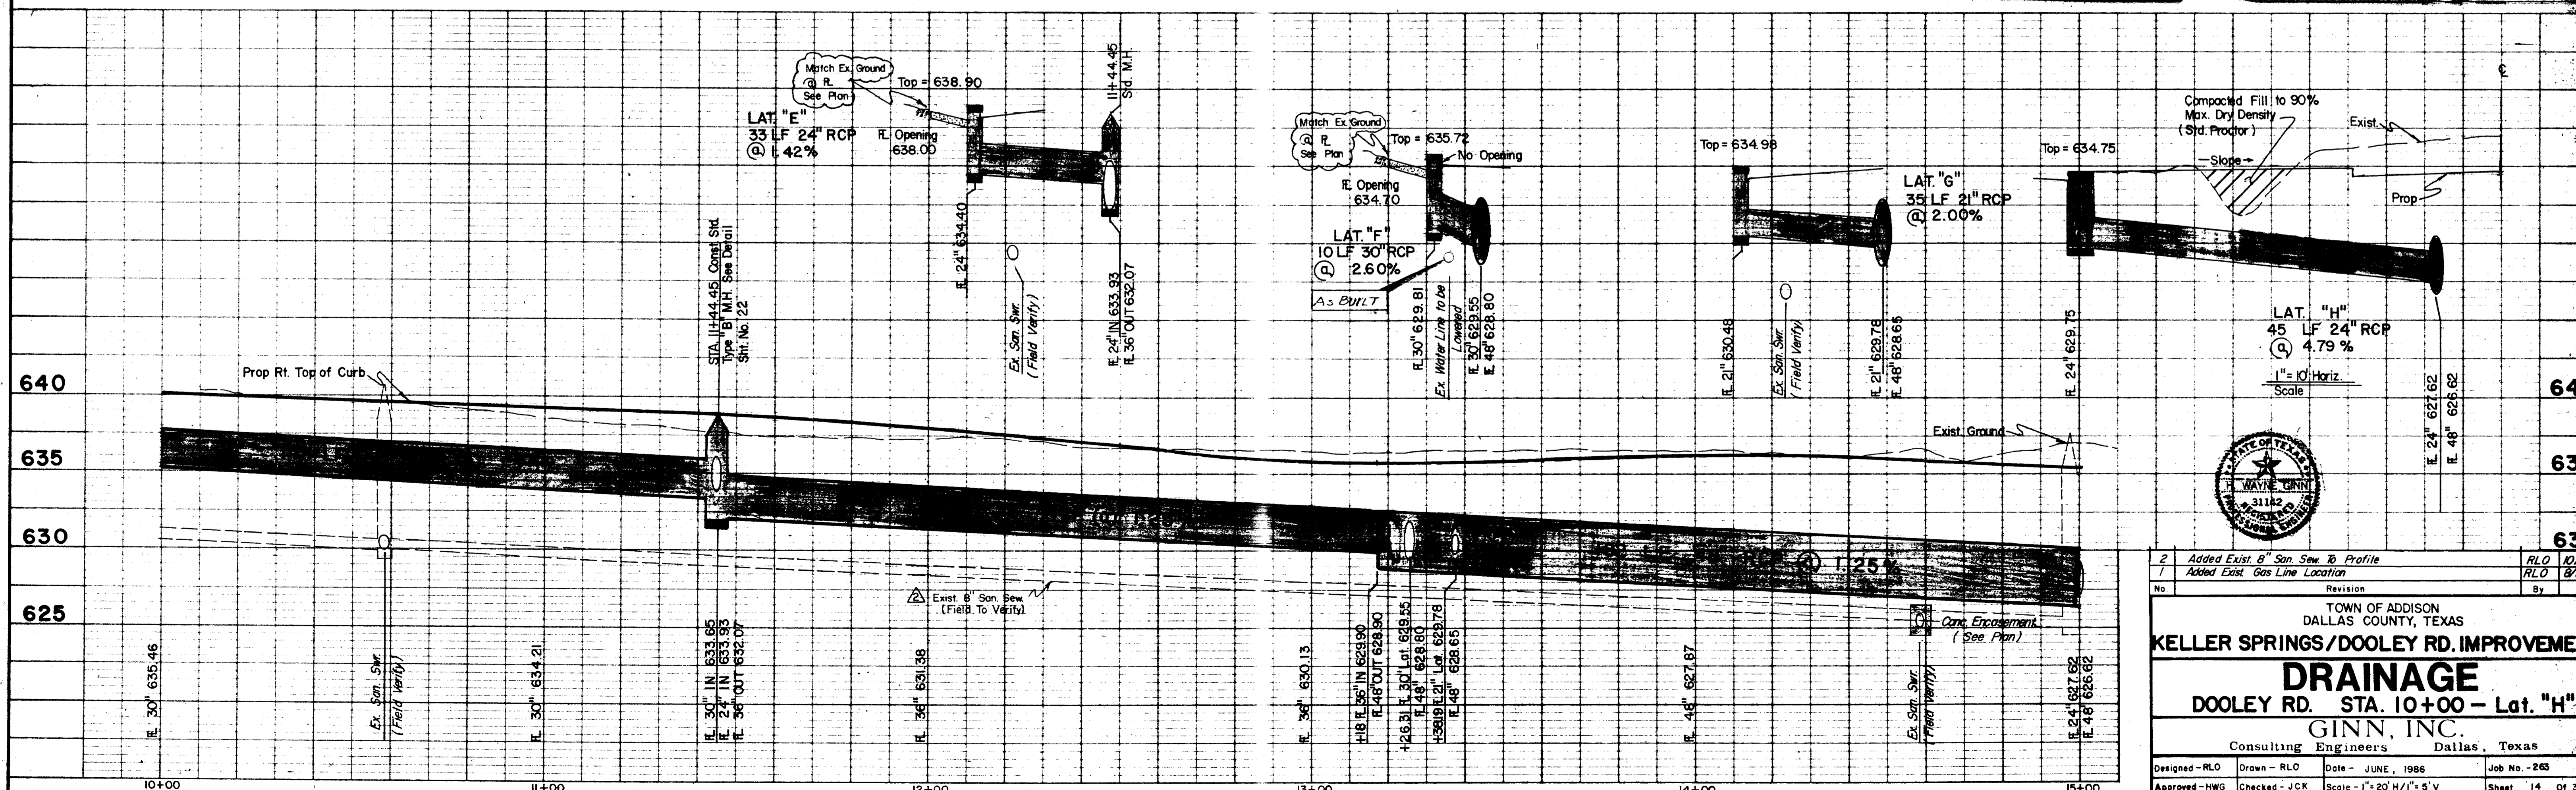

2 Added Exist. 8" San Sew. B Profile		RLO	10/14/96
1 Added Exist. Gas Line Location		RLO	9/18/96
No.	Revision	By	Date
TOWN OF ADDISON DALLAS COUNTY, TEXAS			
<b>KELLER SPRINGS/DOOLEY RD. IMPROVEMENTS</b>			
<b>DRAINAGE</b>			
DOOLEY RD. STA. 10+00 - Lat. "H"			
GINN, INC.			
Consulting Engineers Dallas, Texas			
Designed - RLO	Drawn - RLO	Date - JUNE, 1996	Job No. - 263
Approved - HWG	Checked - JCK	Scale - 1"=20' H/1"=5' V	Sheet 14 OF 30